



E 5264  
 OUTLINE MIDSHIP SECTION  
 PROPOSED SELF DISCHARGING COLLIER  
 DIMENSIONS - 252' 0" B.F. x 42' 2" MHD x 25' 0" MHD  
 SCALE 1/2" = ONE FOOT  
 TO CLASS B.S.\* GREAT LAKES AND RIVER ST LAWRENCE  
 MINIMUM SCANTLINGS REQUIRED  
 MAXIMUM DRAFT 16' 0" FW

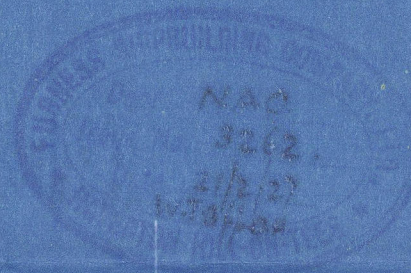

22 FEB 1927

Approved *[Signature]*  
 S. L. 25-1-27

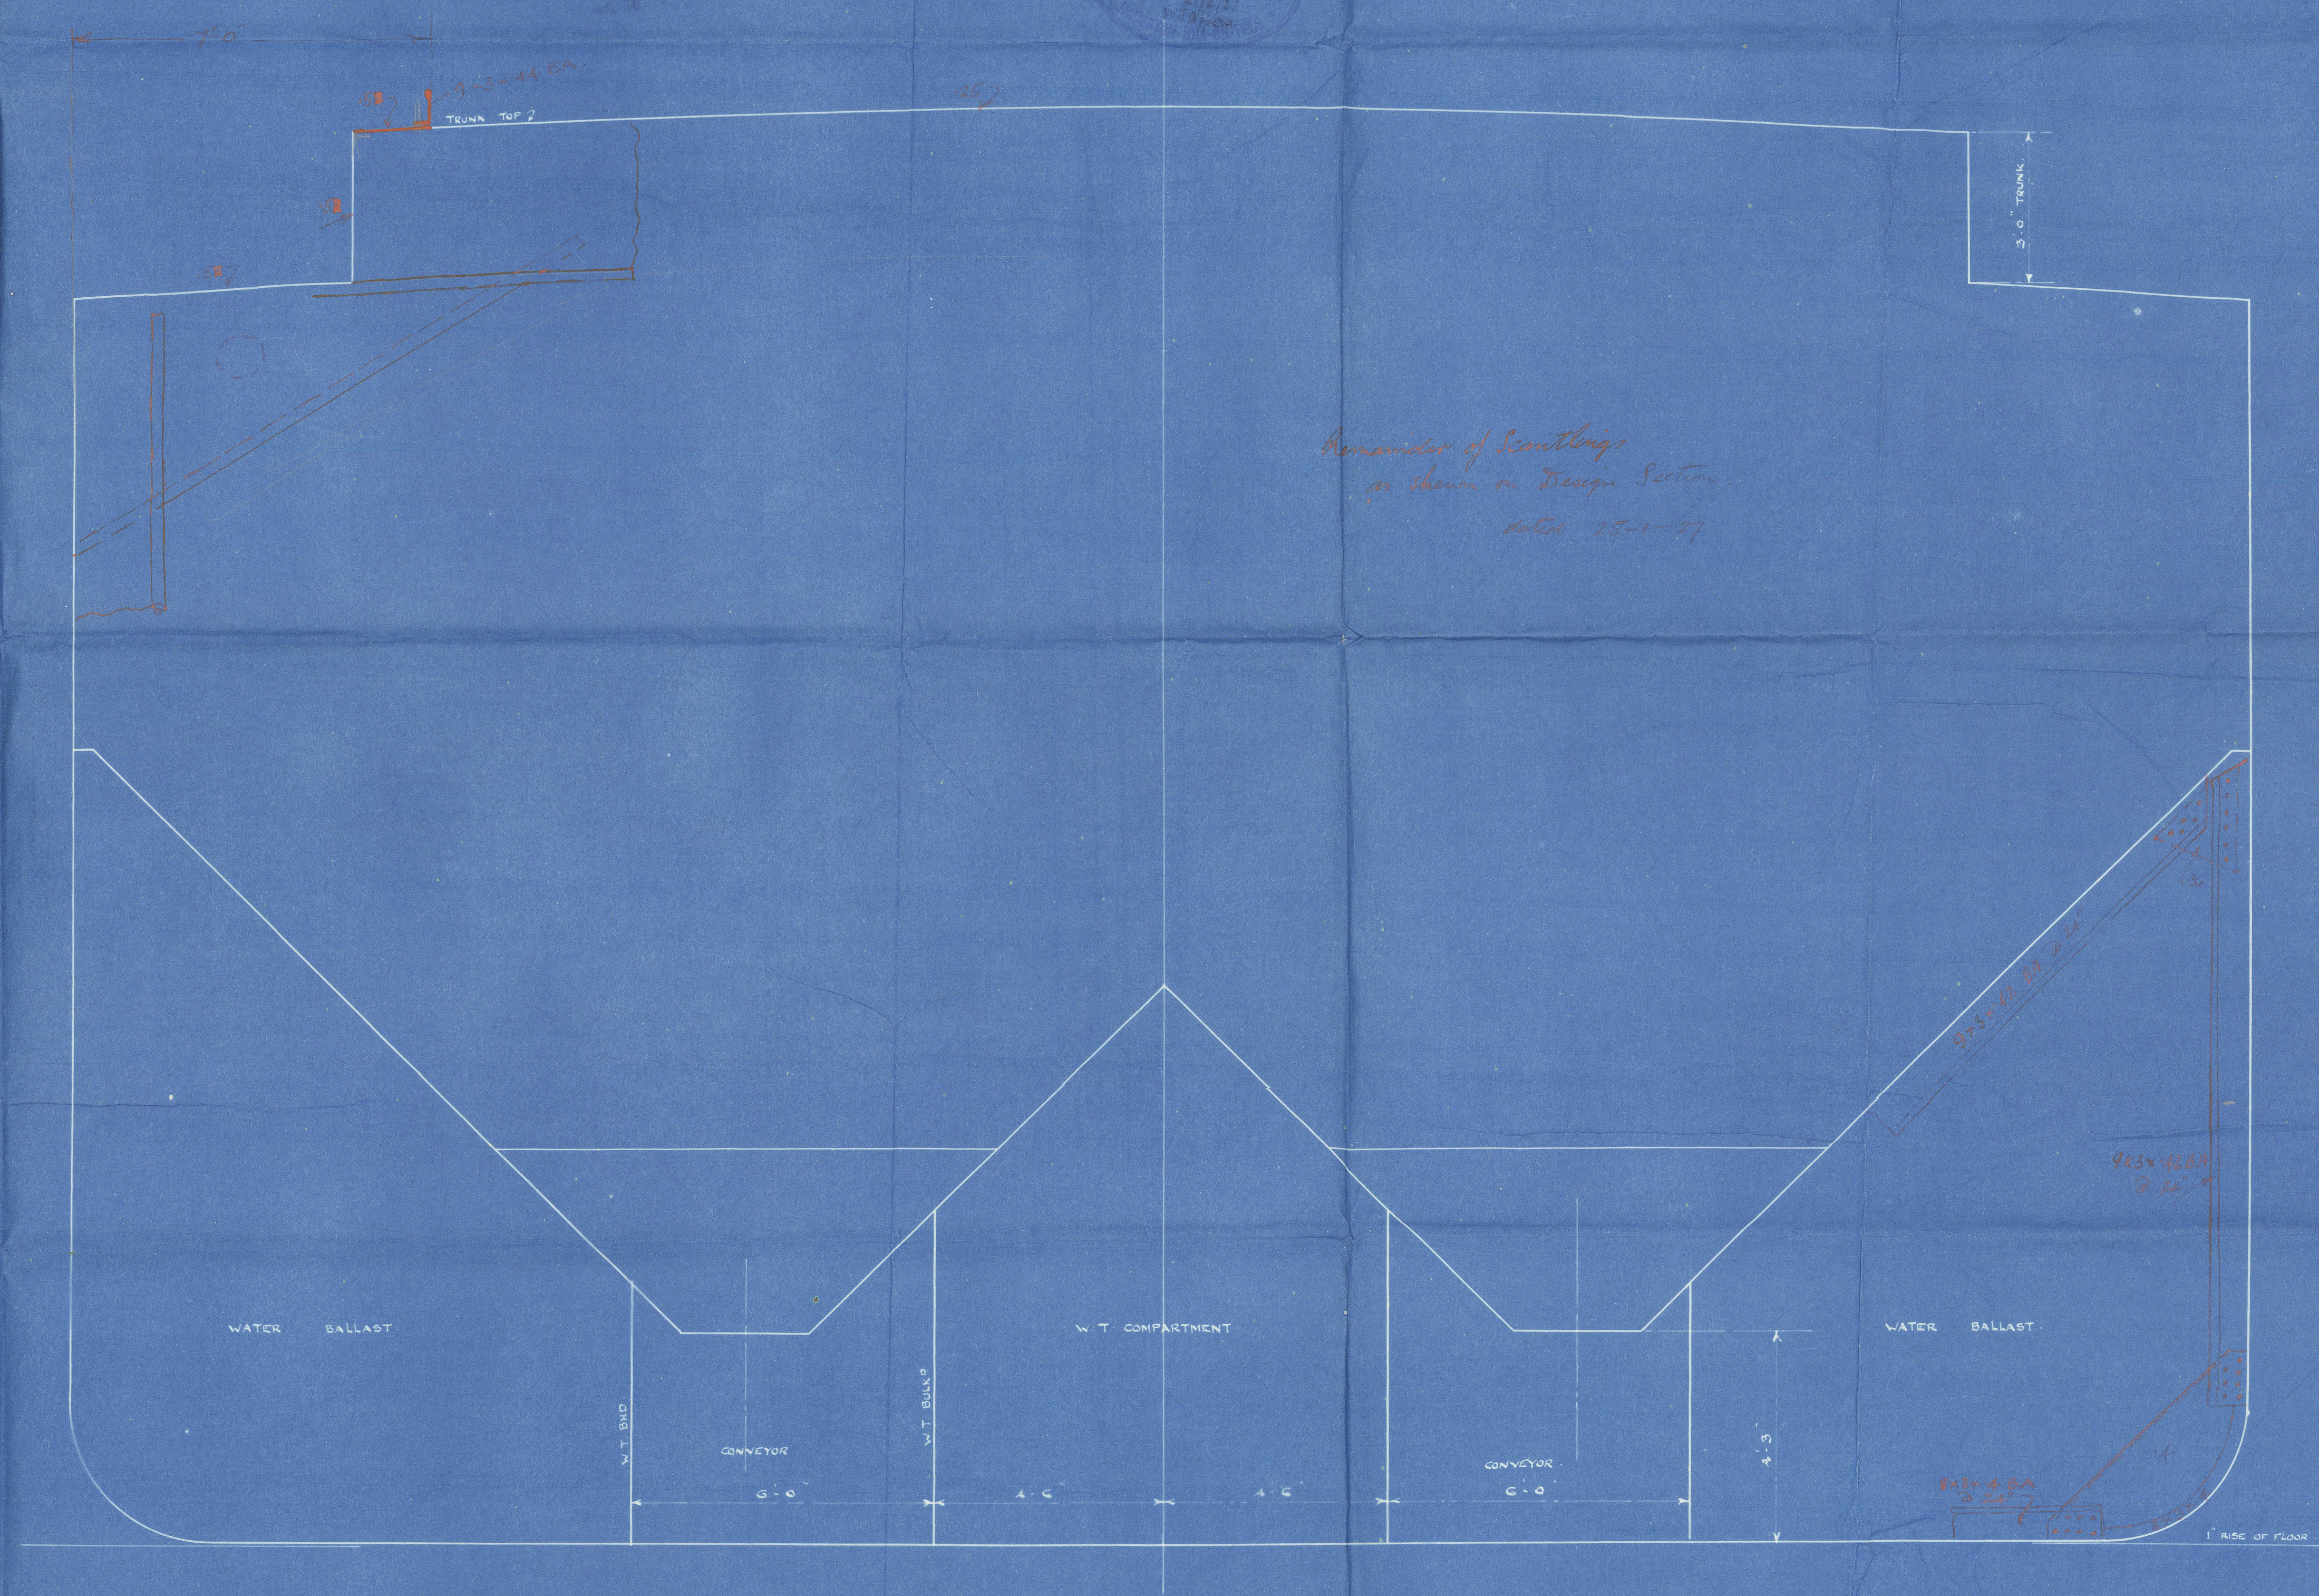

Prel. Midship Section

Furness S.B. Co. Prop. Collier.

253'-0" x 43'-6" x 25'-0"

23-2-27

"Coalfax"



© 2020

Lloyd's Register  
Foundation

004394-004404-0052