

22 JAN 1927
LLOYD'S REGISTER
MARITIME
LONDON

E 5364

PROPOSED SELF DISCHARGING COLLIER


DIMENSIONS: 253'-0" BP x 43'-2" MID x 24'-6" MID

SCALE 1/8" = 1'-0"


TO CLASS B.S. GREAT LAKES AND RIVER ST. LAWRENCE

LOAD DRAFT 14'-0" F.W. IN CANALS 16'-0" F.W. MAXIMUM

MINIMUM SCANTLINGS REQUIRED


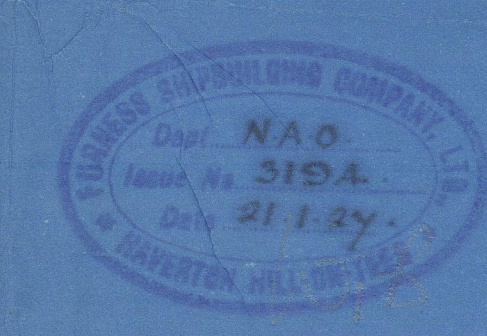


TRUNK FORWARD TO BE INCORPORATED
IN STRUCTURE FOR DISCHARGING JIB

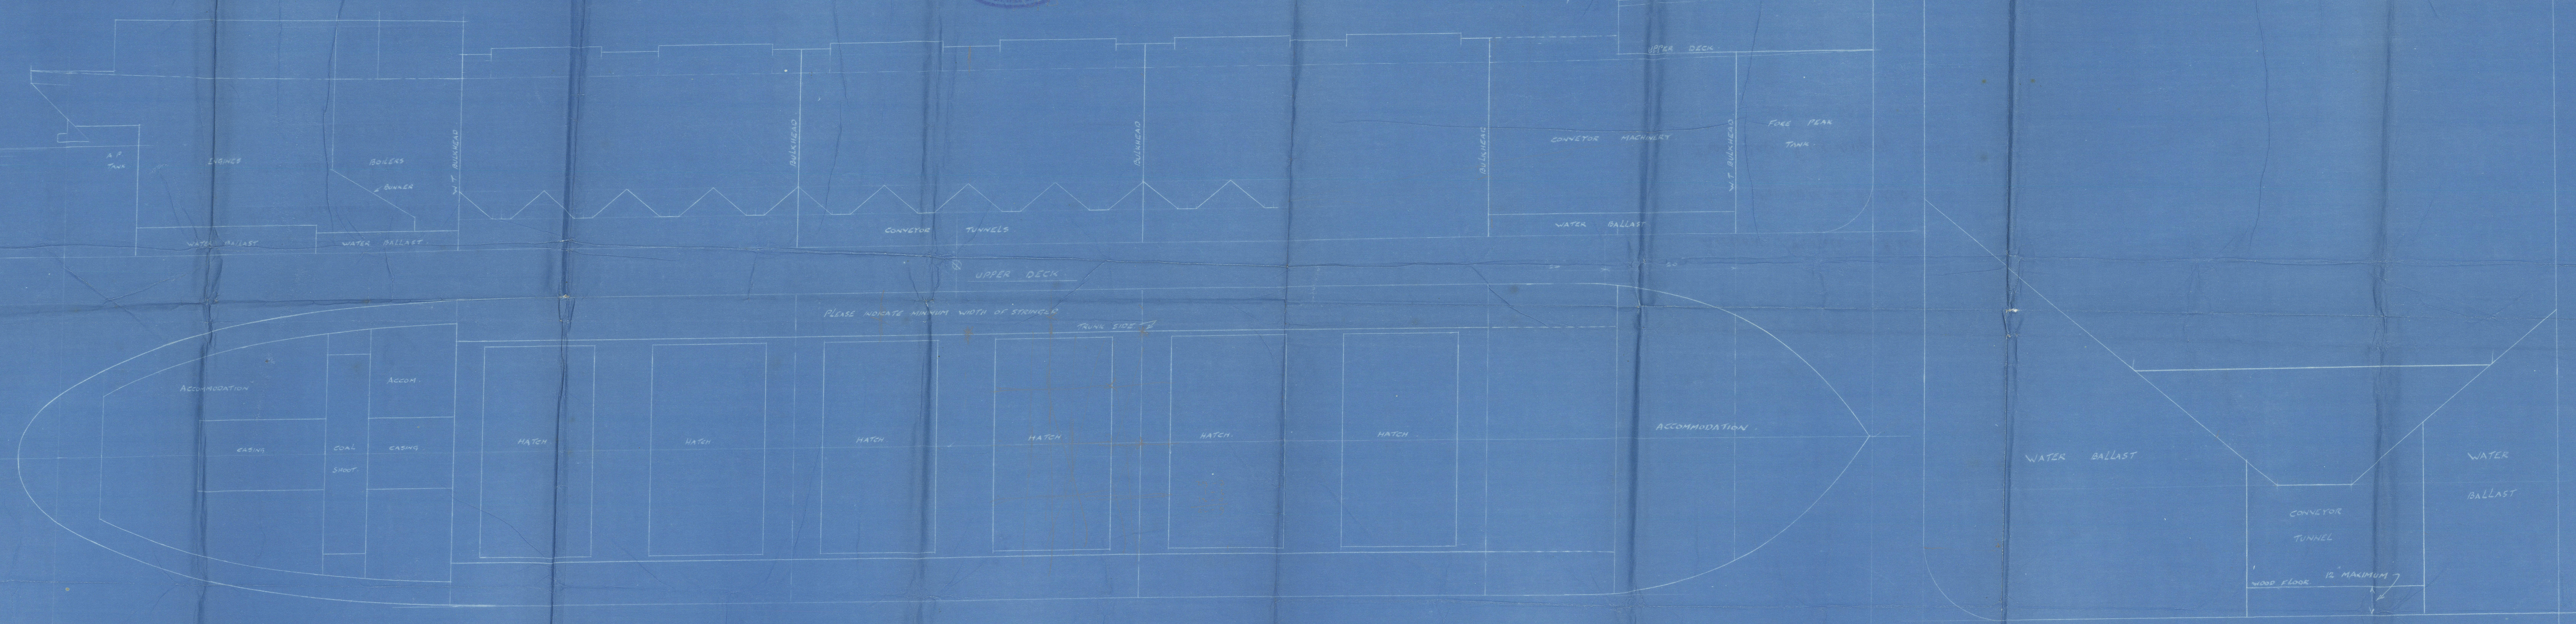

PLEASE INDICATE MINIMUM WIDTH OF STRENGTH

HALF PLAN OF BOTTOM OF HOLDS

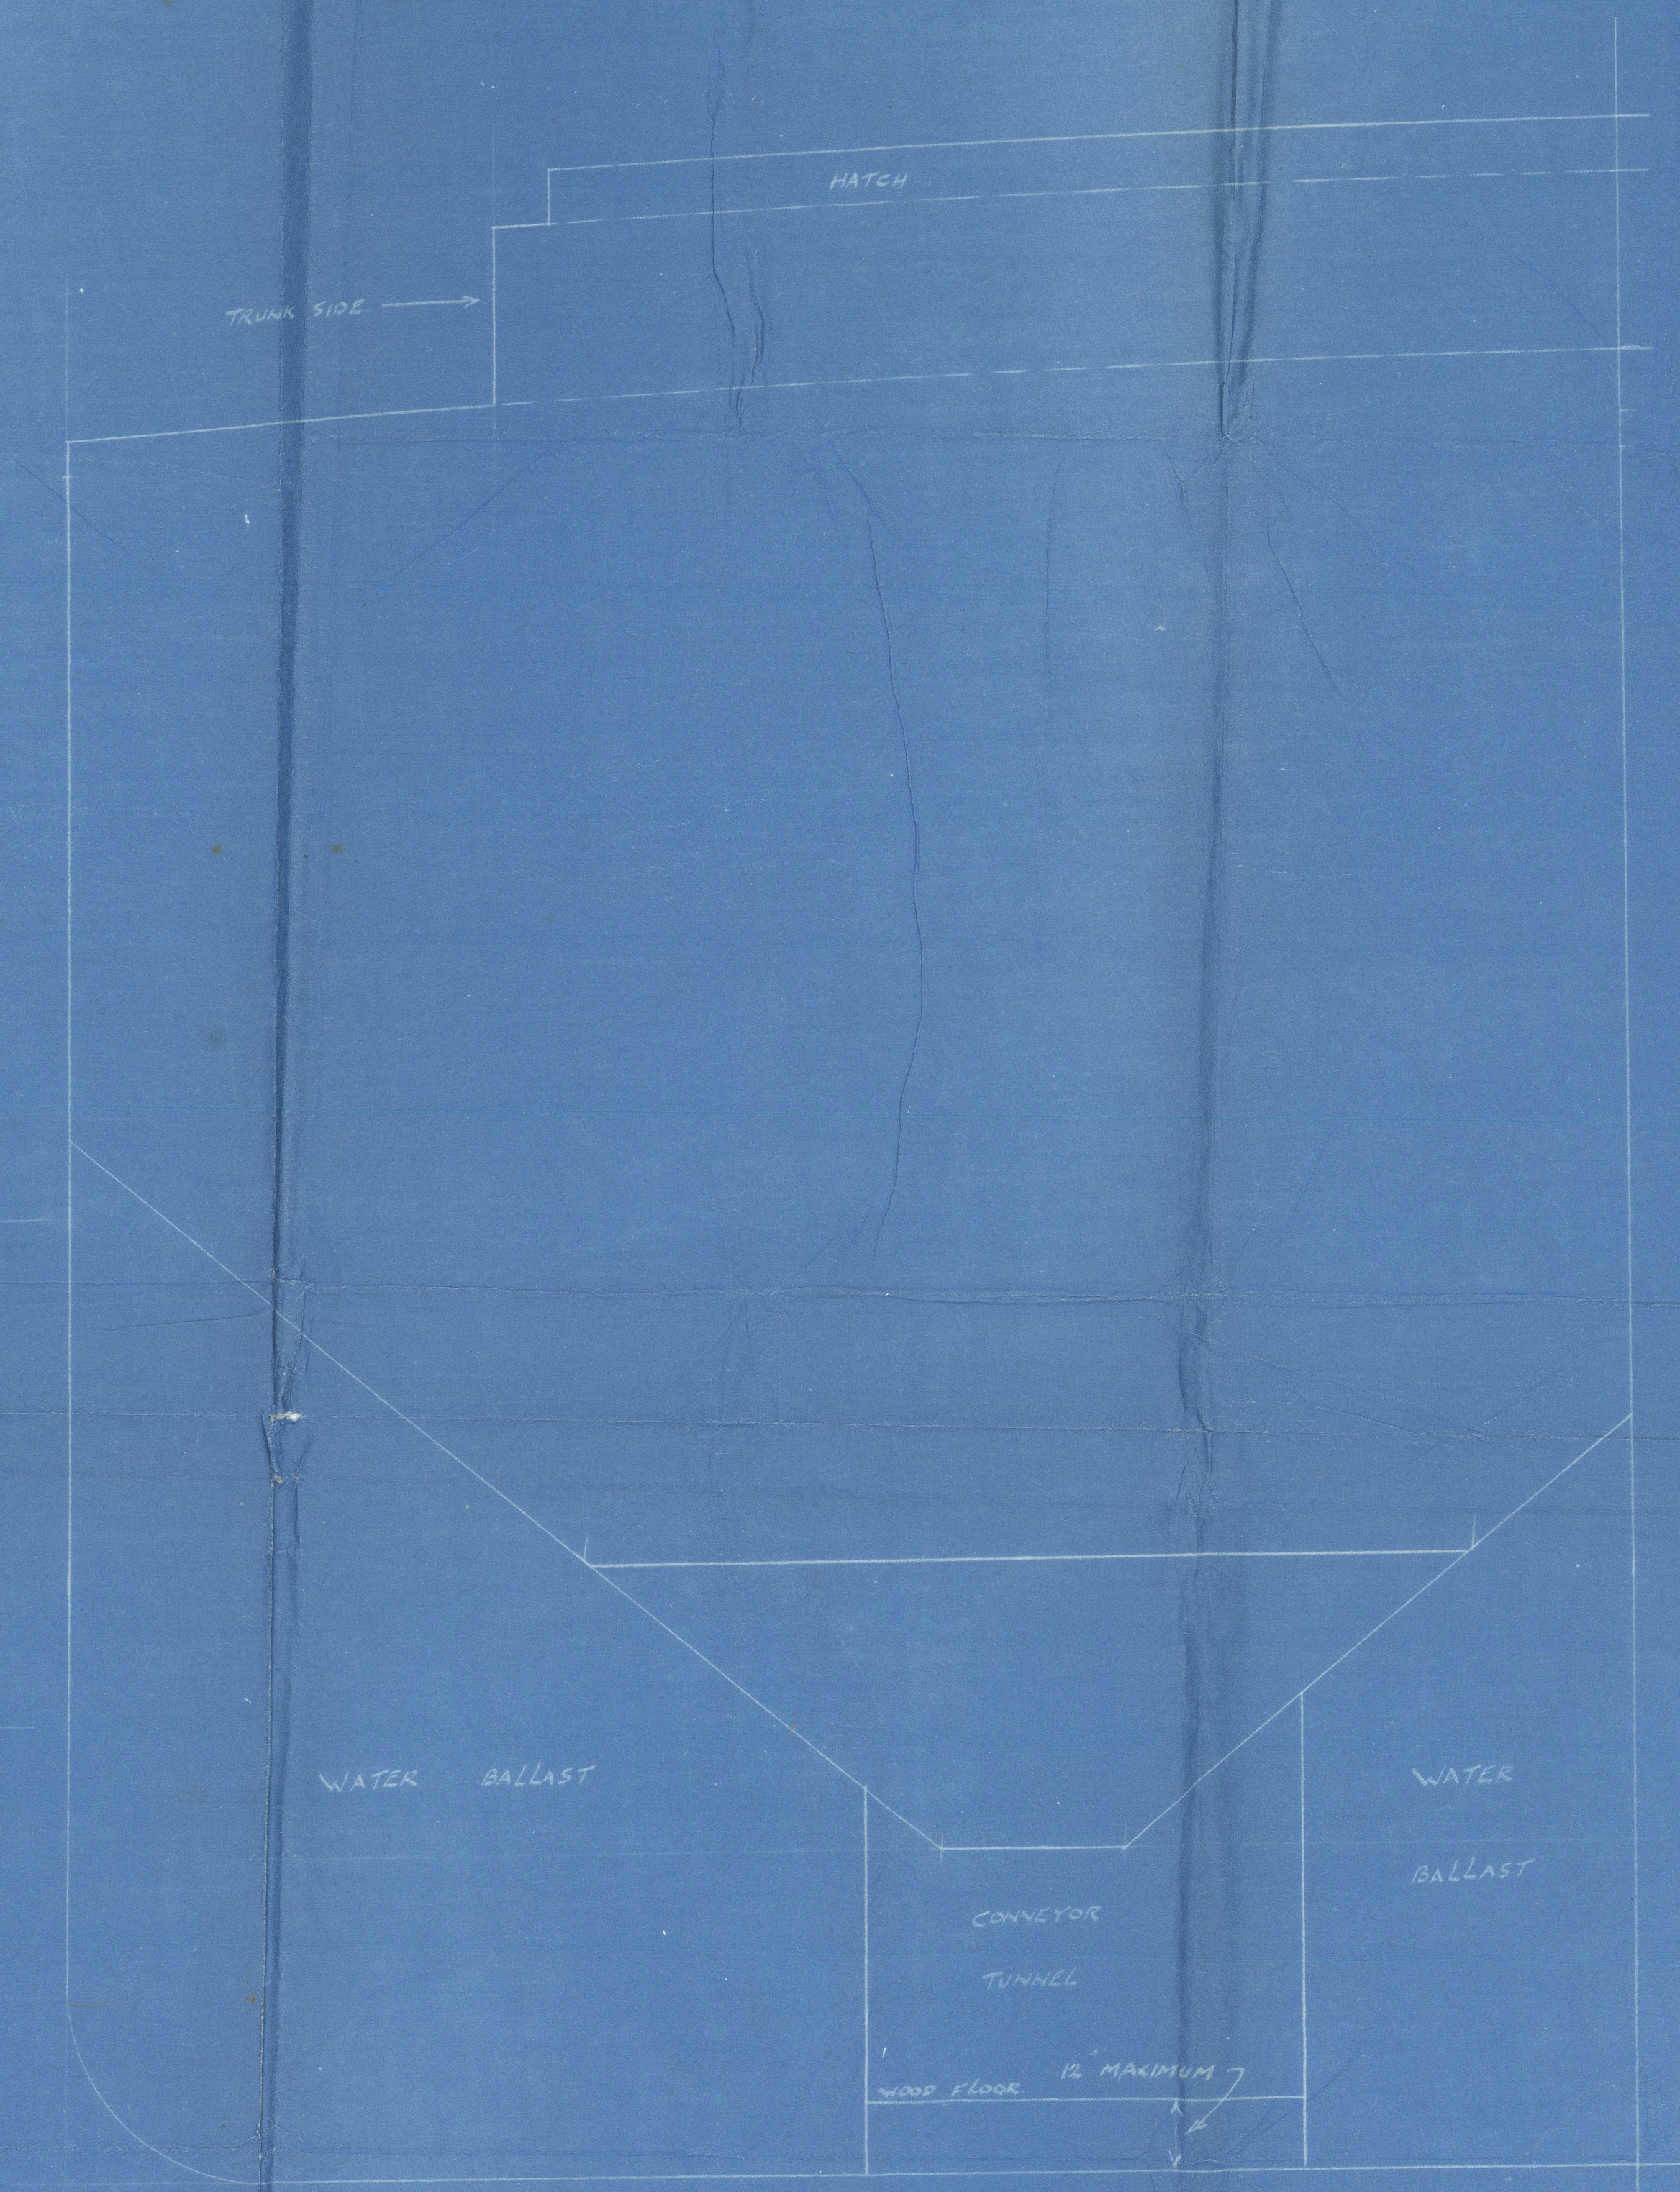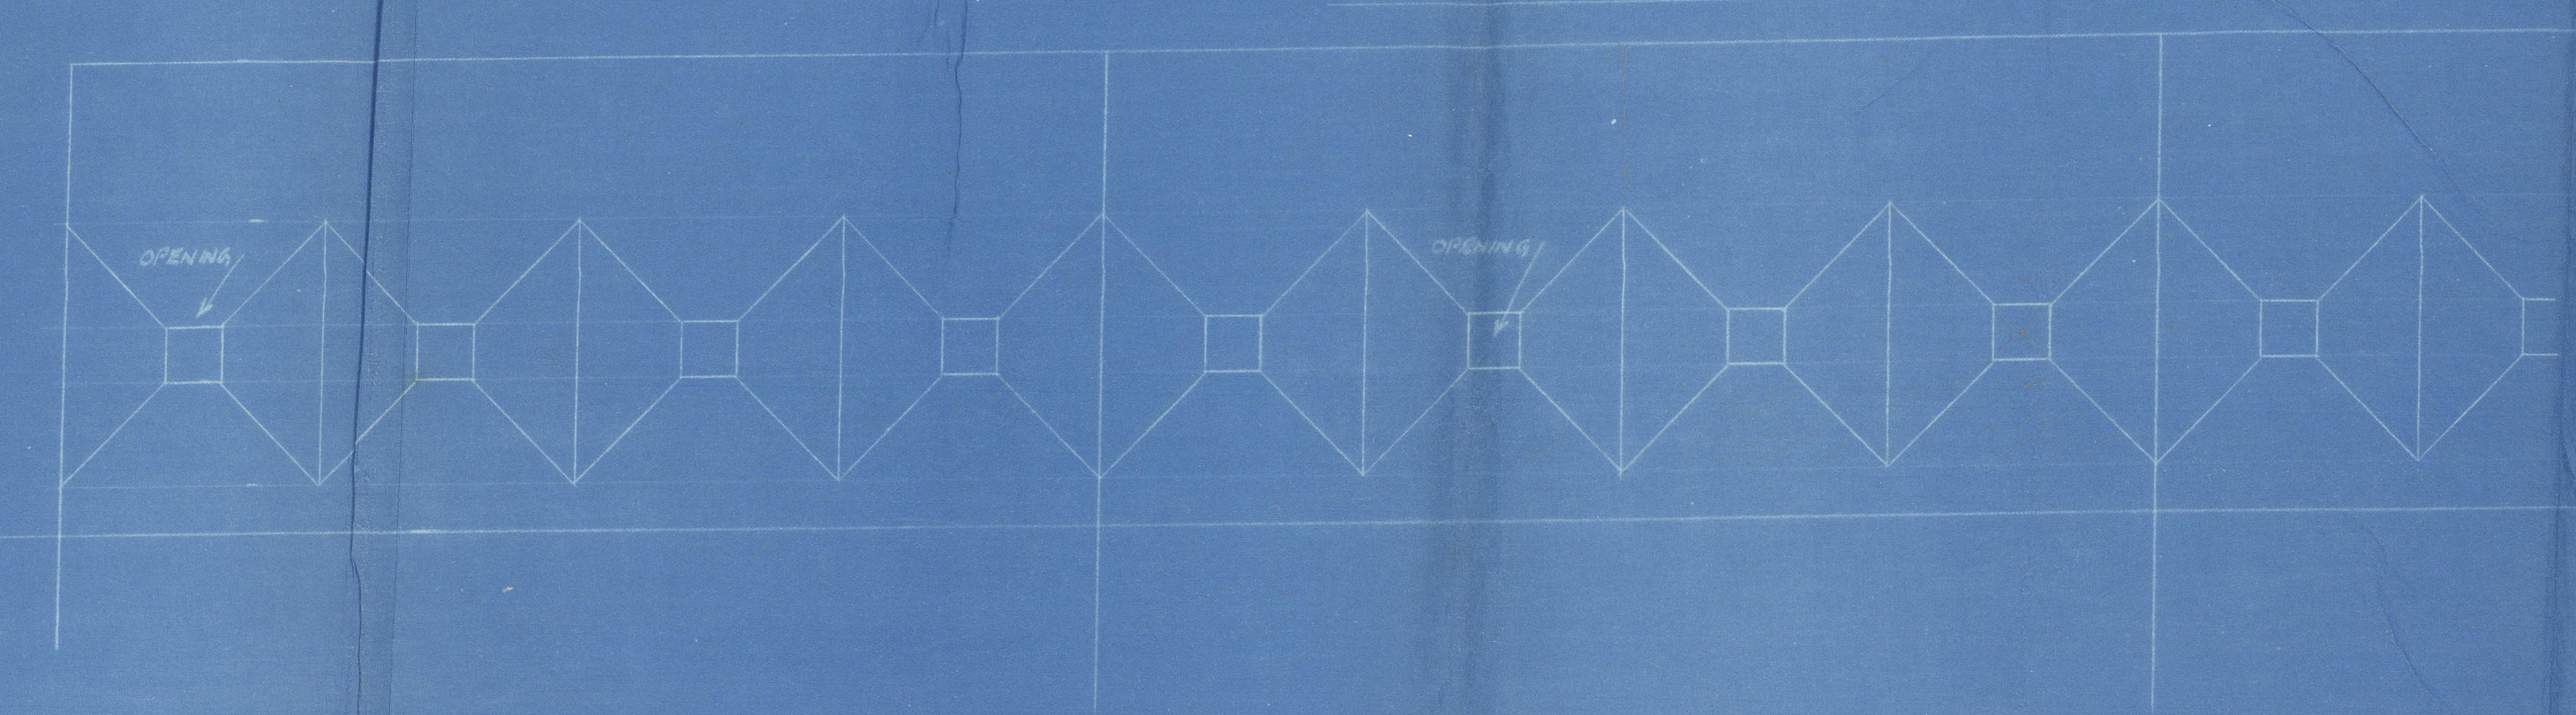

HALF SECTION
SCALE 1/2" = 1'-0"

N 924

Revisions

Prel. Section, Profile & Deck
Hurness S.B. Co. Prop. Collier.

253'-0" x 43'-2" x 24'-6"

22-1-27

"Coalfax"

004394- 004404- 0053



© 2020

Lloyd's Register
Foundation