

Lloyd's Register of Shipping.



No. 18343.

Ship's Name S/s "EMPIRE CENTAUR" (Wm Gray & Co. 1134) Official No. 168946.

Memorandum of alterations reported since ship was surveyed for assignment of Load Lines
in August 1942

alterations

- 1/ The following alterations have been made to suit additional accommodation for gunners in No. 6 'tween deck.
- 2/ Additional sidelights with efficient deadlights have been fitted in the shell plating (P&S) in way of No. 6 'tween deck.
The sill of the lowest sidelight is 34'-0" above the base.
- 3/ Two additional brass non-return valves now fitted in starboard side of shell from soil and shower bath discharges. Valves geared to freeboard deck.
- 4/ Wood covers 2½" thick fitted to Nos. 1 & 6 'tween deck hatchways i.e. all 'tween deck hatchways are now fitted with wood covers.
- 5/ One small escape hatch at fore end of No 6 'tween deck (stbd) has been removed and deck plated over.
- 6/ Four additional 8" vents have been fitted on freeboard deck in way of No. 6 hatch with coamings 36" x 30"
- 7/ Two additional 6" gooseneck vents have been fitted on freeboard deck at stbd. side in way of No 6 hatch. Vents 18" high.
- 8/ All additional vents are fitted with closing appliances.

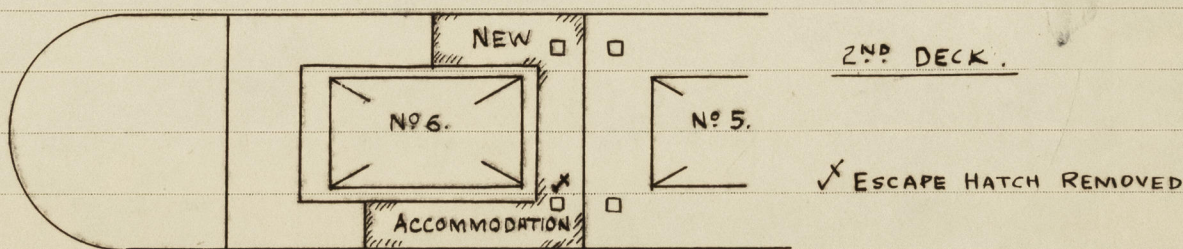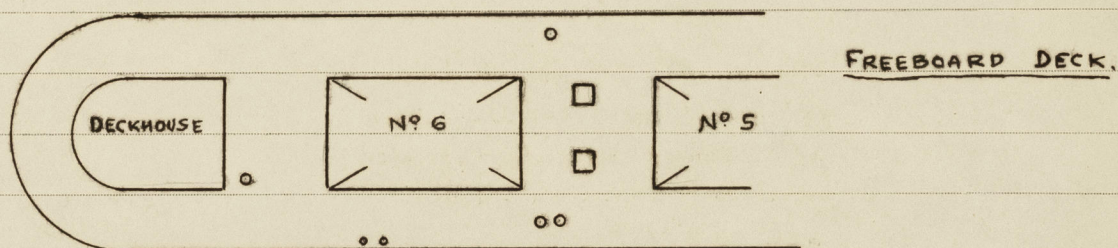

Noted
S. O. B.

15 OCT 1942

W. Gray
6.10.42



© 2020

Lloyd's Register
Foundation