

18. APR. 1966

Ship's Name SS/~~MSK~~ "SAFINA-E-JAMHOORIYAT". Gross tons

LR530490  
Port Antwerp Rpt. No. 42037

Is there a rpt. 8? No. of visits First date Last date  
Interim Cert. issued & copy herewith? Damage rpt. issued & copy herewith? Last rpt. (H.Q. only)

Date of completing rpt. Surveyed at, if different from Port above

Is a rpt. 9A attached? Yes. MN Nature of survey Machinery & boiler repairs.

Survey fees Damage fee Expenses

S.A. fee

DOCKING

Propeller Sea connections Oil gland

Fastenings Wear down of stern bush

Has screw/tube shaft been drawn? Date of examn.

Has shaft been changed? Has shaft now fitted been previously used?

Has shaft now examined/fitted a continuous liner? Approved oil gland?

BOILERS OPENED UP AND EXAMINED. (Identify by position and state latest date of internal examination of each boiler.)

AUXILIARY, DONKEY OR PRESS (State if oil fired—OF or exhaust gas—EG) MAIN

Air heaters

Superheaters

Safety valves

Mountings, doors and fastenings

Safety valves { Sat adjusted to { Spt

Boiler securing arrangements

Main economisers

Steam heated steam generators

Forced circulating pumps

Have saturated steam pipes in cylindrical boiler smoke boxes been examined as required by the Rules?

Exhaust gas heated economisers

Steam generator safety valves adjusted to

Funnel

Were oil burning system & remote controls examined in accordance with rules?

I recommend that the machinery of this ship remain as classed with/without fresh record of

See Rpt. 9A.

(Where conditions of class are recommended to be retained, imposed, amended or deleted, particulars must be stated above and on the interim certificate.)


Date of Committee

Minute

M. JOOS, Surveyor to Lloyd's Register of Shipping

TUESDAY 26 APR 1966

See Rpt 9A

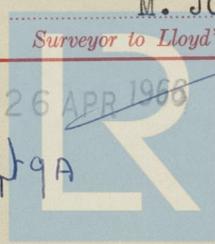

Lloyd's Register Foundation

ALSO FOR
SPL FOR
TRO
SRL
POSTING
HEADER
CERT

004405-004410-0191

At part or complete Special Surveys those items which are not applicable to the ship are to be cancelled; this need not be done when the machinery is on a continuous survey basis. When any part has been subjected to pressure test this should be stated. Engine parts when referred to by numbers should be counted from forward.

considered that re-examination or repairs should be made before that date a distinguishing mark must be inserted against the item and the circumstances and action taken or recommended described fully under "defects and repairs".

The condition of any item is to be described as "good" only when it has been examined, found or placed in good condition, and is considered to be acceptable until the due date of the next Periodical Examination. Where repairs have been effected or it is

EXAMINATION AND TESTING OF STEAM PIPES (state material)

MAIN  
AUXILIARY  
(over 3" bore)

Have saturated pipes in cylindrical boiler smoke boxes been tested?

Were selected copper pipes annealed?


ELECTRICAL EQUIPMENT

PROPULSION (State Port—P, or Starboard—S)		AUXILIARY
Total kW or kVA		Total kW or kVA
a Generators		l Generators & governors
b Exciters		
c Air coolers		m Motors
d Motors		
e Air coolers		n Switchboards & fittings
f Control gear cables, etc.		o Circuit breakers
g Insulation resistance		p Cables
h Insulating oil test		q Insulation resistance
i Overspeed governors		r Steering gear generators & motors
j Magnetic couplings		s Navigation light indicators
k Air gap		

PARTICULARS OF DEFECTS, REPAIRS, ALTERATIONS, ETC.

A leakage was found at the portside shell butt strap of the starboard boiler. (Please see Dundee Report dated 15th. March 1966).

NOW DONE:- Starboard boiler examined internally and externally in way of butt strap leakage. Three rivets in way removed, the rivet holes cleaned and magnaflux tested, no signs of cracks could be found. New rivets made of Lloyd's tested material, the rivets tested to rule requirements and found good. The butt strap top edge in way of leakage cut out as per sketch and caulked internally and externally. After repairs the boiler hydraulically tested and found tight.

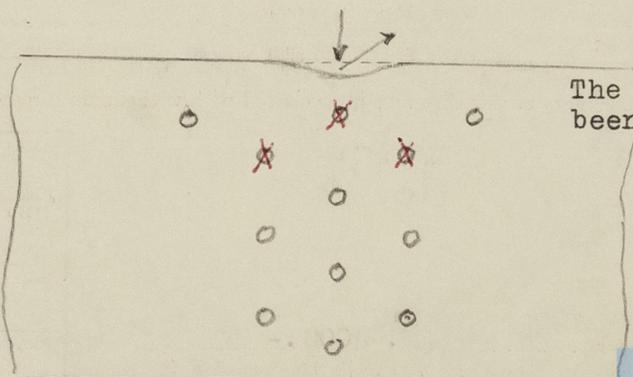

The rivets marked X have now been renewed.

The reason for repairs must be stated and those on account of damage, the alleged cause of which must be given, should be detailed separately from wear and tear repairs. State what action has been taken regarding items which are subjects of class. State also where appropriate, for the information of the Technical Records Dept., the material of the defective item and whether it is a forging, casting or welded fabrication. Any alterations in existing particulars in the Register Book should be reported above.