


DIMENSIONS: L.B.P. 440'-0" B.M.L.D. 59'-0" D.M.L.D. 35'-0"

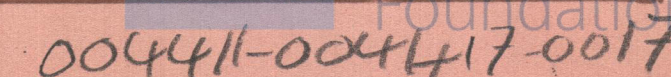

M.V. "CEDAR TRADER" ★

Conversion of oil tanks to ore carrier, April, 1956.

MIDSHIP SECTION. (as fitted)

RECORDS DEPT.,
LONDON.

2



TO ACCOMPANY	H. K. G.	REPORT No.	12984
DATED	4.56		



© 2020

Lloyd's Register
Foundation

004441-604417-017