

18 NOV 1947

Rpt. C. 11 (Contd.)

Index No.

Lloyd's Register of Shipping.

Ship's Name *CORTIC.*Official No. *149212.*

Memorandum of alterations reported since ship was surveyed for assignment of Load Lines
in *1932 & 1939.*


1. The Tonnage opening on the Shelter Deck has now been re-opened *(provided with efficient temporary covers)*
2. Ford & cft bds of tonnage well have now original openings 1 Pa 15 closed by tonnage boards carried full height in riveted channels - each 5'-0" x 4'-0", 16" sill ✓
3. Washports in the foreage well remain permanently closed by riveted plates on shell over the openings - a 5" dia automatic non return valve, joined to Shelter Dk with handwheel and indicator - discharging thro' shell 15" below freeboard dk (1 port & 1 stand) has been fitted in line ✓
4. All overboard scuppers from the shelter tween dk now re-opened, plates removed from openings at shell and storm valves on ship's side overhauled & placed in good order, scuppers led to bilges in holds now dispensed with ✓
5. Battening awnings & wood covers on the Shelter dk & Foreboard dk hatchways overhauled and made good, 3 tarpaulins now fitted to all hatches *(Cammings, beams, & supports of foreboard deck hatchways in good condition)*
6. Efficient lifelines remain provided.
7. Additional accom^y fitted in shelter tween dk aft of tonnage bhd (aft) in July 1941 has now been dispensed with, fittings removed & the following alterations effected. ✓
 - (a) Steel companionway removed (tonnage hatch now re-opened) ✓
 - (b) 4 sidelyfts on port side removed, lavatory & washbasin discharges removed and openings in shell permanently closed by spigot patches. ✓
 - (c) 4 ventilators fitted in way of accom^y now removed & openings in shelter dk permanently closed. ✓
8. Crews accom^y now fitted in bridge tween dk on shelter dk in lieu of original accom^y in forecastle on shelter dk which is now to be used for tonnage space - see sketch below. ✓
 - (a) 2 tonnage openings on aft end bhd of bridge on shelter dk now replaced by 2 hinged wood doors (1 port & 1 stand) each 5'-3 1/2" x 1'-10" clear opening, 18" sill with spring lock & handles. ✓
 - (b) Forecastle on shelter dk - 7 sidelyfts port & stand removed & openings in shell permanently closed by spigot patches - all internal blds & cabin fittings removed. ✓

Tonnage opening cut in forecastle front - 1 port & 1 stand - 5'-0" x 3'-3", 18" sill, fitted full height with storm boards in riveted channels. ✓

Stephen R. Cooke.

11th November 1947.

A copy of this Report has been placed on board the vessel.

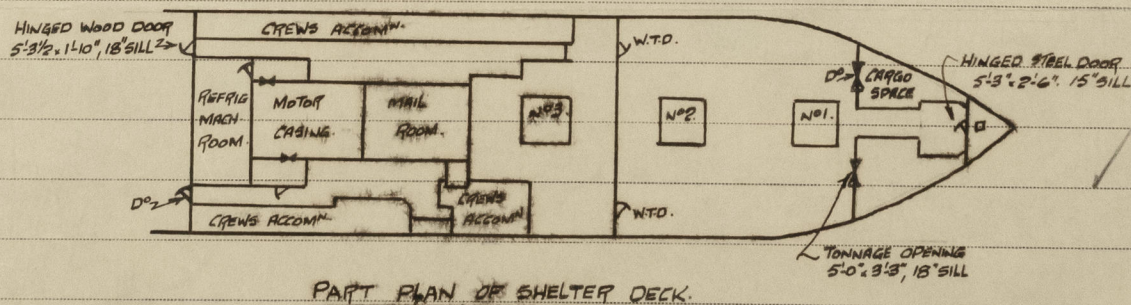

Noted
L.R.
20 Nov 1947