

Lloyd's Register of Shipping.

Ship's Name "COPTIC"

Official No. 149312

Memorandum of alterations reported since ship was surveyed for assignment of Load Lines
in 1932

- 1) Tonnage opening on the shelter deck permanently closed by fitting a B.A. beam and wood decking caulked and payed.
- 2) Wash ports in the tonnage space permanently closed by riveted plates over the openings.
- 3) All overboard scuppers from the shelter tween decks permanently closed by welding plates over the openings at the shell, and the tween decks are efficiently drained to the bilges.
- 4) The present battening arrangements of the shelter tween deck hatchways are being maintained and are efficient.
- 5) Efficient lifelines are provided.
- 6) The statutory deck line has been cut in at the top of the steel shelter deck, and the freeboard has been re-assigned.

Arthur H. Smith
4/12/39

A copy of the above memorandum has been placed on board the ship.

No alterations have been effected to the tonnage space bulkheads.

New gross tonnage 10628.78

" nett " 6596.84

Fee £5-0-0 21 DEC 1939



Lloyd's Register of Shipping.

Ship's Name

"COPTIC"

Official No. 149312

Memorandum of alterations reported since ship was surveyed for assignment of Load Lines in 1932

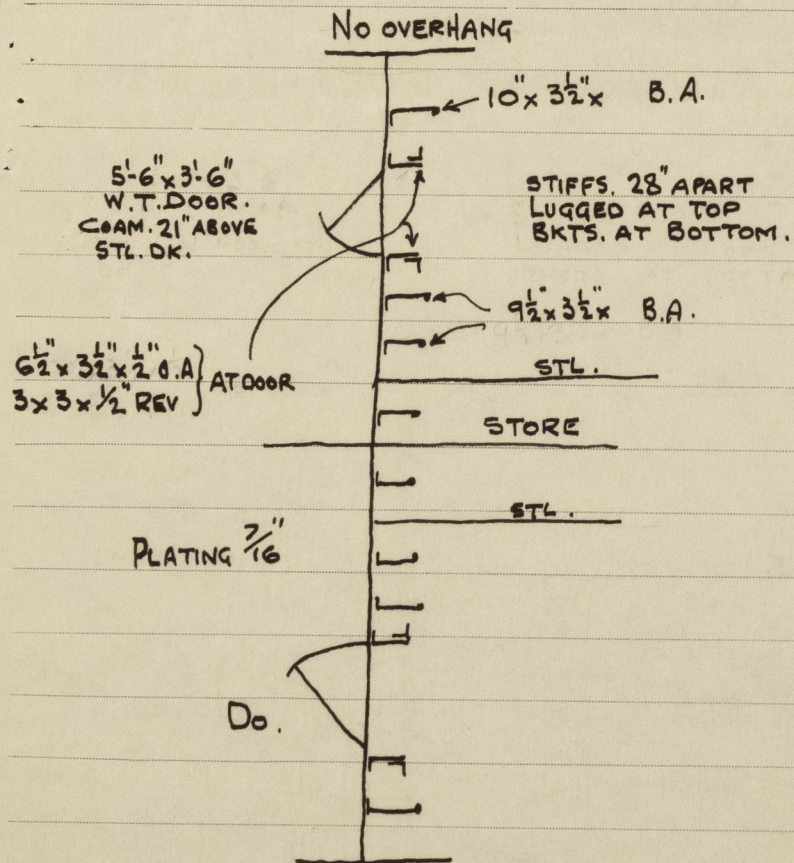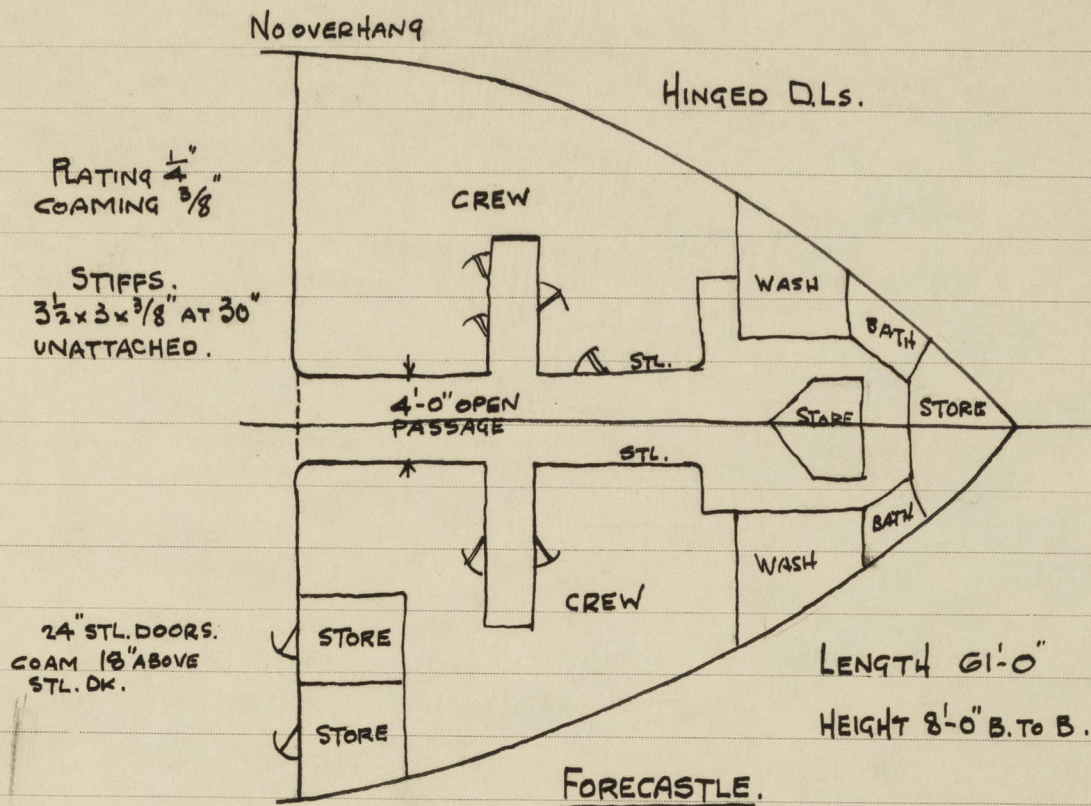


BRIDGE FRONT

HEIGHT = 8'-0" B. TO B.

LENGTH = 173'-0"

REGISTERED DEPTH = 39.3'

Forward of bridge 80.75' forward of Arthur H. Smith

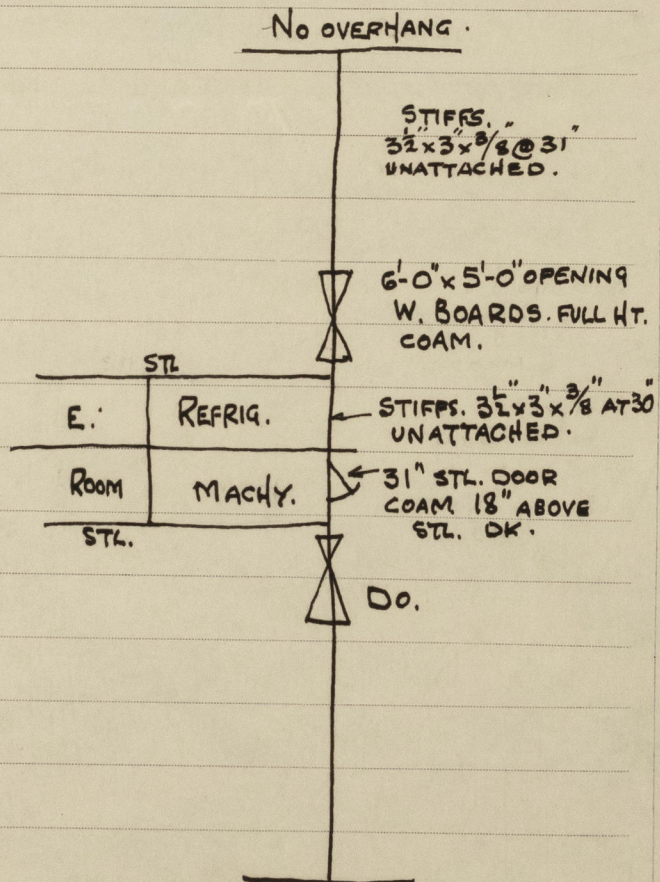

BRIDGE AFT.