

# Longitudinal Section & Deck Plans


S.S. No. 109

Dimensions 229'5" x 36'9" x 16'0" Mtd to Main Deck

Scale 1/8" = 1'0"

To Class B.S. Survey at British Corporation


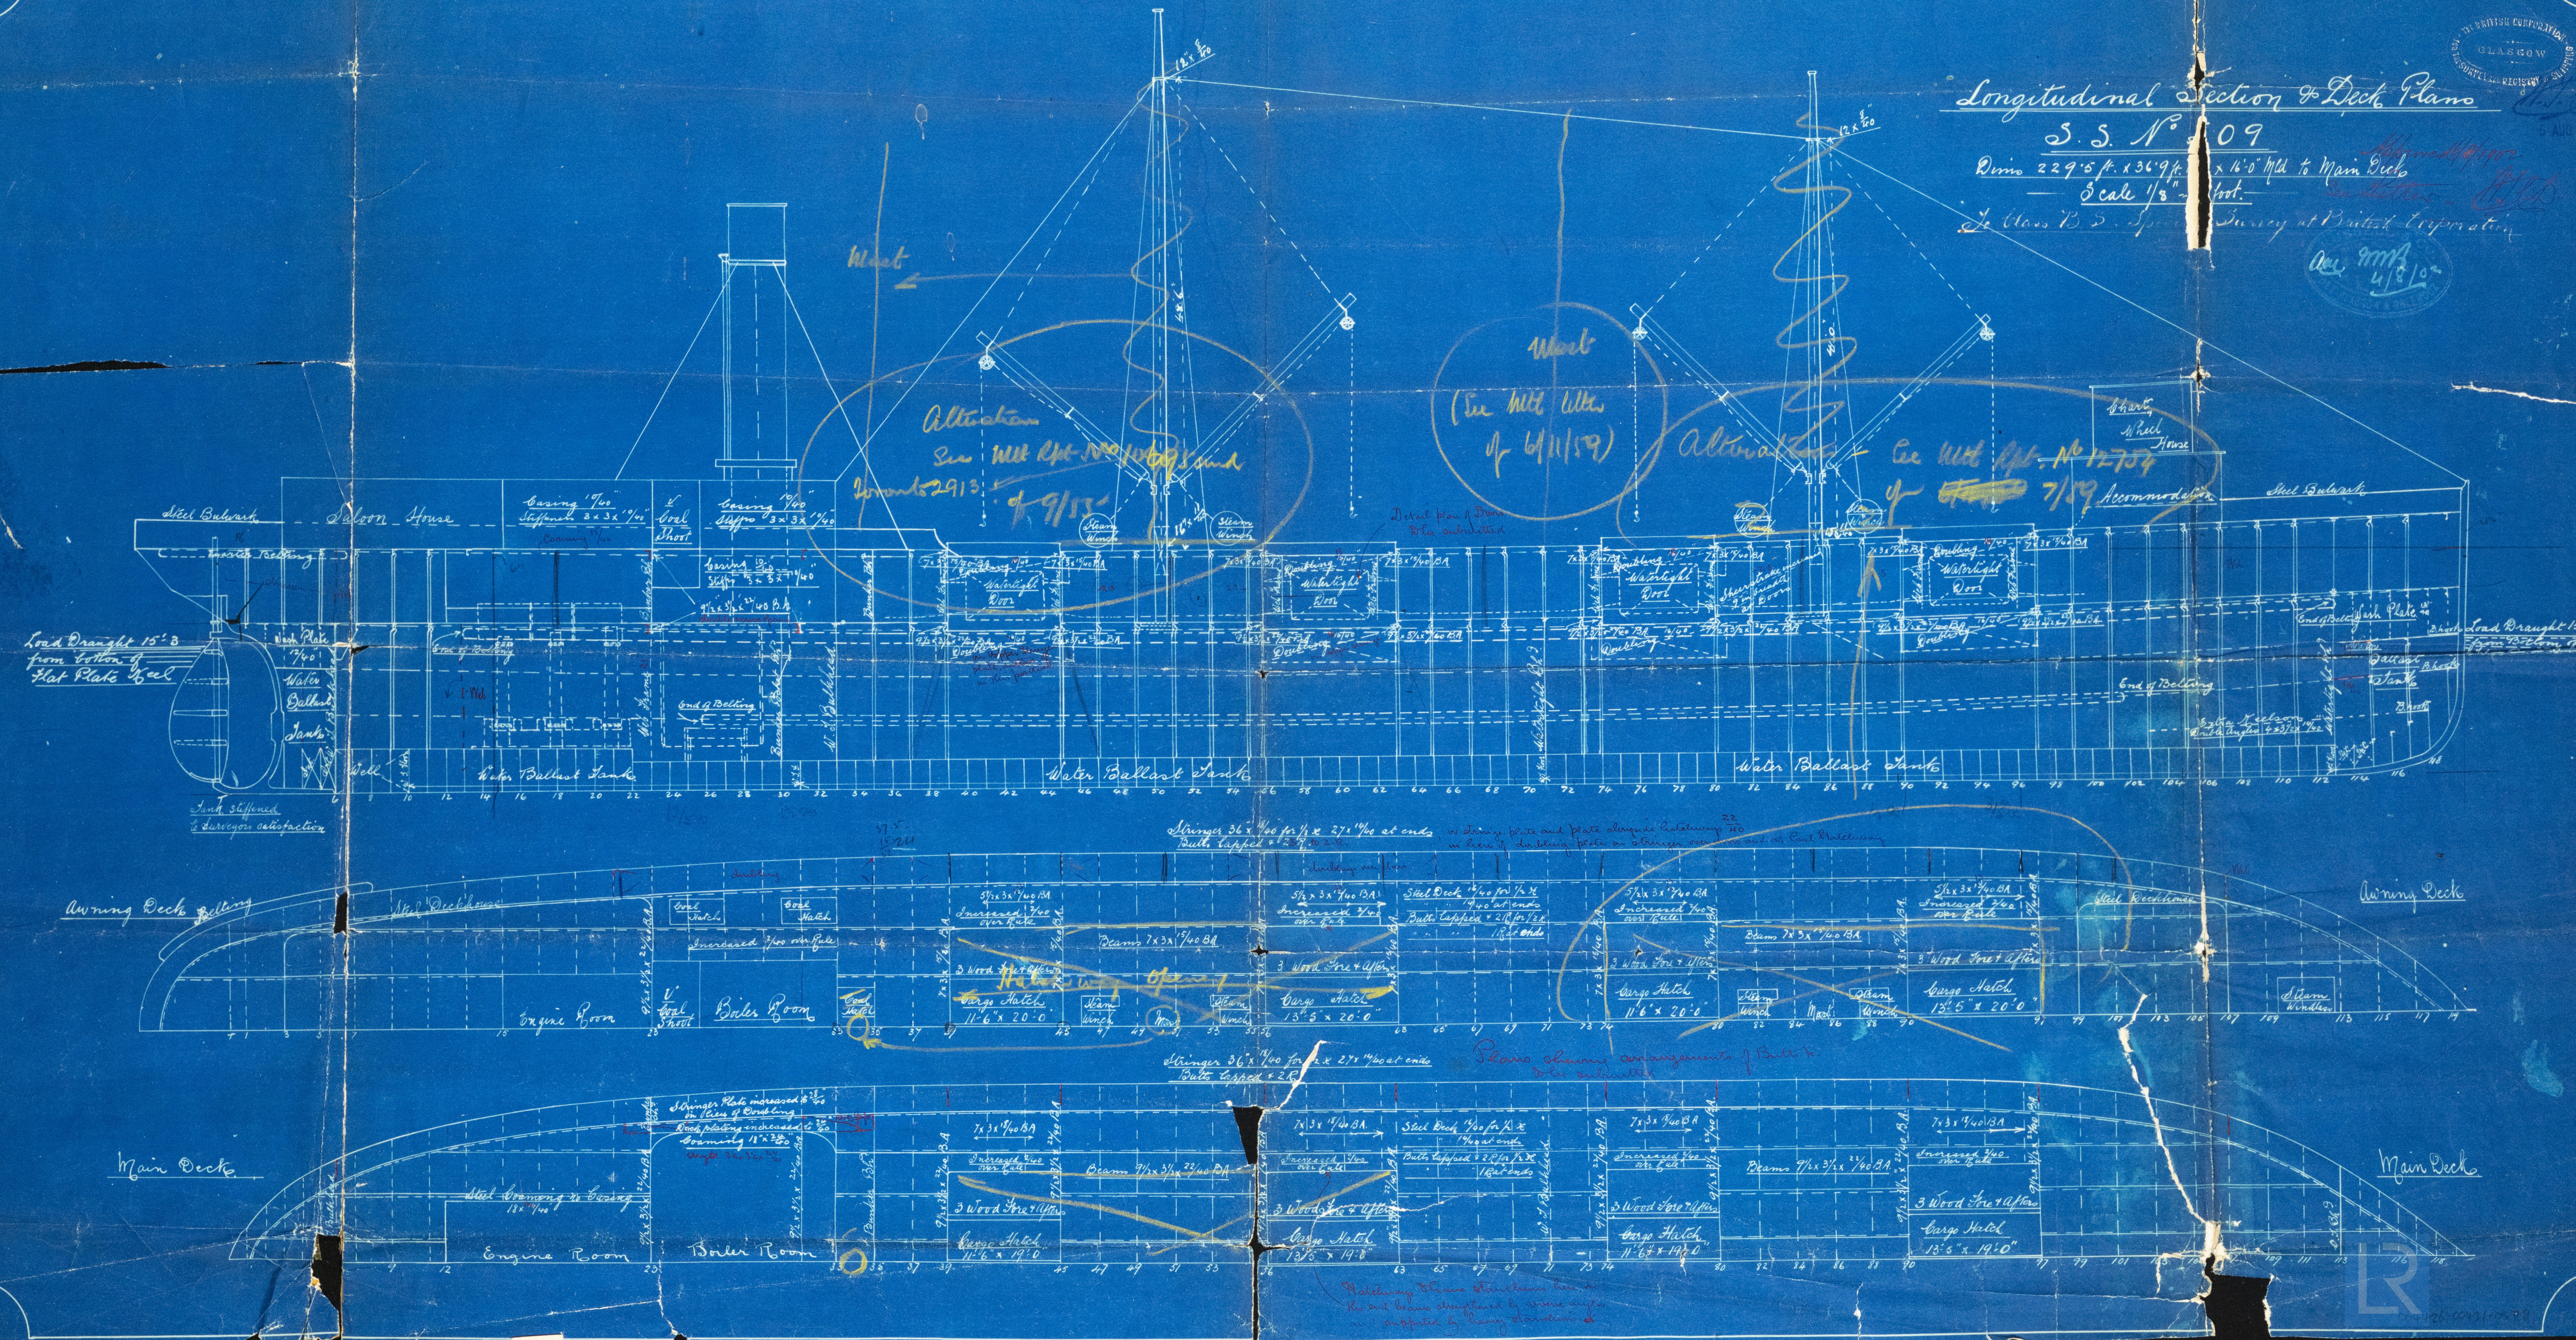



Russell's N<sup>o</sup> 509.

---

Profile + Decks

---

SS. "Wahcondah"

---




© 2021

Lloyd's Register  
Foundation

004426-004431-0078



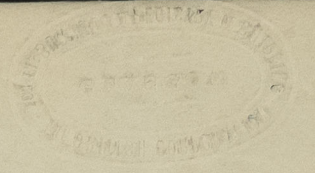

Acc. 97773  
4/8/02


004426-004431-0078



© 2021

Lloyd's Register  
Foundation