
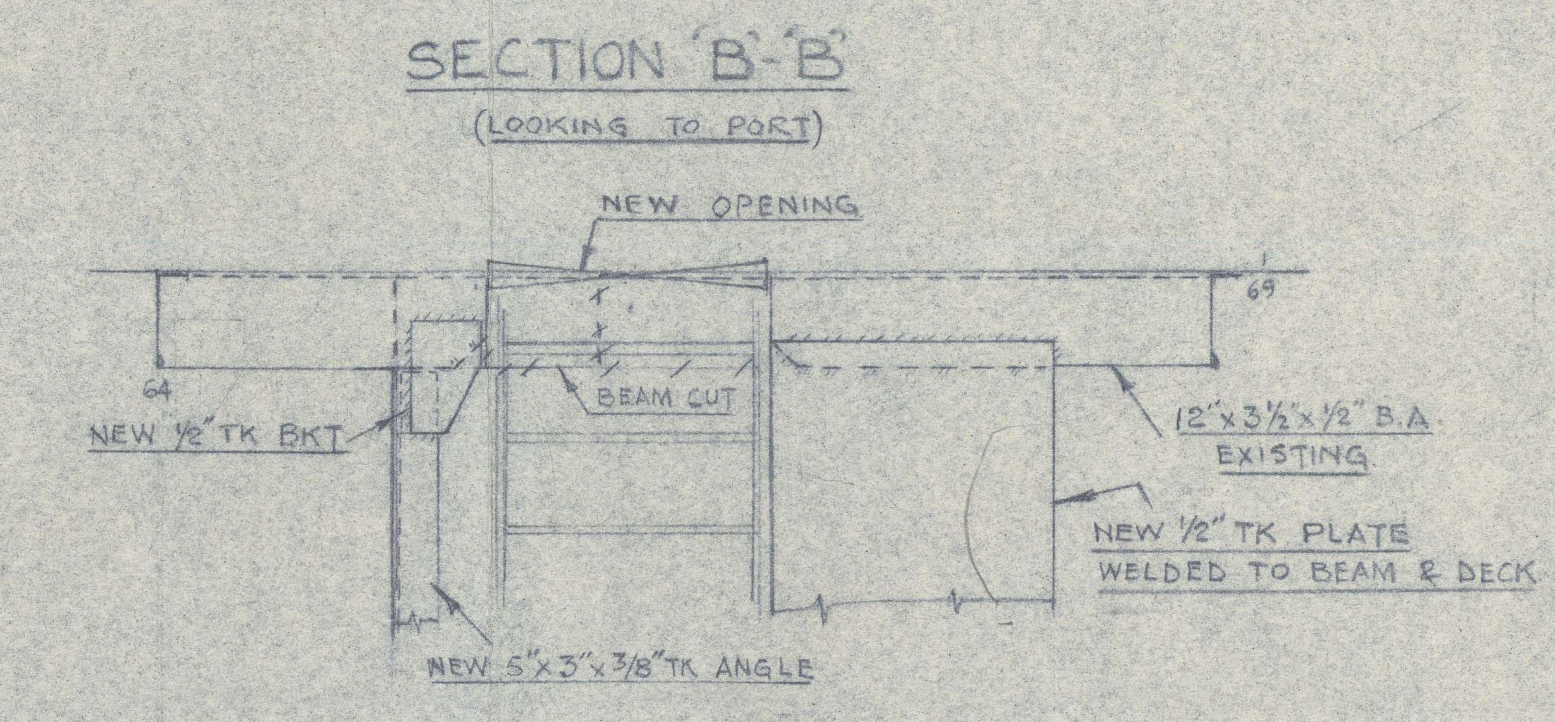


Height of rails on external doors to be considered with C.11 (under)

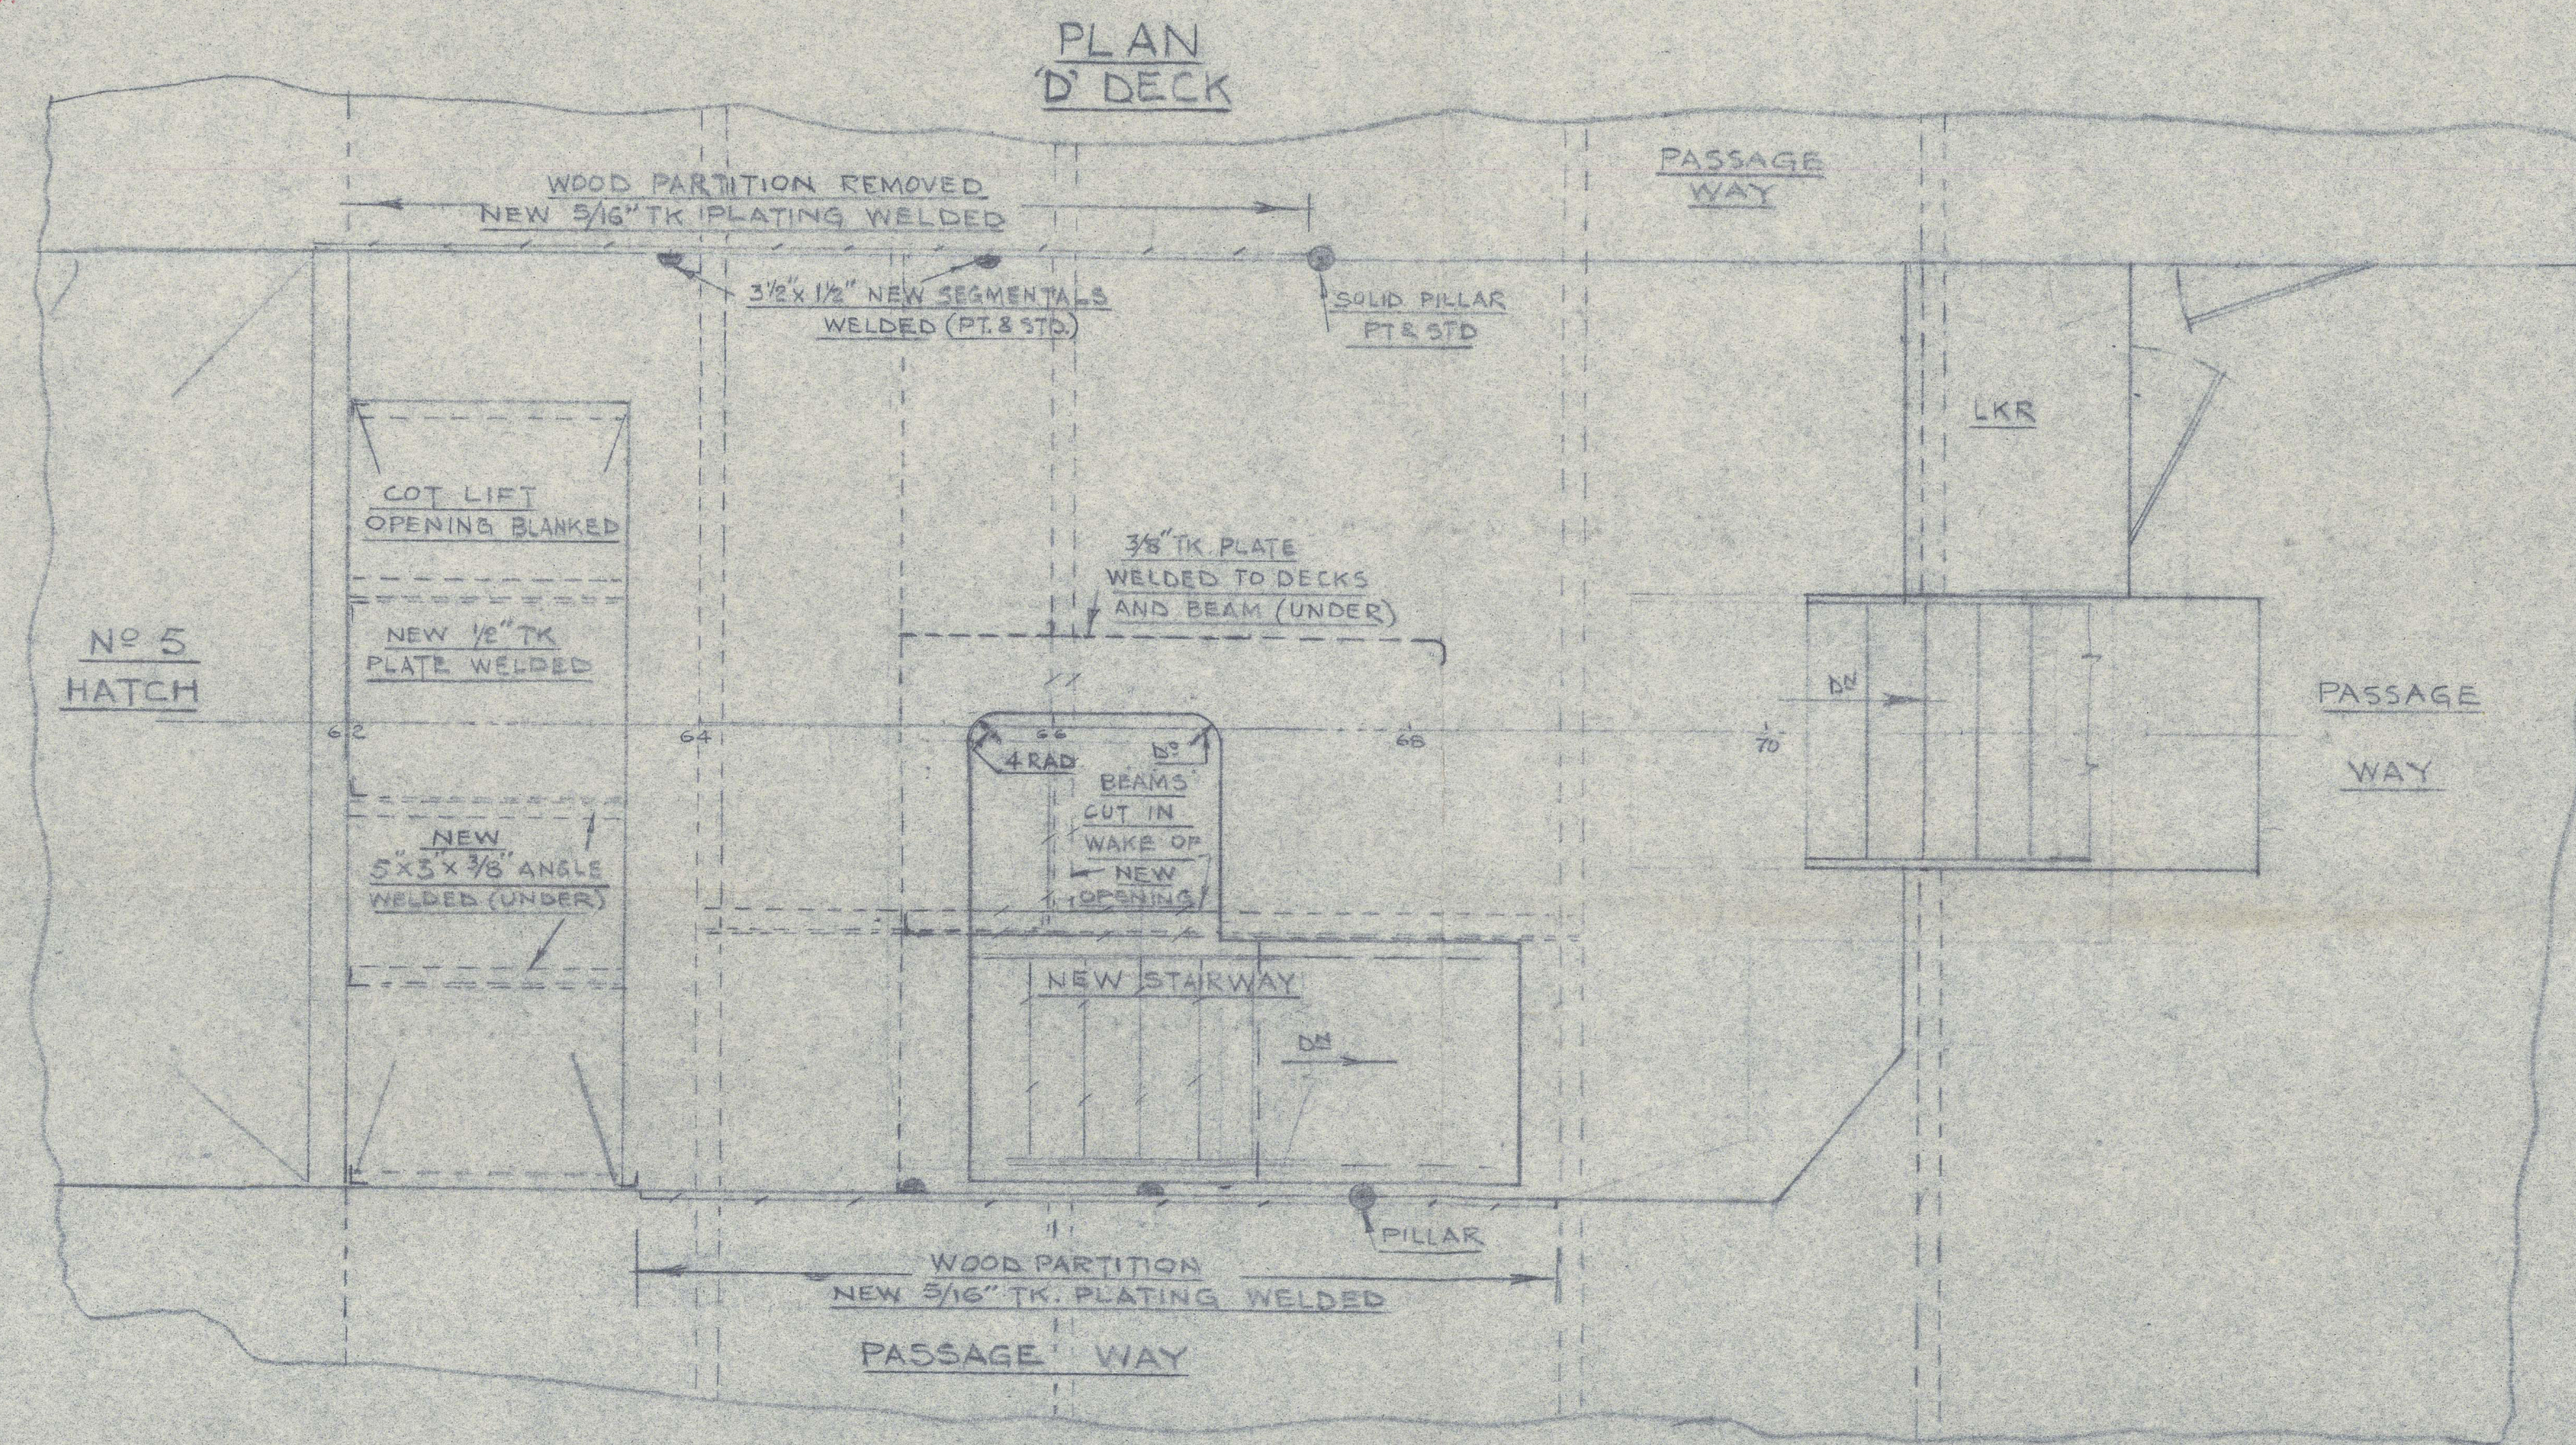

NEW DOUGLERS SHOWN IN RED
EXISTING DOUGLERS SHOWN IN BLUE

Office copy R. 21/1/64