

Nos 1460 & 1461.

STRUCTURAL PROFILE & DECKS.

SCALE: $\frac{1}{16}$ " = ONE FOOT.


DIMENSIONS: 460'-0" x 63'-0" x 40'-3" & 30'-9"

FOR GENERAL PARTICULARS SEE 'MIDSHIP SECTION'



SOLID FLOORS. ON EVERY FRAME FORD OF 25L UNDER BOILER BEARERS, BULKHEADS AND ON EACH FRAME IN ENGINE ROOM. PARTIAL SOLID FLOORS UNDER THRUST SEATING. ELSEWHERE THEY ARE TO BE SPACED 10'-0" APART WITH BRACKET FLOORS ON EVERY FRAME BETWEEN HATCHES STIFFENED AND STAYED AS PER RULES.

STIFFENING UNDER DAVITS, MASTS, WINCHES, WINDLASS ETC. STEERING GEAR, DECKHOUSES, ETC. TO SURVEYORS SATISFACTION.

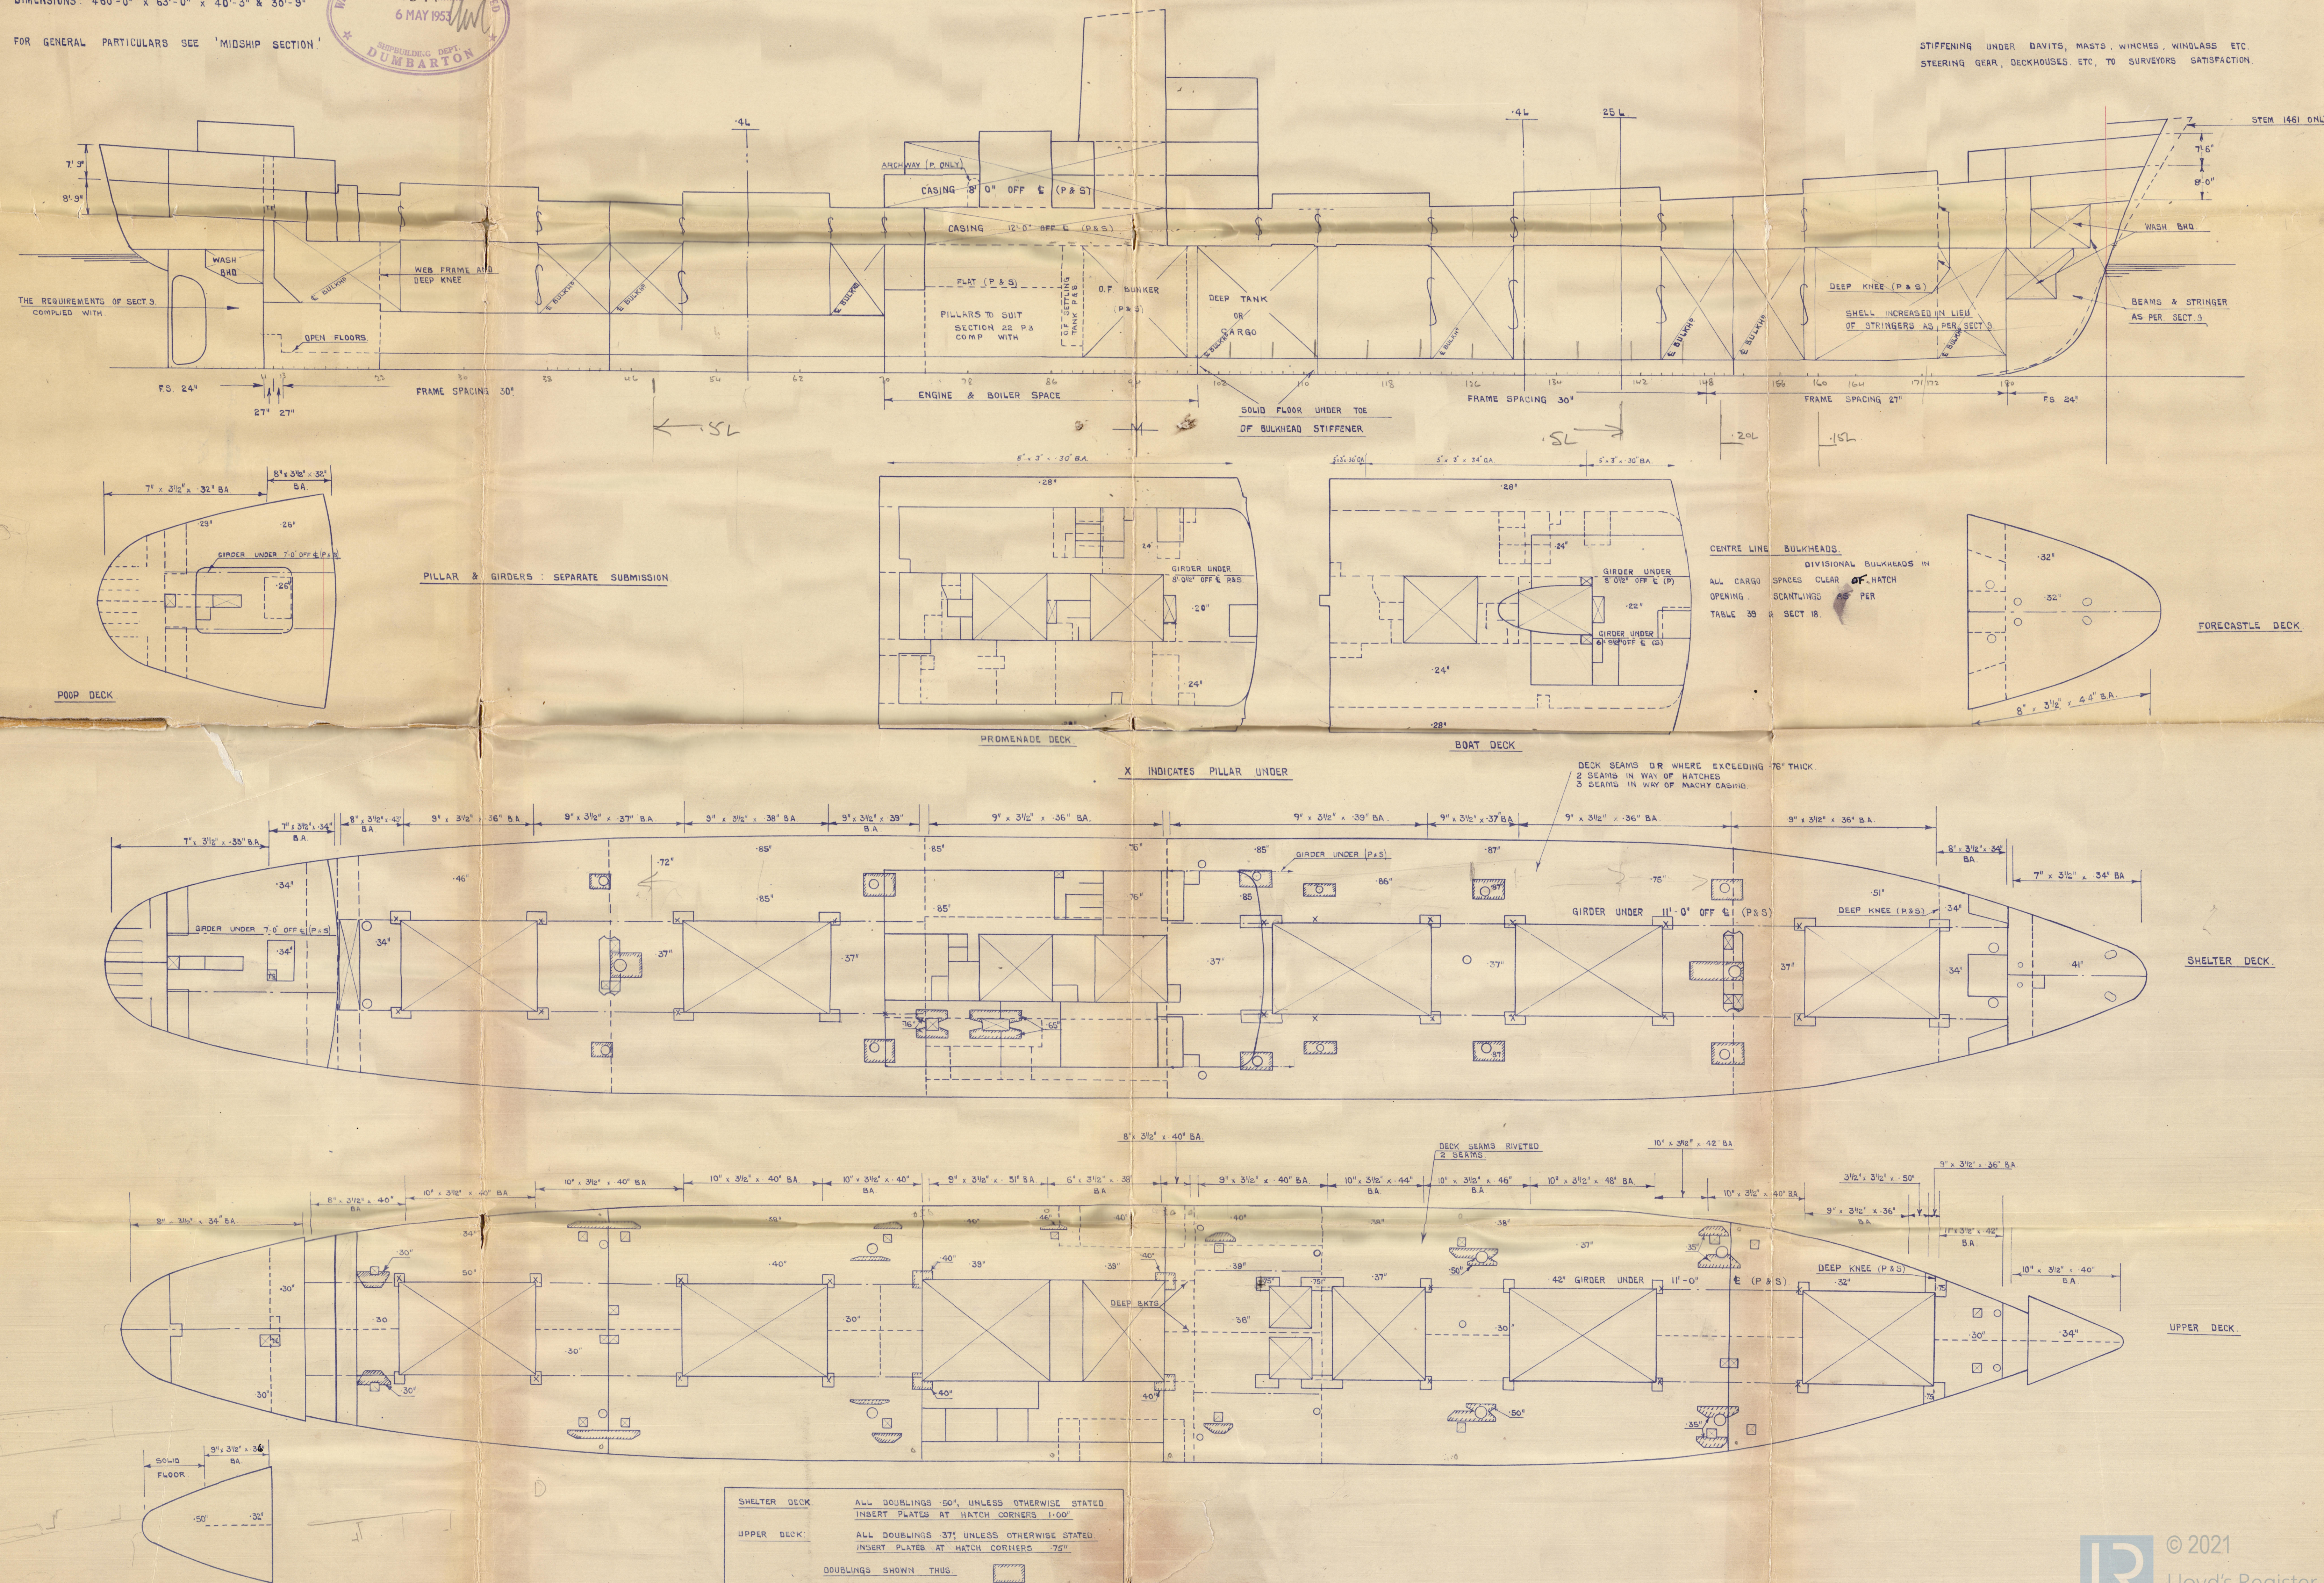

Nos 1460/1.

Wm Denny & Bros. Ltd.

Structural Profile & Wecks, (as built).

~~ALLYONE~~
GLASGOW REPORT No. 78248.

EX
Georg. ★

GLASGOW REPORT No. 80755

78248

RECORDS DEPT.,
LONDON

4

004426-0044 31-0118



© 2021

Lloyd's Register
Foundation