




M. V. "KELLETTIA"

SKETCH SHOWING CRACK

AT BOTTOM OF STERN FRAME

AFTER REPAIR (P.&S.)

SCALE:- $1\frac{1}{2}" = 1'-0"$

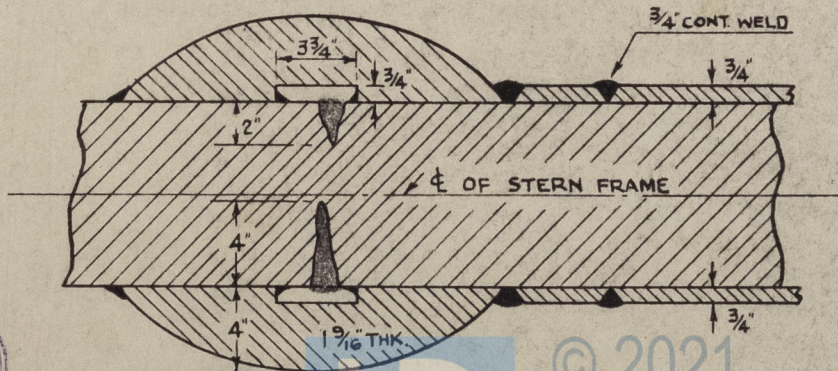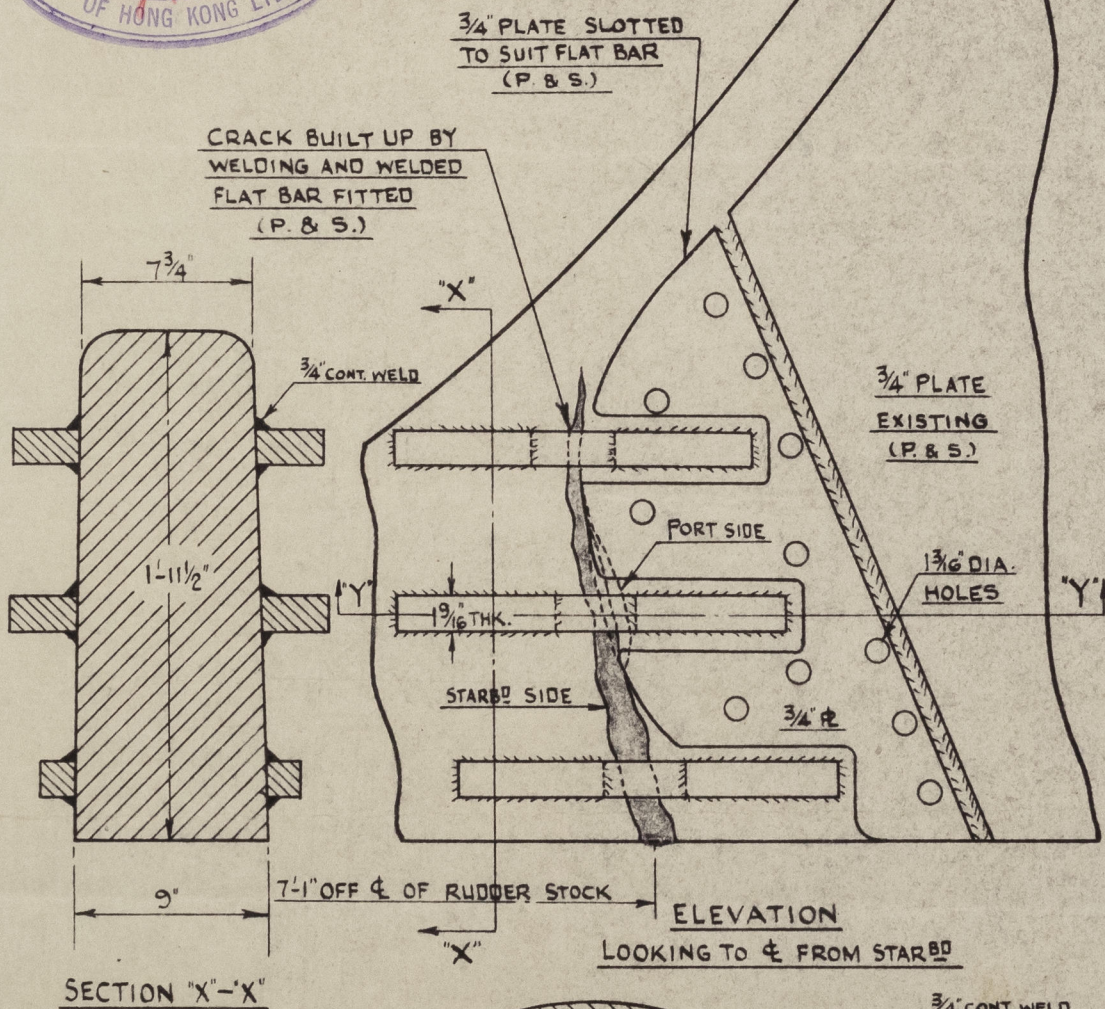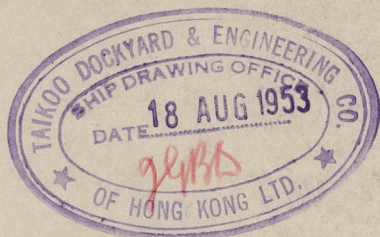

SECTIONAL PLAN VIEW THRO' "Y"- "Y"

T. D. & E. COMPANY
DRAWING NO 3457

004440-004449-0064

"
Kellletia
"

Crack in bottom of stern
frame

TO ACCOMPANY..... H.Kg. REPORT No. 11693
DATED..... 8.53



© 2021

Lloyd's Register
Foundation