


SKOTT 440" FRA M.

PLAY RV TUNNELTOP.

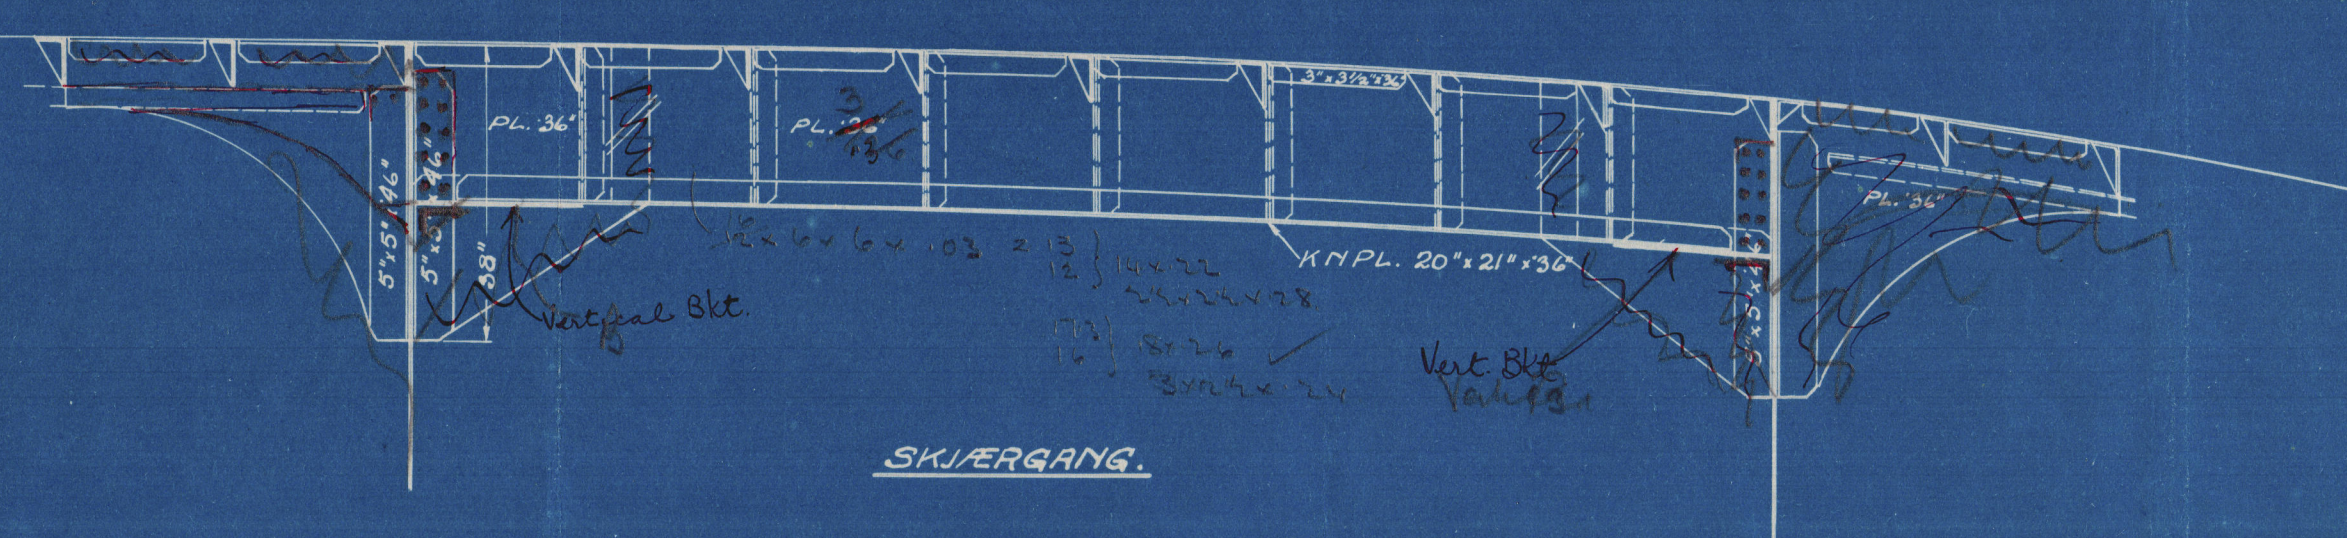

RETTET EFTER VERITAS 2/5-30

EX. 4/B. "GRANADA." "LANZA."

TANKER OMBYGGET FOR OLJEFYRING

SKALA 1/2"=1FOT

SARPSBORG MEK. VERKSTED A/S.

GREÅKER 29/4-30

3
2

Midship Section & Bulkheads.

§5 "A.N.4" EX "SONJA"

Oslo. App'd 20.5.30.

Borg.



© 2021

Lloyd's Register
Foundation