

Lloyd's Register of Shipping.

Ship's Name DELFSHAVEN

Official No. -

Memorandum of alterations reported since ship was surveyed for assignment of Load Lines in

Items 2 and 3 reported by the Hull Surveyor in 1943 (accommodation in shelterdeck amidships and aft) were found removed. Situation now as given in original freeb. rpt. Openings in deck, bulkheads and shell plating efficiently closed by E.W. plates.

Guard rails.

Open rails removed from maindeck.


Plain bulwark fitted. →

Height 1000 ^{mm}/m

Length 385'-0" (from Forecastle to aft perpendicular)

10 freeingports each side, dimensions 1410 x 320 ^{mm}/mArea each side: 45.12 ^m²Height above deck edge: 210 ^{mm}/m

8 Scuppers each side through stringer angle.

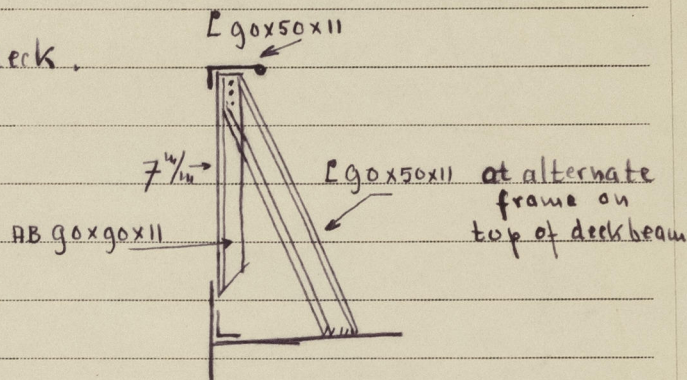

Inspected.

6 - NOV 1947

Rotterdam

October 1947



© 2020

Lloyd's Register
Foundation

004459-004465-0101