


M.S. "Oakmore" Metalock repairs to Starb-Ford Generator

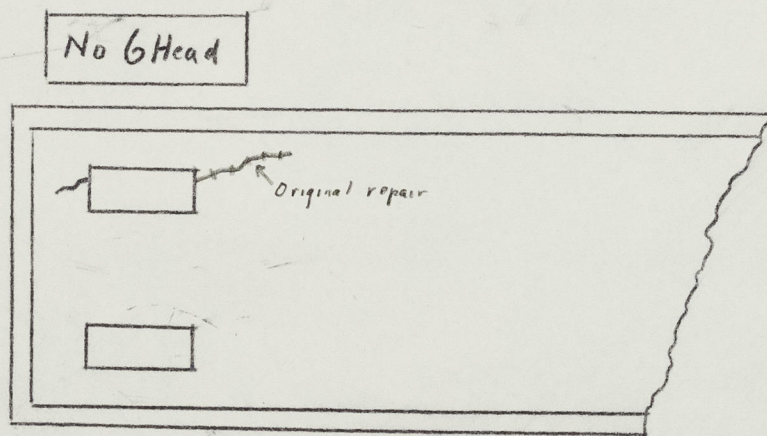

© 2020

Lloyd's Register
Foundation

004466-004476-0240