

29 FEB 1960

# LLOYD'S REGISTER OF SHIPPING

## ALTERATIONS TO CONDITIONS OF ASSIGNMENT OF LOADLINES


Ship's Name " O A K M O R E " 4.700 tons gross Official No. 180796.

Port of Registry Liverpool.

This ship has been under survey at Antwerp.

on 23rd. February 195 60 and the following alterations to the conditions of assignment of loadlines have now been effected/~~found~~:-===

The flush bunker scuttle aft on poop to steering gear compartment has now been permanently sealed by welding steel plate to deck frame.

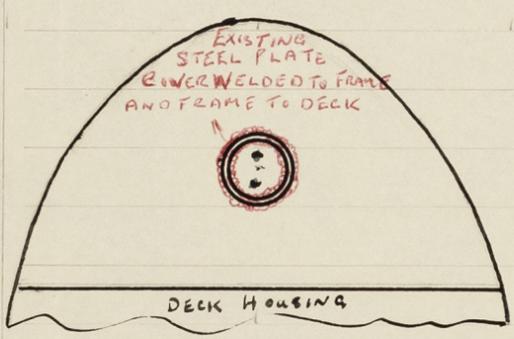

*J. Howarth* J. Howarth.

Surveyor to Lloyd's Register of Shipping. Antwerp. 23.2.60.

*Noted  
2/3/60*

A copy of this Report has been placed on board.



© 2020

Lloyd's Register Foundation

004466-004476-0369