


PRINCIPAL DIMENSIONS
 LENGTH B.P.P. ON 27'-7" W.L. 573'-6"
 BREADTH MOULDED 74'-0"
 DEPTH MOULDED TO UPPERDECK 48'-9"

T.S.M.V. "SIR JAMES CLARK ROSS"
 GENERAL ARRANGEMENT
 SCALE 1:200

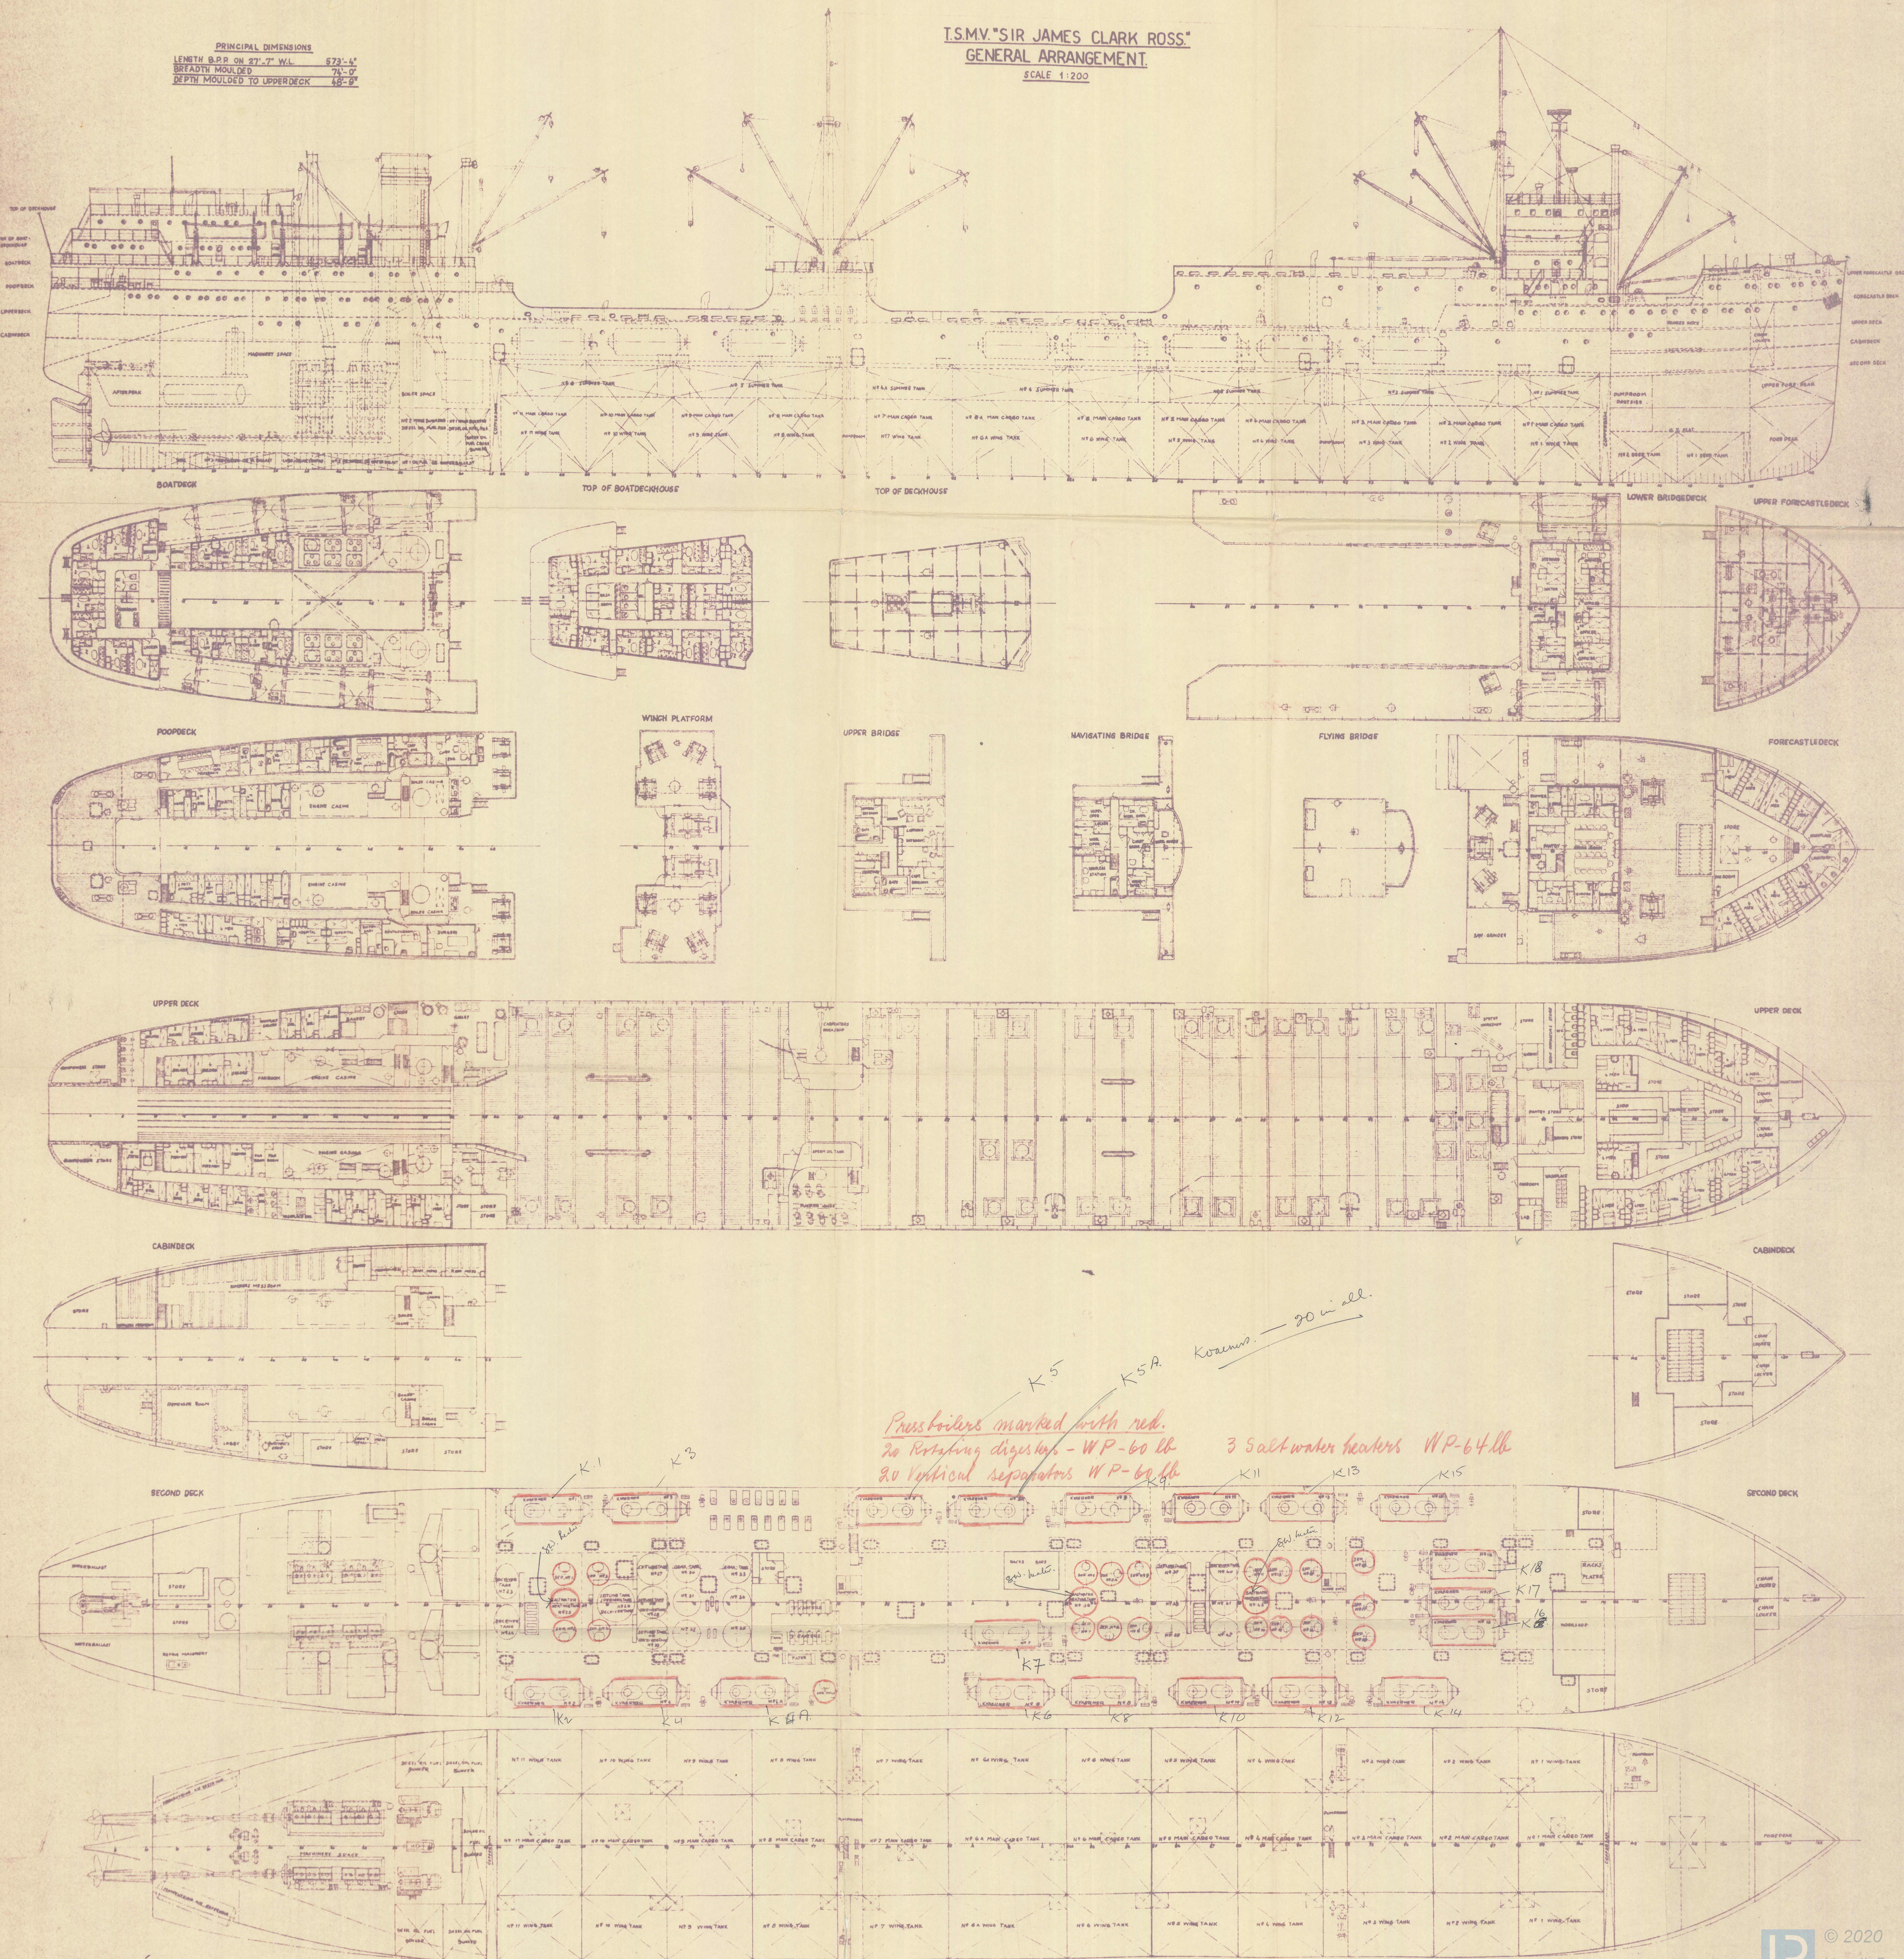

Pressboilers marked with red.
 20 Retaking digesters - WP-60 lb
 20 Vertical separators WP-60 lb
 3 Saltwater heaters WP-64 lb

Korens - 20 in all

"S/MS" SIR JAMES CLARK ROSS "

ACCOMPANY *Gothenberg* Rpt. No 23291

Dated 5.57

SUBJECT:-



© 2020

Lloyd's Register
Foundation

004486-004488-0183

"Sir James Clark Ross".

General arrangement of Decks showing
Location of Press boilers.

Govt. rept No. 23291.



© 2020

Lloyd's Register
Foundation

004486-004488-0183