

Oslo

Plan showing
location of
Press Boilers

on the S.S./M.S. "SIR JAMES CLARK ROSS"

Placing of Press Boilers

Kvarner Digesters and Separators


20-0 = Kvarner Digester } or Press Boilers

20-0 = separators.

FWD. 40 Total.

24/11/64.

Digester No 1	29m ³	Built	1948
2	"	"	"
3	"	"	"
4	"	"	"
5	34m ³	"	1954
6	"	"	1952
7	29m ³	"	1949
8	34m ³	"	1954
9	"	"	1955
10	29m ³	"	1946
11	34m ³	"	1954
12	29m ³	"	1946
13	"	"	1948
14	"	"	1946
15	"	"	1948
16	"	"	1946
17	"	"	1948
18	"	"	1954
19	"	"	"
20	"	"	1949

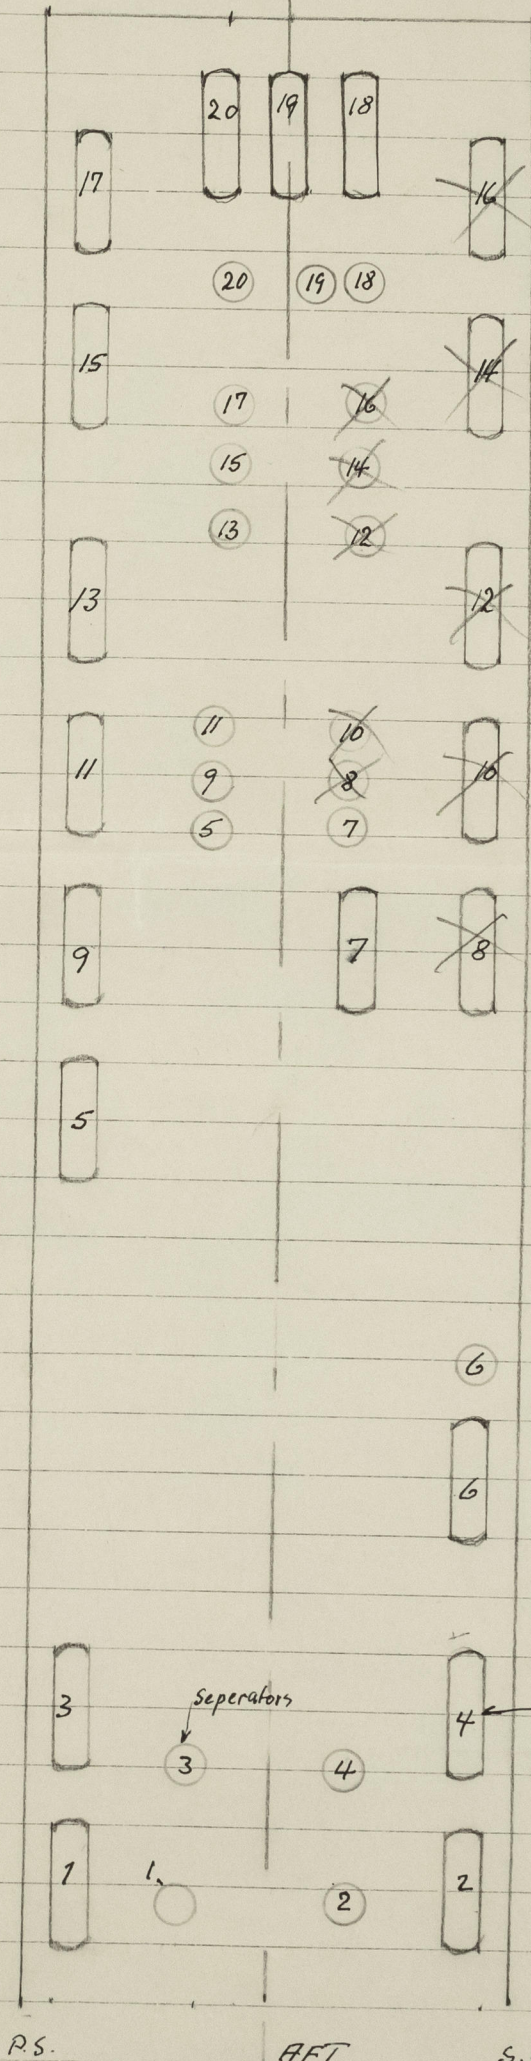

X removed 11/64

Respective Separators

Built corresponding year.

1/2 June

Separators

Digesters

P.S.

AFT.

S.S.



© 2020

Lloyd's Register
Foundation