


JALA PRATAP.

DETAILS:- SCALE AS INDICATED.

MAKERS:- WILLIAM BRADMORE & CO., LTD. GLASGOW.

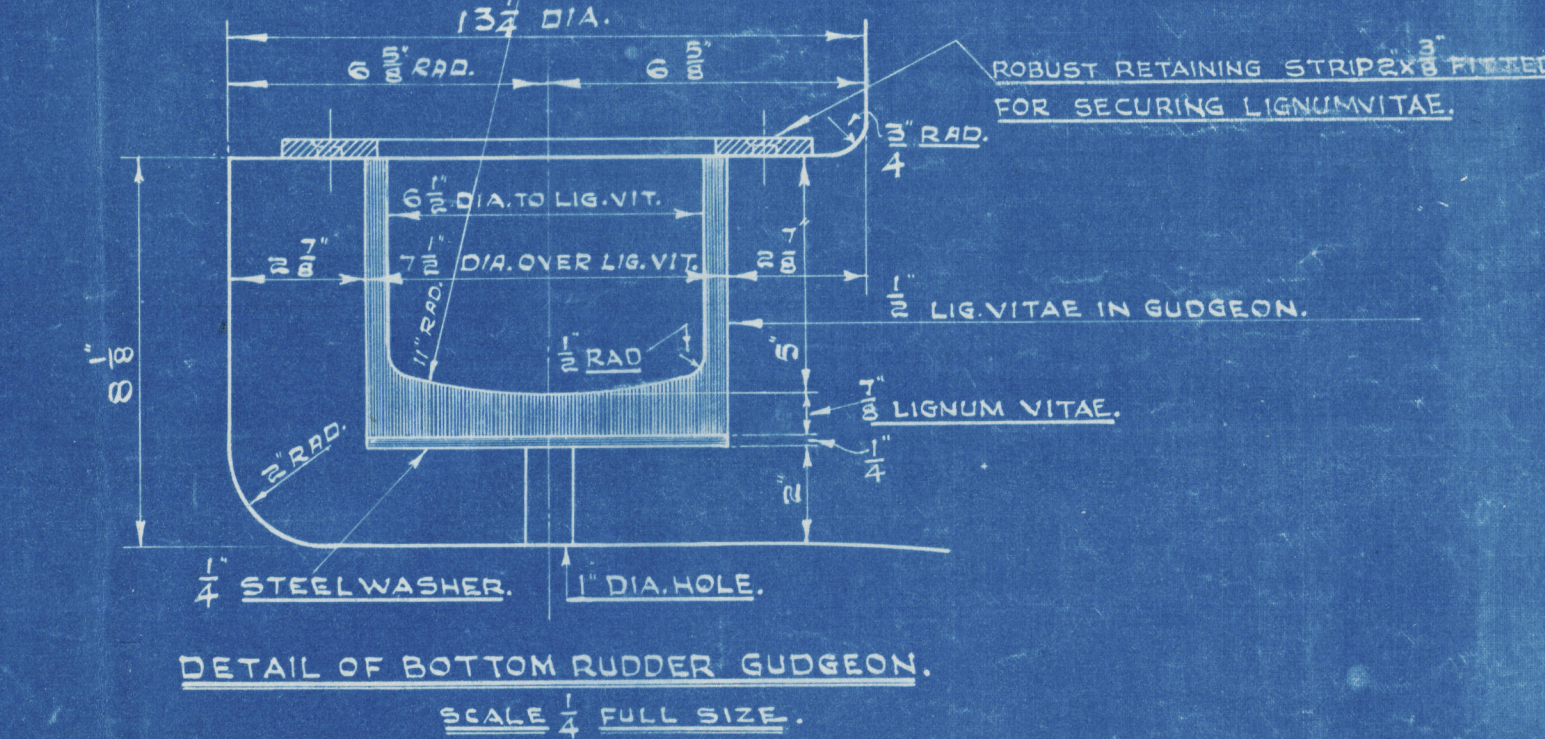



8

S.S. "JALAPRATAP" ★

YARD No V.C. III M/M. 4508



CAST STEEL STERNFRAME

As Fitted

RECORDS DEPT.  
LONDON

3

HINDUSTAN SHIPYARD LTD,  
VIZAGAPATAM  
S. INDIA

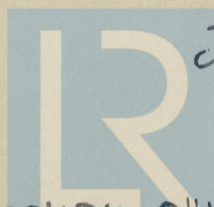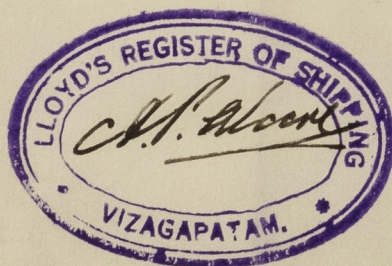

July, 1952

Lloyd's Register  
Foundation

004502-004511-0144