





2

S. S. "JALA PRATAP" ★


YARD N<sup>o</sup> V.C. III

PROFILE DECKS & TANK TOP.

"AS FITTED"

RECORDS DEPT.  
LONDON

2

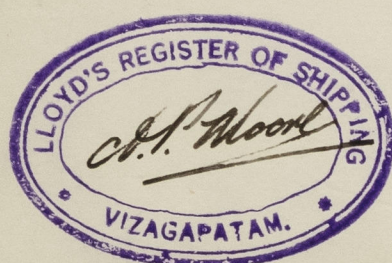

HINDUSTAN SHIPYARD LTD  
VIZAGAPATAM  
S. INDIA

July, 1952

004502-004511-0147

RETAIN



© 2020

Lloyd's Register  
Foundation