


Motor Trawler "JOÃO ALVARES FAGUNDES"

The steel cover of No. 1 Hatch (to forward fish hold) has now been removed at the request of the Owners and substituted by wood hatch covers 70 m/m thick.

A fore and after beam of 150 x 75 x 11 Bulb Angle, 75 m/m rest bars each side and cleats spaced 520 m/m have been fitted. Wedges and 3 tarpaulins supplied.

The height of the coaming above the deck is 400 m/m.

G.D.M.

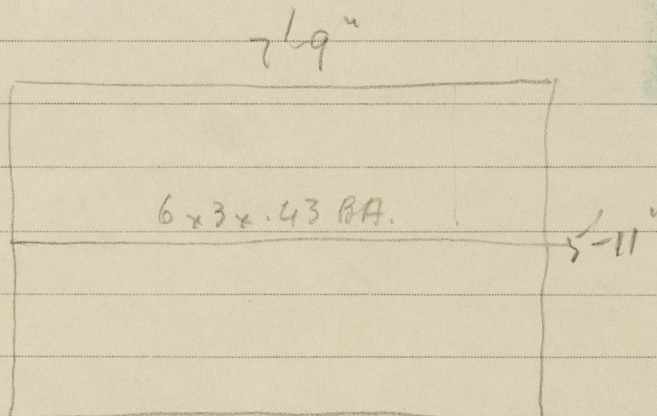

Noted
17 AUG 1945
X.P.



© 2020

Lloyd's Register
Foundation

004502-004511-0204