


Lloyd's Register of Shipping.
SURVEYS FOR FREEBOARD.
(CONDITIONS OF ASSIGNMENT.)

Ship's Name JOÃO ALVARES FAGUNDES Port of Survey LISBON
Official Number _____ Surveyor's Signature G. Dixon.
Nationality and Port of Registry Portuguese - Lisbon. Date of Survey May 1945

Disposition and dimensions of superstructures, trunks, deckhouses and machinery casings to be inserted in the diagrams and tabular statement : —

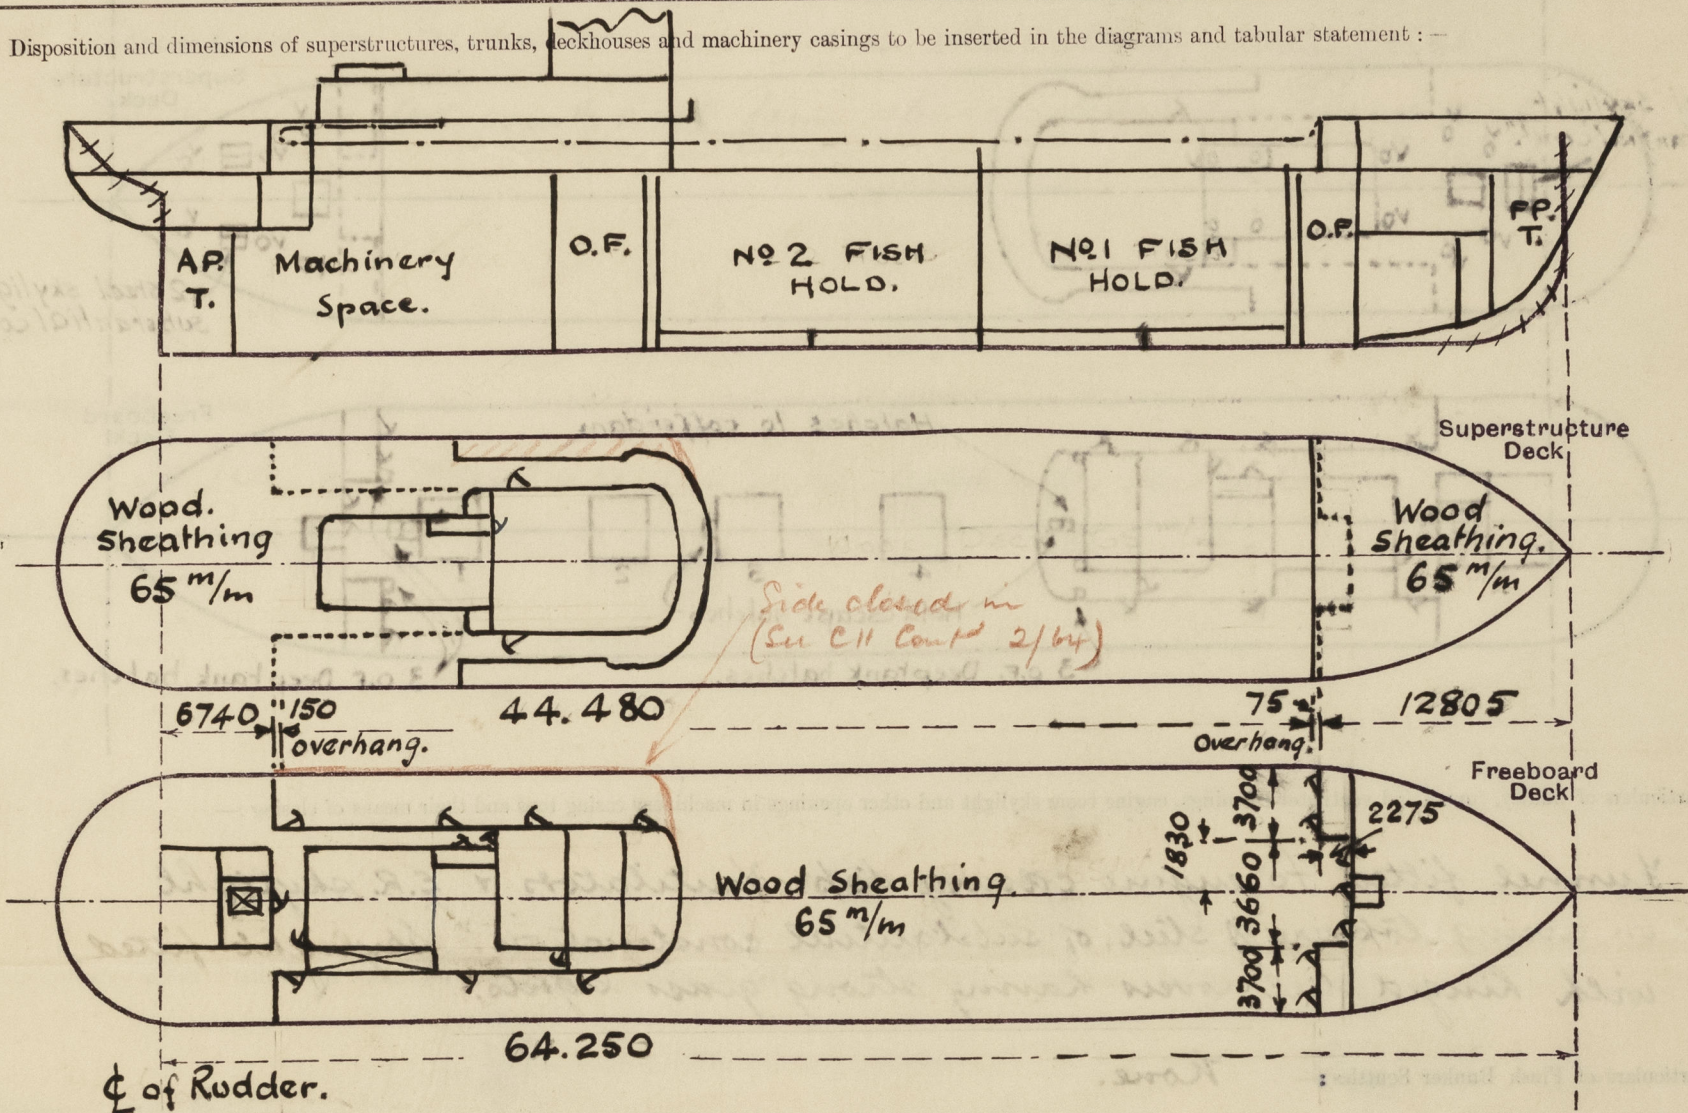


Particulars of Superstructures, Trunks, Casings, Deckhouses.

	Coaming	Plating	Stiffeners	Spacing	End Attachments of Stiffeners	Size of Openings	Height of Sills	Height of Casings
Poop Bulkhead ...	400x8	7	L100x75x9	760	Full height rivets in top & bottom angles.	None	✓	2200 ✓
Raised Quarter Deck Bulkhead ...	✓							
Bridge, After Bulkhead ...	✓							
Bridge, Forward Bulkhead ...	✓							
Forecastle Bulkhead ...	700x7	6.5	L100x75x9	760	Full height rivets in top & bot. angles.	2 ea. side house 1400 x 600 2 in recess 1400 x 700 1 on C to companion 1300 x 800	460 460	2200 ✓
Trunk, Aft ...	✓						460	
Trunk, Forward ...	✓							
Exposed Machinery Casings on Freeboard or Raised Quarter Decks ...	400x8	7	L100x75x9	885	Brkts. Top	1400 x 700	460	2200 ✓
Exposed Machinery Casings on Superstructure Deck, Freeboard.	700x8	6	L100x75x9	885	Brkts. to beams.	1500 x 600	460	2200 ✓
Machinery Casings within Superstructures not fitted with Class I Closing Appliances ...	✓							
Deckhouses on Flush Deck Ships ...	✓							

Particulars of Closing Appliances (state if capable of being manipulated from both sides).

Poop Bulkhead ...	None No openings.
Raised Quarter Deck Bulkhead ...	✓
Bridge, After Bulkhead ...	✓
Bridge, Forward Bulkhead ...	✓
Forecastle Bulkhead ...	Steel doors capable of being manipulated from both sides.
Exposed Machinery Casings on Freeboard or Raised Quarter Decks ...	" " " " " " " " " "
Exposed Machinery Casings on Superstructure Decks ...	" " " " " " " " " "
Machinery Casings within Superstructures not fitted with Class I Closing Appliances ...	✓
Deckhouses on Flush Deck Ships ...	✓

The following diagrams should be used to indicate the positions of cargo and coaling hatchways, gangway, cargo and coaling ports, ventilators, companionways, etc., which would affect the seaworthiness of the ship:

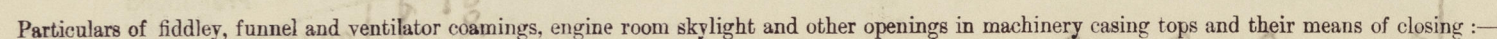

Particulars of Flush Bunker Scuttles:— *None.*

Particulars of Companionways :—

Particulars of Ventilators in exposed positions on freeboard and superstructure decks :—

All fitted with wood plugs and canvas covers.

Particulars of Air Pipes in exposed positions on freeboard, raised quarter, or superstructure decks :—

O.F. tank air pipes fitted with gauge wire. Remainder with wood plugs.

Particulars of Gangway Cargo and Coaling Ports:—

none. ✓

JOÃO ALVARES FAGUNDES

Particulars of Scuppers and Sanitary Discharge Pipes :—

Sanitary discharges from T'ele and Loop W.C's & baths led to ship's sides below freeboard deck and fitted with brass non-return valves.

Scuppers on foreboard deck cut in sheer stake above deck.

No scuppers led overboard from spaces below freeboard deck.

Particulars of Side Scuttles:—

In F'dle. :- 7 each side 250 $\frac{1}{2}$ m dia. fitted with deadlights

In Pops :- 3 " " " " " " " " " " " "

All of substantial construction

Vertical distance of Sill of lowest Side Scuttle above top of keel

In superstructures only

Particulars of Guard Rails :—

On Fore & Poop decks 1.100 m in height, stanchions 1.300 apart with 2 Rails. On Freeboard deck bulwarks 1.100 m in height

Particulars of Gangways, Lifelines, etc. :—


Provision made for rigging lifelines from pile. to deck houses.

Particulars of Freeing Arrangements.						
	Length of Bulwark	Height of Bulwark	Size of Freeing Ports	Number each side	Area each side	Rule area each side]
After Well ... } ...	144.480	1.100	9 @ 700 x 400	10	2.68 M ²	2.70 M ²
Forward Well } ...			1 @ 400 x 400			

State position of each freeing port ... { After Well of Q = 5m., 3.4m., 8.7m., 13.5m., 18m. & 30m.
(F. and A. position and height above deck edge) { Forward Well of Q = 2m., 5.4m., 8.9m. & 12.5m. — 130% above dk.

State whether the freeing ports are fitted with shutters, bars, or rails, and give particulars of such: — Plate shutters & two rails.

Additional area where sheer is less than standard.




© 2020
Lloyd's Register
Foundation

PARTICULARS OF PROTECTION TO OPENINGS, ETC.

HATCHWAYS ON FREEBOARD AND SUPERSTRUCTURE DECKS.									
FREEBOARD DECK									
→ Fcile Dk. → Poop Dk.									
Description of Hatchway	Nos 1, 2, 3 & 4	HOLD ESCAPE	COFFER DAM F. 435x500 A. 590x500	O.F. TANKS 3F. & 3A F. 455x500 A. 590x500	IN POOP SPACE	TO STORE BELOW F. DK.	TO POOP SPACE		
Dimensions of Hatchway	2360x1800	590x500			1075x1100	1350x1000	1100x1000		
COAMINGS	Height above Deck	400	360	360	360	3"	400	400	
	Thickness	7.5	7	7	7	ANGLE COAMING.	8	8	
	Stiffeners	✓	✓	✓	✓	✓	✓	✓	
	Brackets, Stays	✓	✓	✓	✓	✓	✓	✓	
HATCH BEAMS	Number								
	Spacing								
	Scantling and Sketch	✓	✓	✓	✓	✓	✓	✓	
	Bearing Surface								
FORE AND AFTERS	Number								
	Spacing								
	Unsupported Lengths								
	Scantling* and Sketch	✓	✓	✓	✓	✓	✓	✓	
HATCH COVERS	Bearing Surface								
	Material	W.T. Steel	do	do	do	Wood	N.T. Steel	do	
	Thickness	7.5	5	do	do	3"	8	do	
	How fitted	1 piece hinged	do	do	do	F & A. 3"	1 piece hinged	do.	
Spacing of Cleats	SEE SKETCH BELOW					NONE			
Number of Tarpaulins									
*Are wood fore and afters steel shod at all bearing surfaces? Are battens and wedges efficient and in good condition? Are tarpaulins in good condition and in accordance with rule requirements? Are lashings provided in accordance with rule requirements?									

Particulars of any special features:—

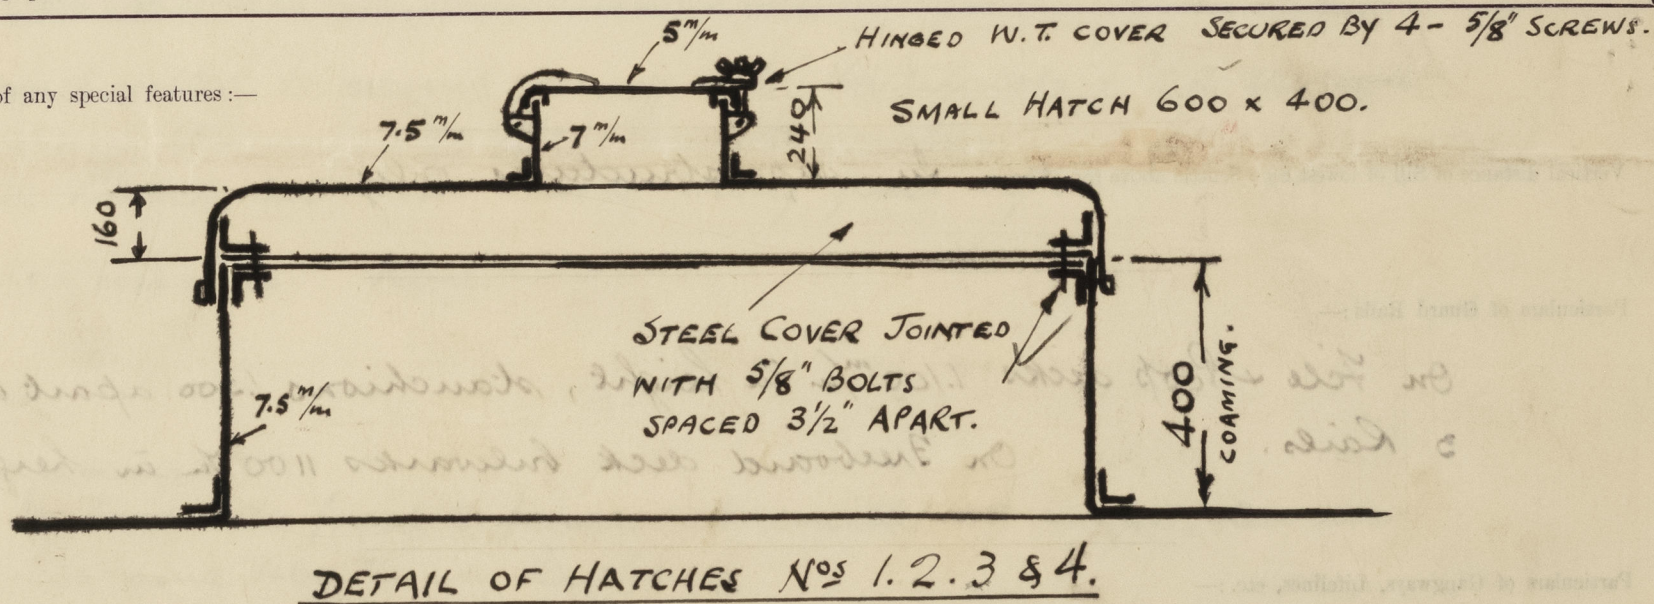

Endorsement at first survey and at surveys for renewal of Certificate:—

The fittings and appliances are in accordance with the particulars shown on this form (or as now modified) and are in good condition.