

Nos 1329-31-33-35

LAKE STEAMERS

—PROFILE & DECKS—

TO CLASS B. S* FOR SERVICE ON GREAT LAKES & RIVER


ST. LAWRENCE

SCALE 1/8" = 1 FT

SEP 1 1927




Approved
See later

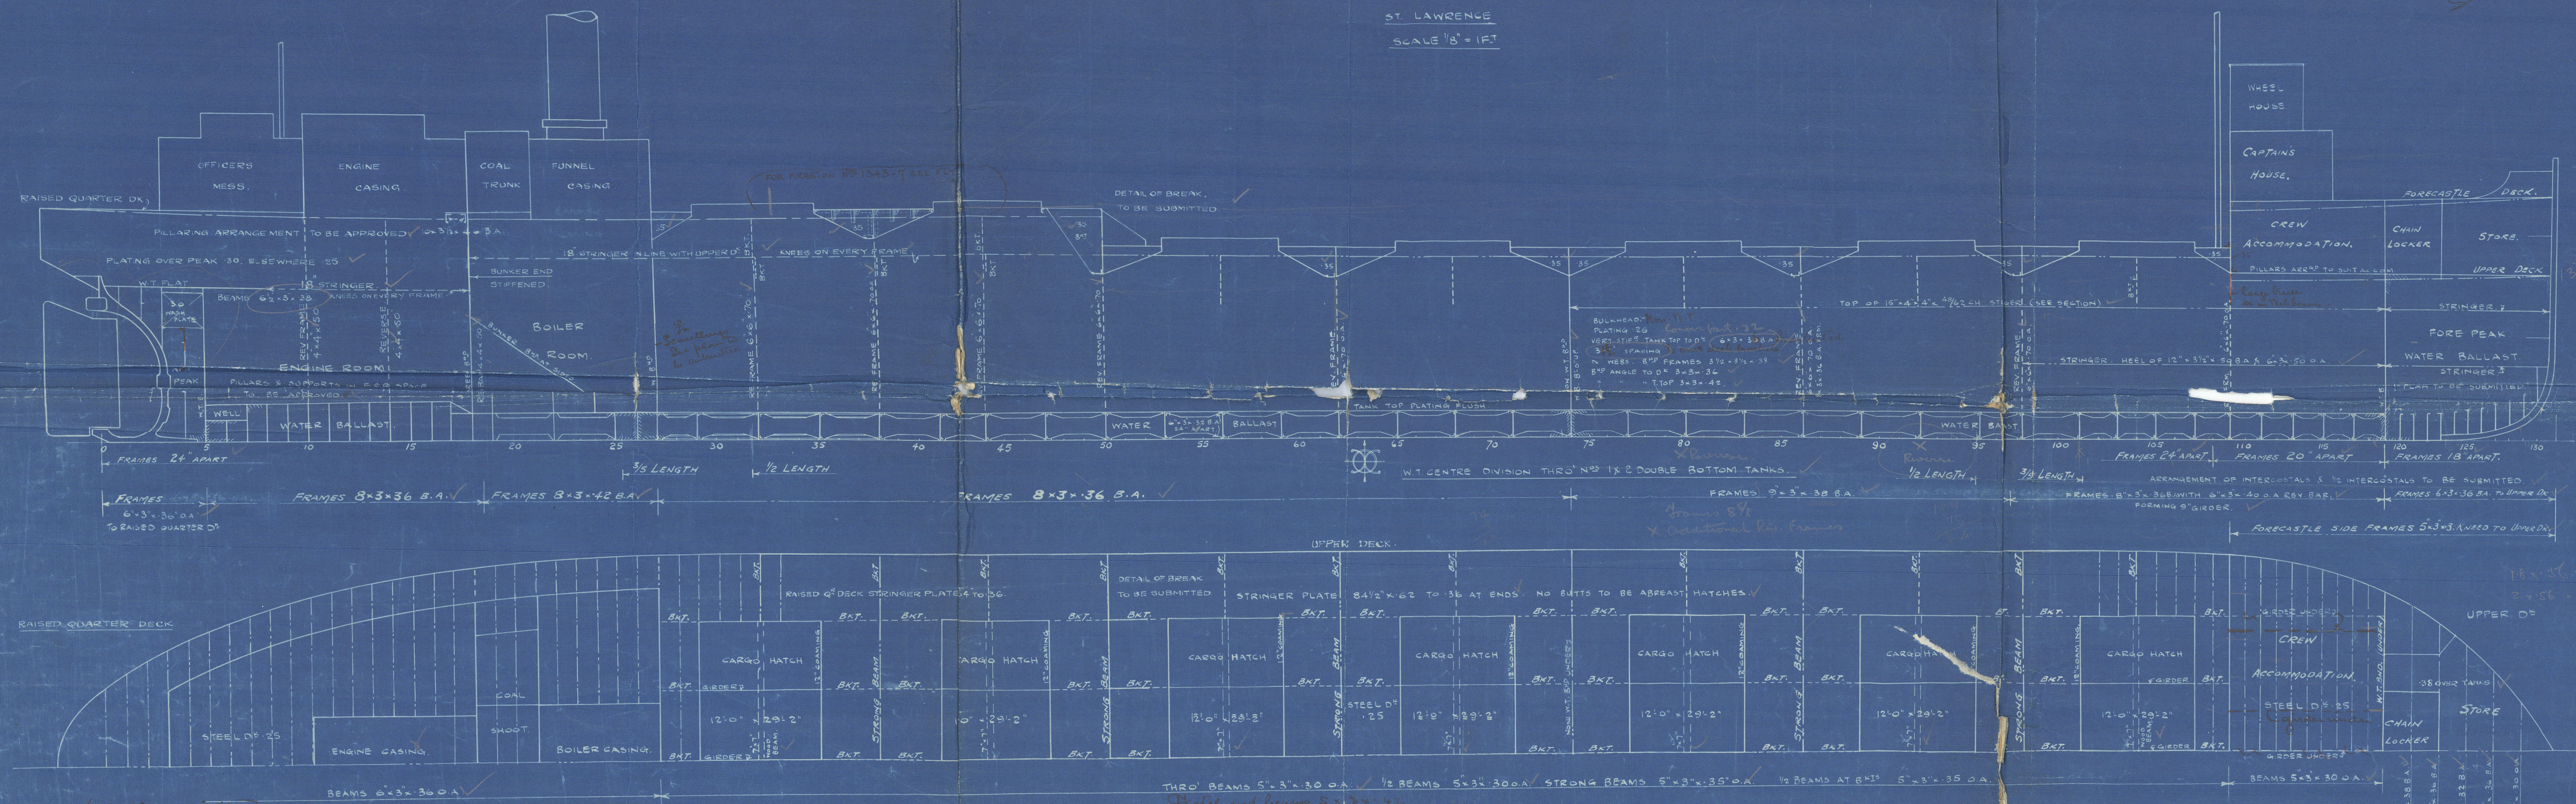

16 x 6 = 96
76 x 8 = 500
44 x 9 = 396
304 = 1652



18 x 56 = 1008 x 7.5 = 7560
2 x 56 = 112 x 7.5 = 840

Extra pillars fitted at
frames 2 & 5 & 5-4" E. side
See letter 7-10-27.

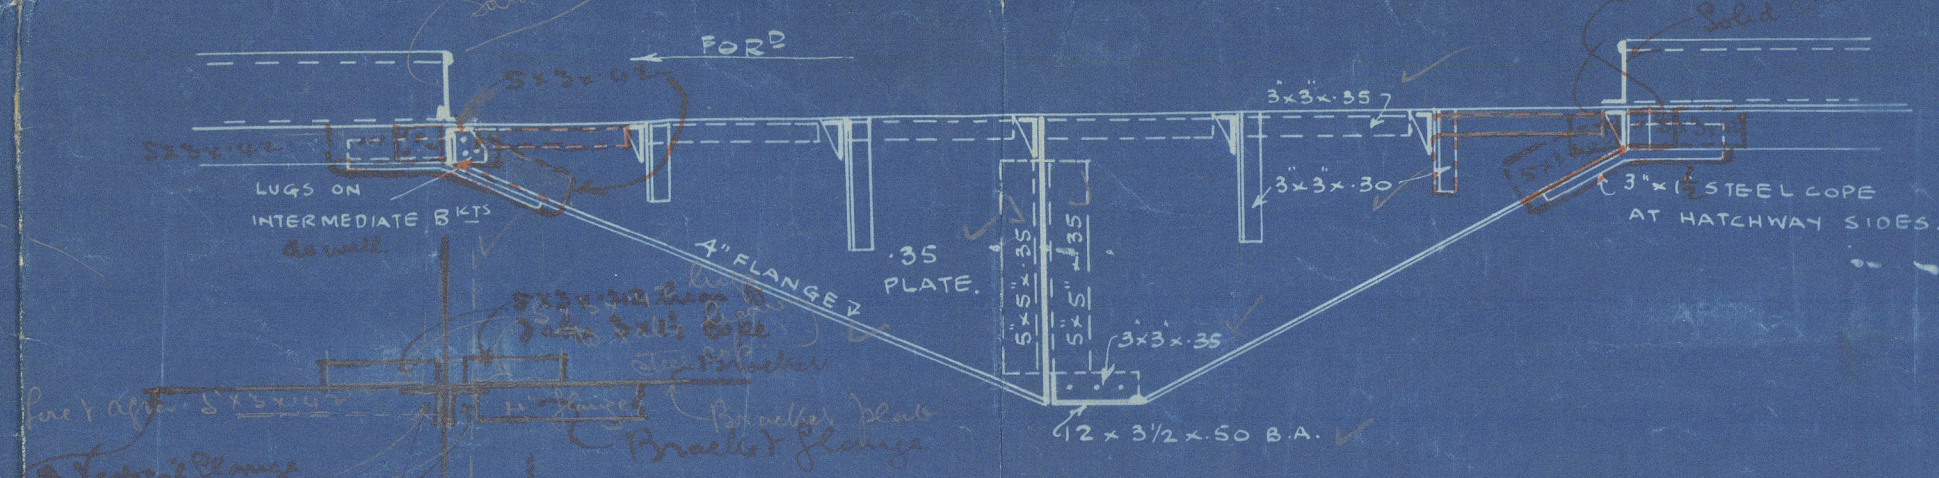

DETAIL OF BRACKETS BETWEEN HATCHES

SCALE 1/2" = 1 FOOT.

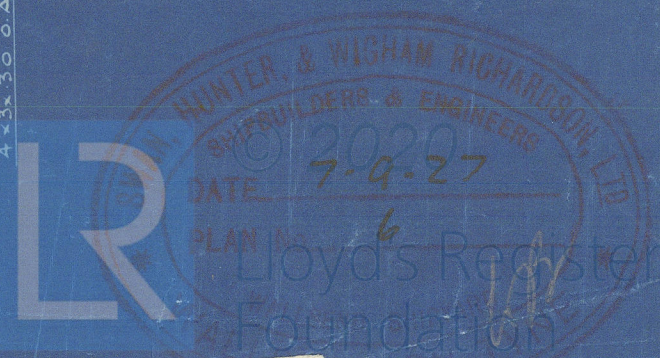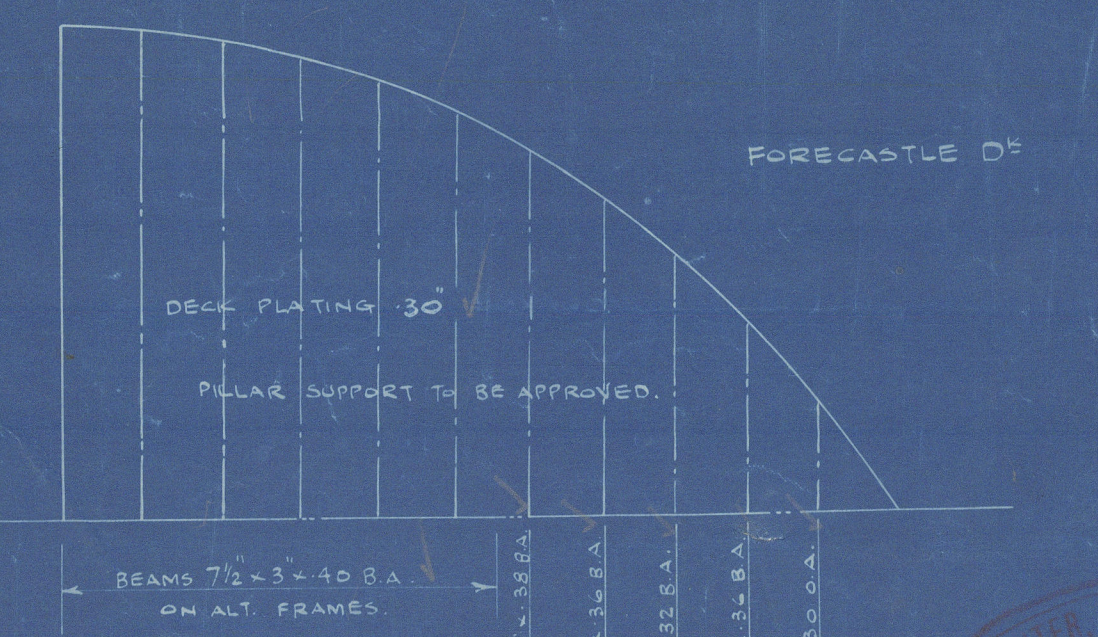

004512-004519-0198

Profile & Decks

Susan Hunter work

1329 - 31 - 33 - 35

Bad

16 x 36
27
20
12
8

17
3
4 x 4 x 4

004512-00519-0198



© 2020

Lloyd's Register
Foundation

Profile & Deck

Swan Hunter & W.R.

N^{os} 1329-31-3-5-7.

+ 1345-7 + 1282-90.

J. L. 30/11/27

9-9-27

" 7-3-28. for 1345-7-1282.

" 16-5-28 " 1290.

" 5-9-28 " 1365-7.

1329. "Cartierdoc" * * *

1331. "Savaldoc"

1333. "Mondoc"

1335. "Soreldoc"

1337. "Yroiedoc"

1345. "Novadoc" w/s 953

1347. "Newbrundoc"

1282. "Synneville" now "JOHN J. BOLAND JUN."

1290. "Scott Misener"

1365. Delaware

1367. Cheryne

1369. John A. McKeller

1371. W. H. Houston

1373. Ralph Gelchrist

1375. Joseph G. Burke

PLANS TRANSFERRED
TO SISTER VESSEL
SORELDOC

004512-004519-0198

© 2020

Lloyd's Register
Foundation