




23 OCT 1928

Approved *[Signature]*  
30 10 28


N<sup>o</sup> 1869-71-3-5 SHIPS  
PROFILE & DECKS.

DIMENSIONS: - 253'-0" B.P. x 43'-4" E.X. x 20'-0" D.M.B.  
TO CLASS B.S\* FOR SERVICE ON GREAT LAKES &


RIVER ST. LAWRENCE.  
SCALE 1/8" = 1 FT.

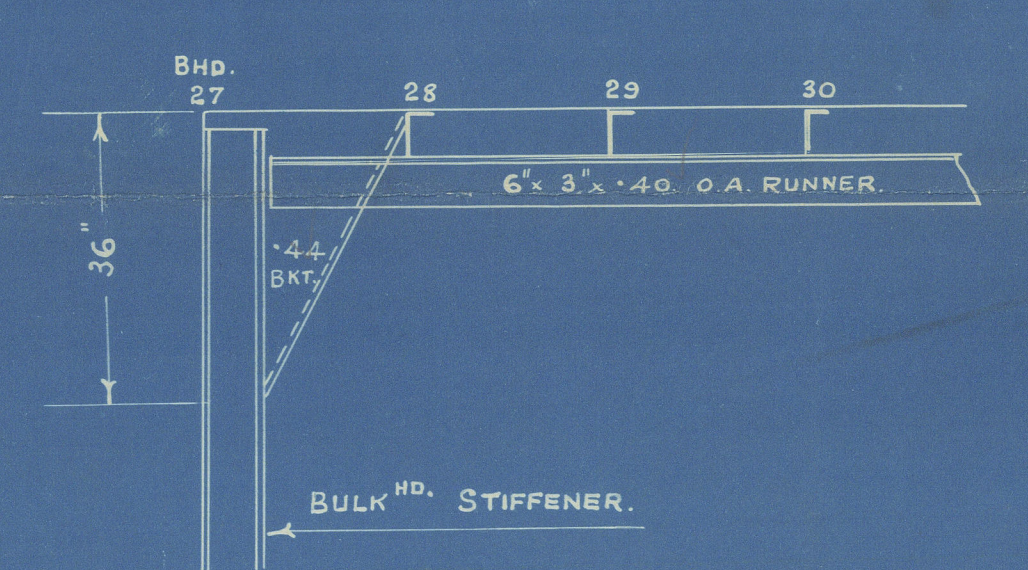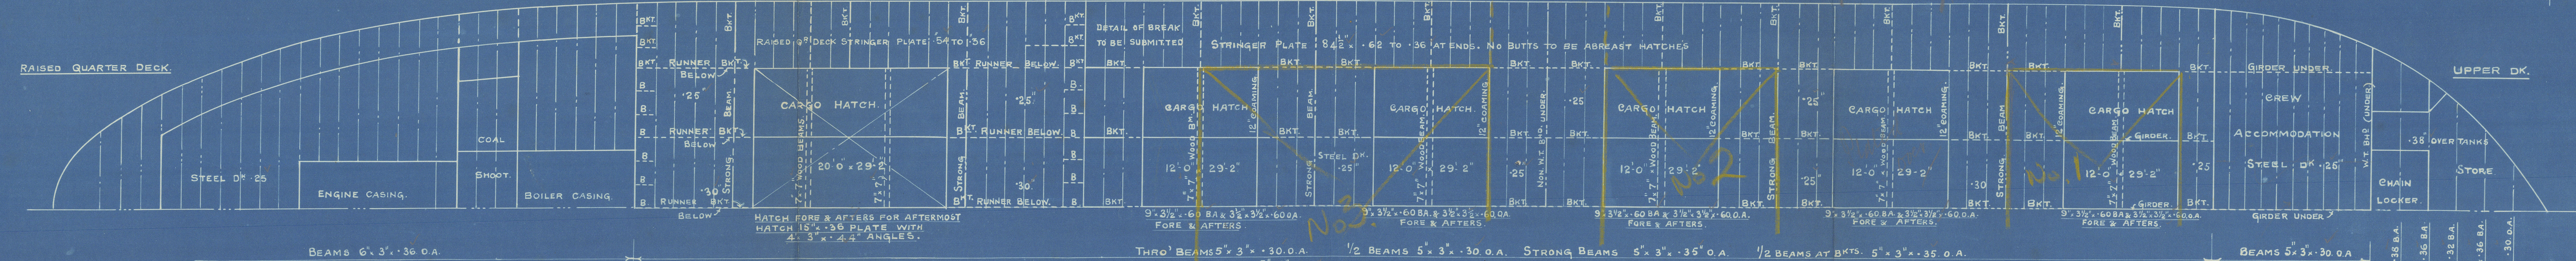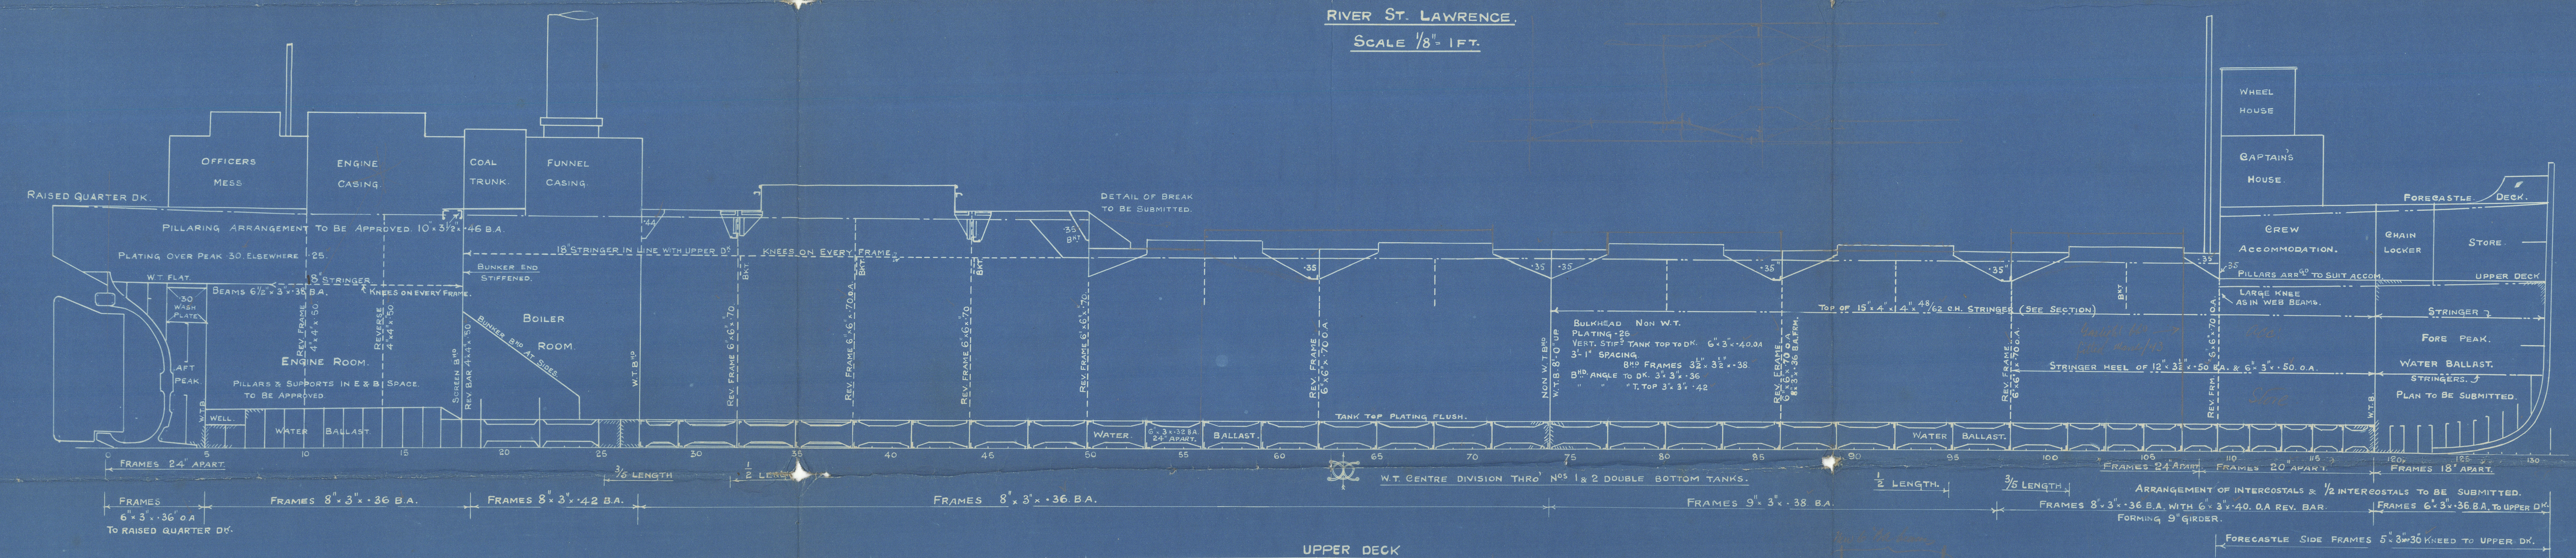

DETAIL OF RUNNER & CONNECTION  
UNDER AFTERMOST HATCH.  
SCALE 1/2" = 1 FOOT.

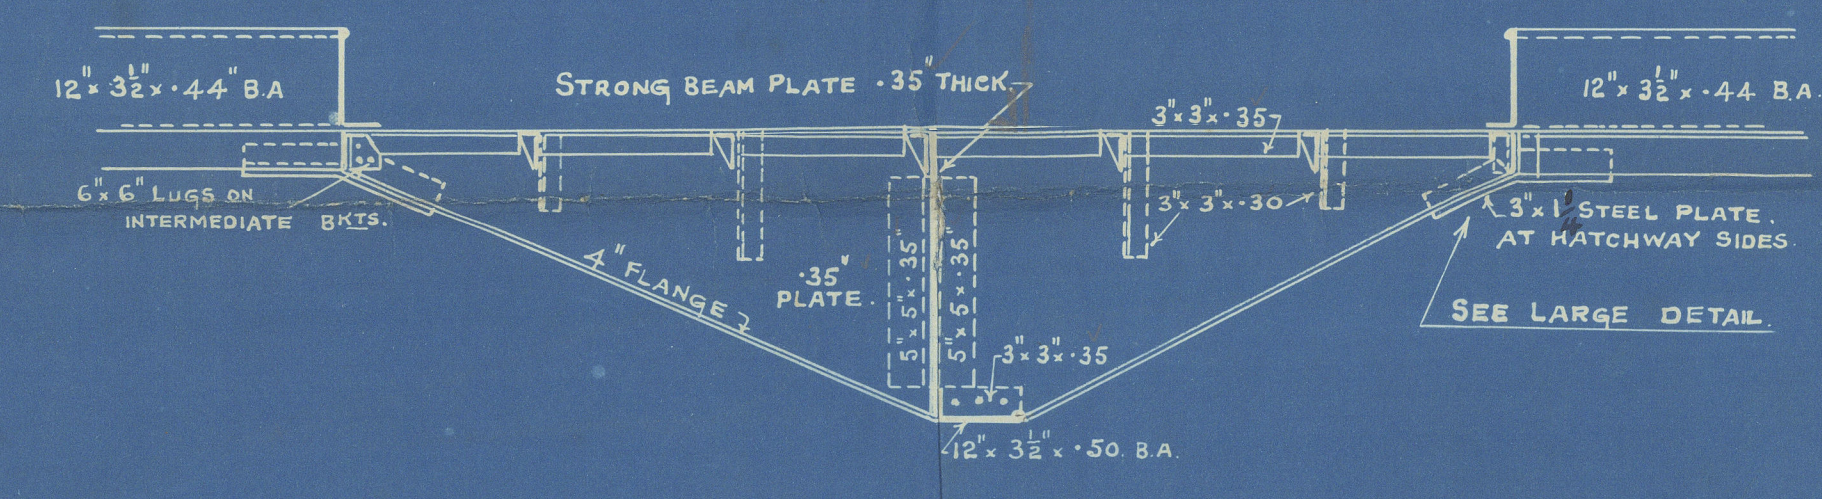

DETAIL OF BRACKETS BETWEEN HATCHES.  
SCALE 1/2" = 1 FOOT.

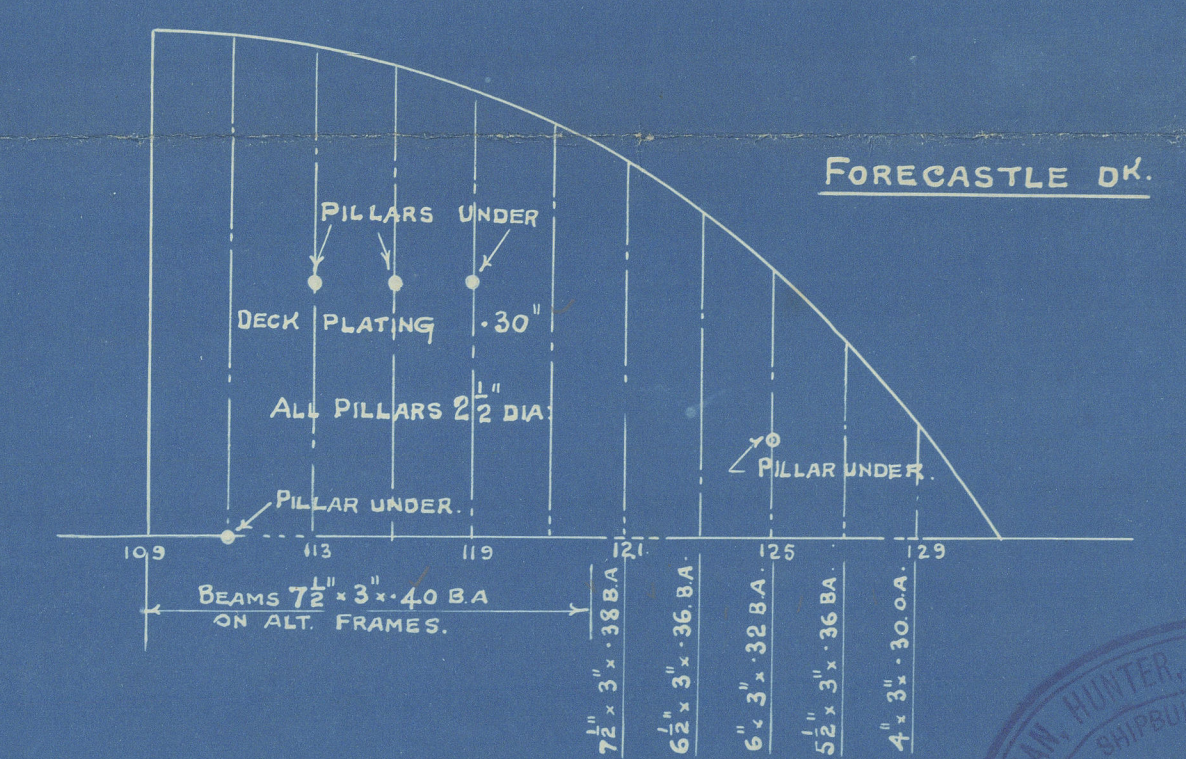

DATE 23-10-28  
PLAN No. 20  
WALLSEND-ON-TYNE

CONSIDERED BY THE  
204519-0207

3  
13/6 - 40  
142

5

Profile Deck.

Swan Hunter & W.R.

N<sup>os</sup> 1369. 1371. 3. 5.

*Manicouagan* \* 30. 10. 28.  
*ex Empire Nother*  
N/N Manitoulin

1369. "John A. McKeller".

1371. "W. A. Houston".

1373. "Ralph Gilchrist".

1375. "Joseph P. Burke".

DELAWARE  
CHEYENNE

PLANS TRANSFERRED  
TO SISTER VESSEL

Soreldoe ★

Profile Decks

Swan Hunter 1369-71-3-5

By



© 2020

Lloyd's Register  
Foundation

004512-0/04519-0207