


PROPOSED ARRANGEMENT OF SAMSON POST, DERRICK & WINCH.

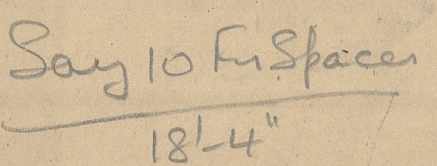


INNY'S ENGINEERING WORKS LTD.
MADRAS.
GENERAL AGENT OF PROFILE
OSTOVER
SUDHRA TRADING S. BEZWADA.
DR. GUR D. E. W. 13/5 B
RAVVI BY K. DESHNER. N. SHIP
CHECKED BY: HATIAK. 72/1131

"Leelavathi" ★

General av. of profile.

RECORDS DEPT
LONDON

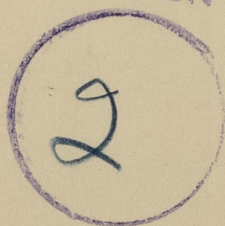

© 2020

Lloyd's Register
Foundation

004527-004533-0130