


BHD. STIFFENERS 135x75x1/4" B.A. SPACED 24"

100x65x10 1/4" B.A. SPACED 710 1/4"

UPPER DECK

HATCH N° 2

PLAN

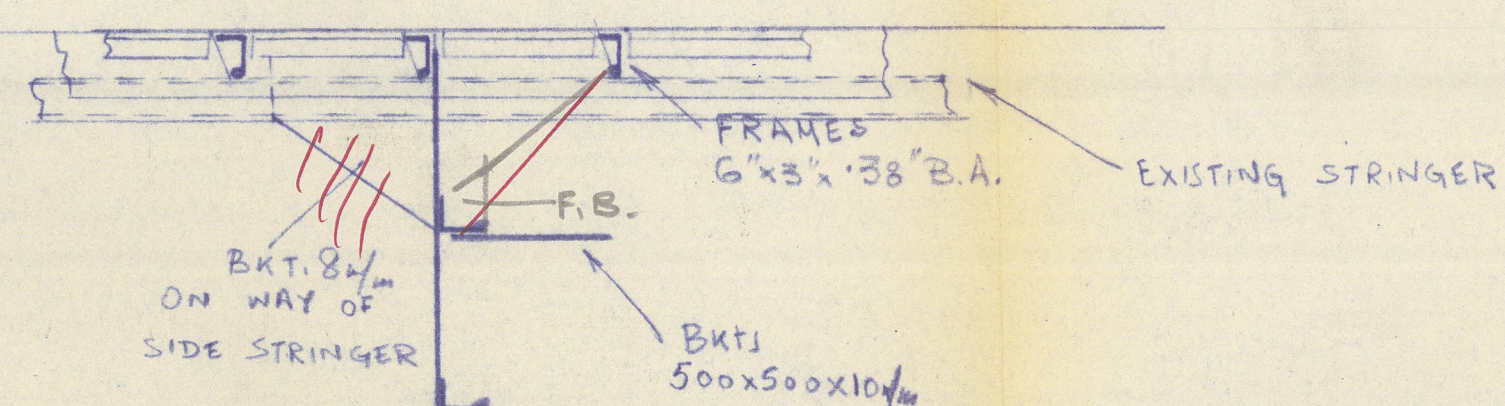

BHD STIFFENERS 150x75x10 1/4" B.A. SPACED 760 1/4"

R. FR. 7 1/2"x8 1/4" TO EACH STIFFENER

SECOND DECK

HATCH N° 2

TRANSVERSE SECTION

BOUNDARY ANGLE 8"x40"x1/2"

BHD. STIFFENERS 100x65x10 1/4" SPACED 710 1/4"

135x75x1/4" B.A. BKT TOP & BOTTOM SPACED 710 1/4"

BHD. STIFFENERS 135x75x1/4" B.A. BKT TOP & BOTTOM SPACED 760 1/4"

150x75x10 1/4" B.A. SPACED 760 1/4"

WITH REVERSE FR. 7 1/2"x8 1/4" TO EACH STIFFENER

M/S "MANDO"


CONSTRUCTION OF TRANSVERSE BHD. TO SEPARATE N° 1 & 2 HOLD.

SCALE 1:25

AS FITTED IN RED. ← COLOUR USED BY OWNERS

NOTE:- THE WHOLE WORK TO BE CARRIED OUT BY E.W. IN ACCORDANCE TO THE RULES.

RIVETTED CONSTRUCTION REVERSE FRs WELDED TO MAIN STIFFENERS.

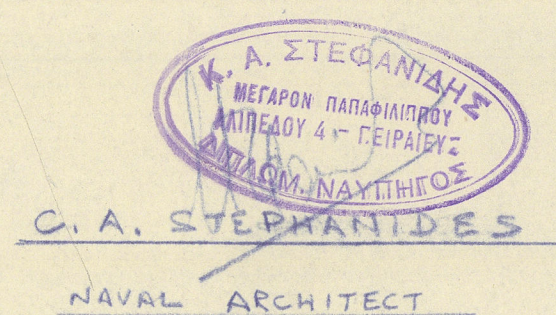

PIRAEUS JUNE 1960