


12 DEC 1944

DIMS. 500'-0" B.P. x 67'-0" B. M^{LD} x 35'-9" D M^{LD} TO UPPER DECK.
SCALE: - 1/16" = 1 FOOT.

SWAN, HUNTER, & WIGHAM RICHARDSON LTD.
SHIPBUILDERS & ENGINEERS
No 3.
DATE 1/12/44
WALLSEND SHIPYARD
WALLSEND-ON-TYNE

FORE END ARRANGEMENTS ^{+ scarping} TO BE SUBMITTED.

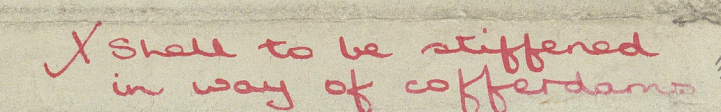

Poop front to be kept as far forward as practicable

UPPER DECK STRINGER PLATE 75" x 87" FOR 1/2 L TO 48" x 46" AT ENDS
INCREASED AT POOP FRONT & BRIDGE END TO 1-06" THICK
STRINGER ANGLE 7"x7" x 87" FOR 1/2 L TO 3 1/2" x 3 1/2" x 46" AT ENDS

HATCH CORNERS TO BE ROUNDED

* COMPENSATION TO BE FITTED WHERE MORE THAN TWO OPENINGS,
EACH 3'-0" WIDE ARE FITTED IN WIDTH OF DECK.

UPPER DECK LONG^{LS} 9"x3½" x .375 B.A. #30" APART IN CENTRE TANKS 32" APART IN WING TANKS.

12.12.44

SWAN HUNTER & WIGHAM
RICHARDSON LTD.

SHIP No. 1743

"Regent Tiger" *
NEWCASTLE ON TYNE

Report No. 104060

Profile & Decks

*Lewkama
Capulet X.*



RETAIN

004534-004540-0067



© 2020

Lloyd's Register
Foundation