
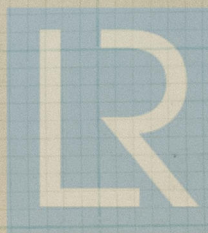


DELFTDIJK SHEERS

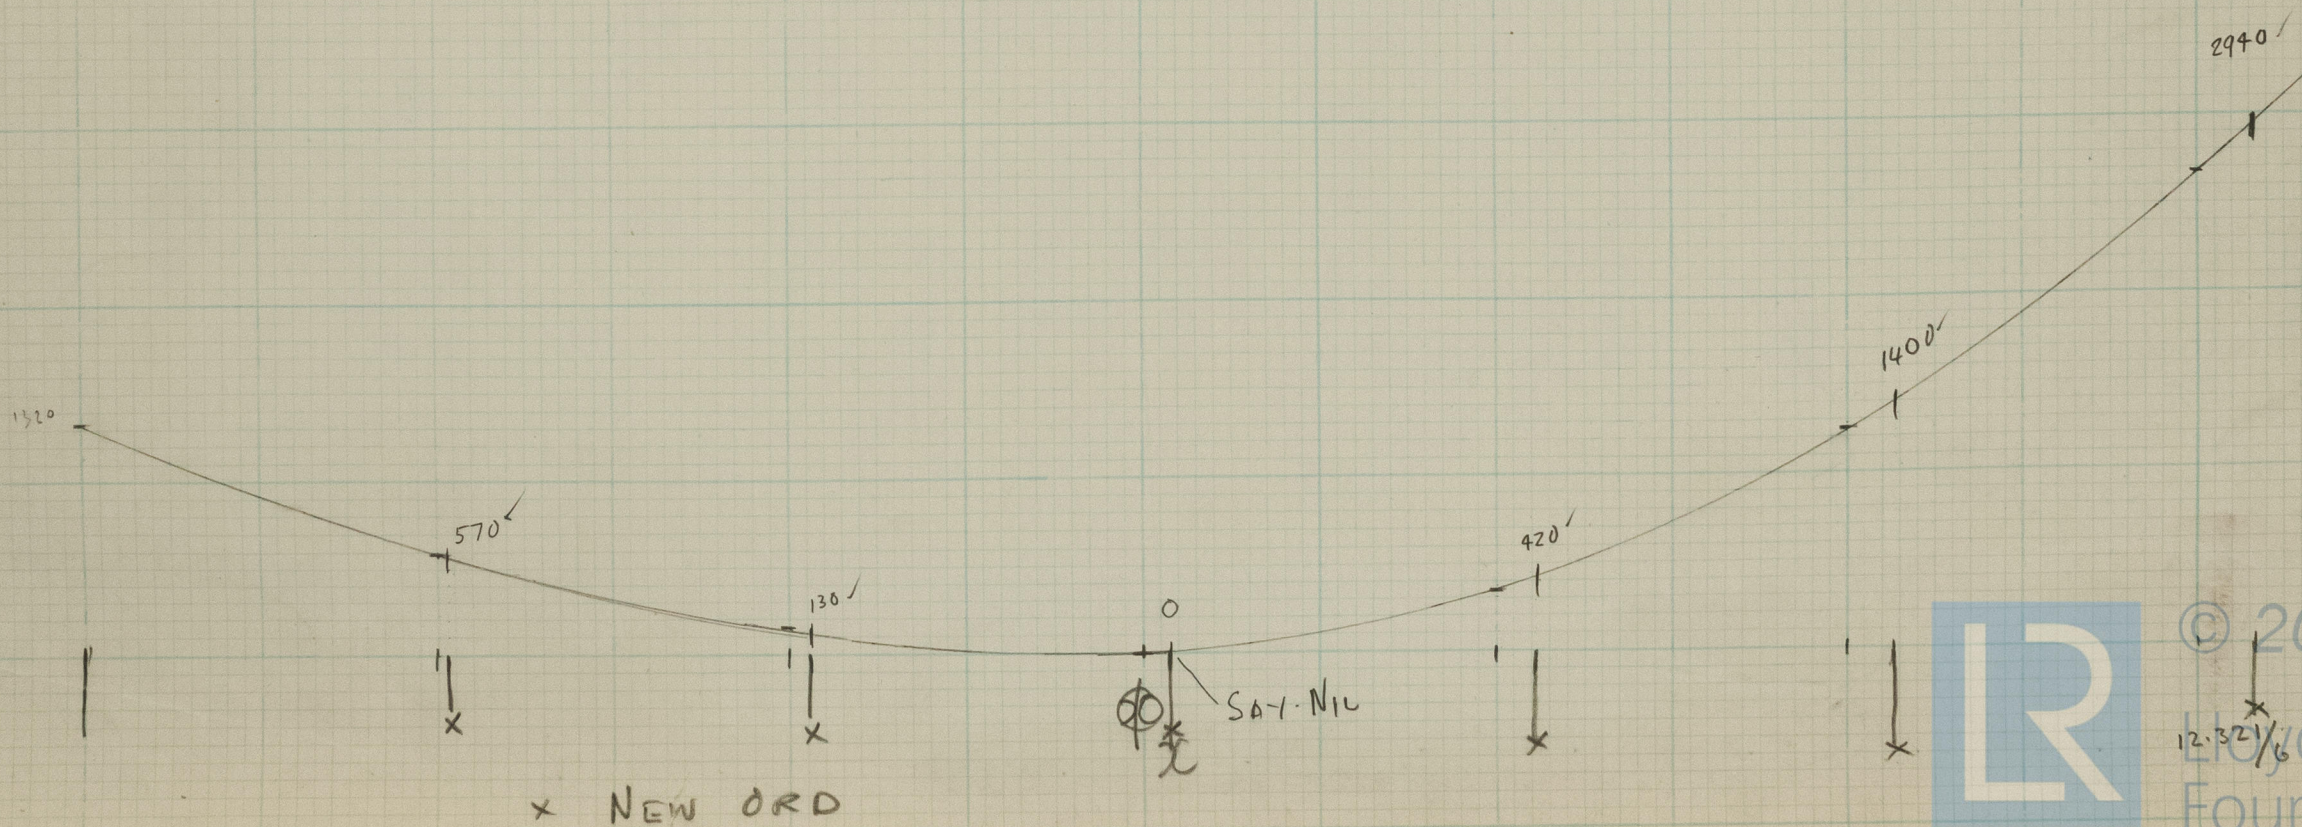

© 2020

Lloyd's Register
Foundation

Lloyd's Register of Shipping