

11-1-16
10-3-16
18/4/16
3-5-16



DB 150: Steel Twin Screw Steamer for the:
„Stoomvaart M^t Nederland."

Midship Section.

Scale 1/2" = 1'-0"

Length between posts 402'-0"
Breadth of beam 30'-0"
105.73 x 96.46

Freeboard of stem 20'-0"
452
20.97
Buy = 502.93
167.502.81
452.702.81

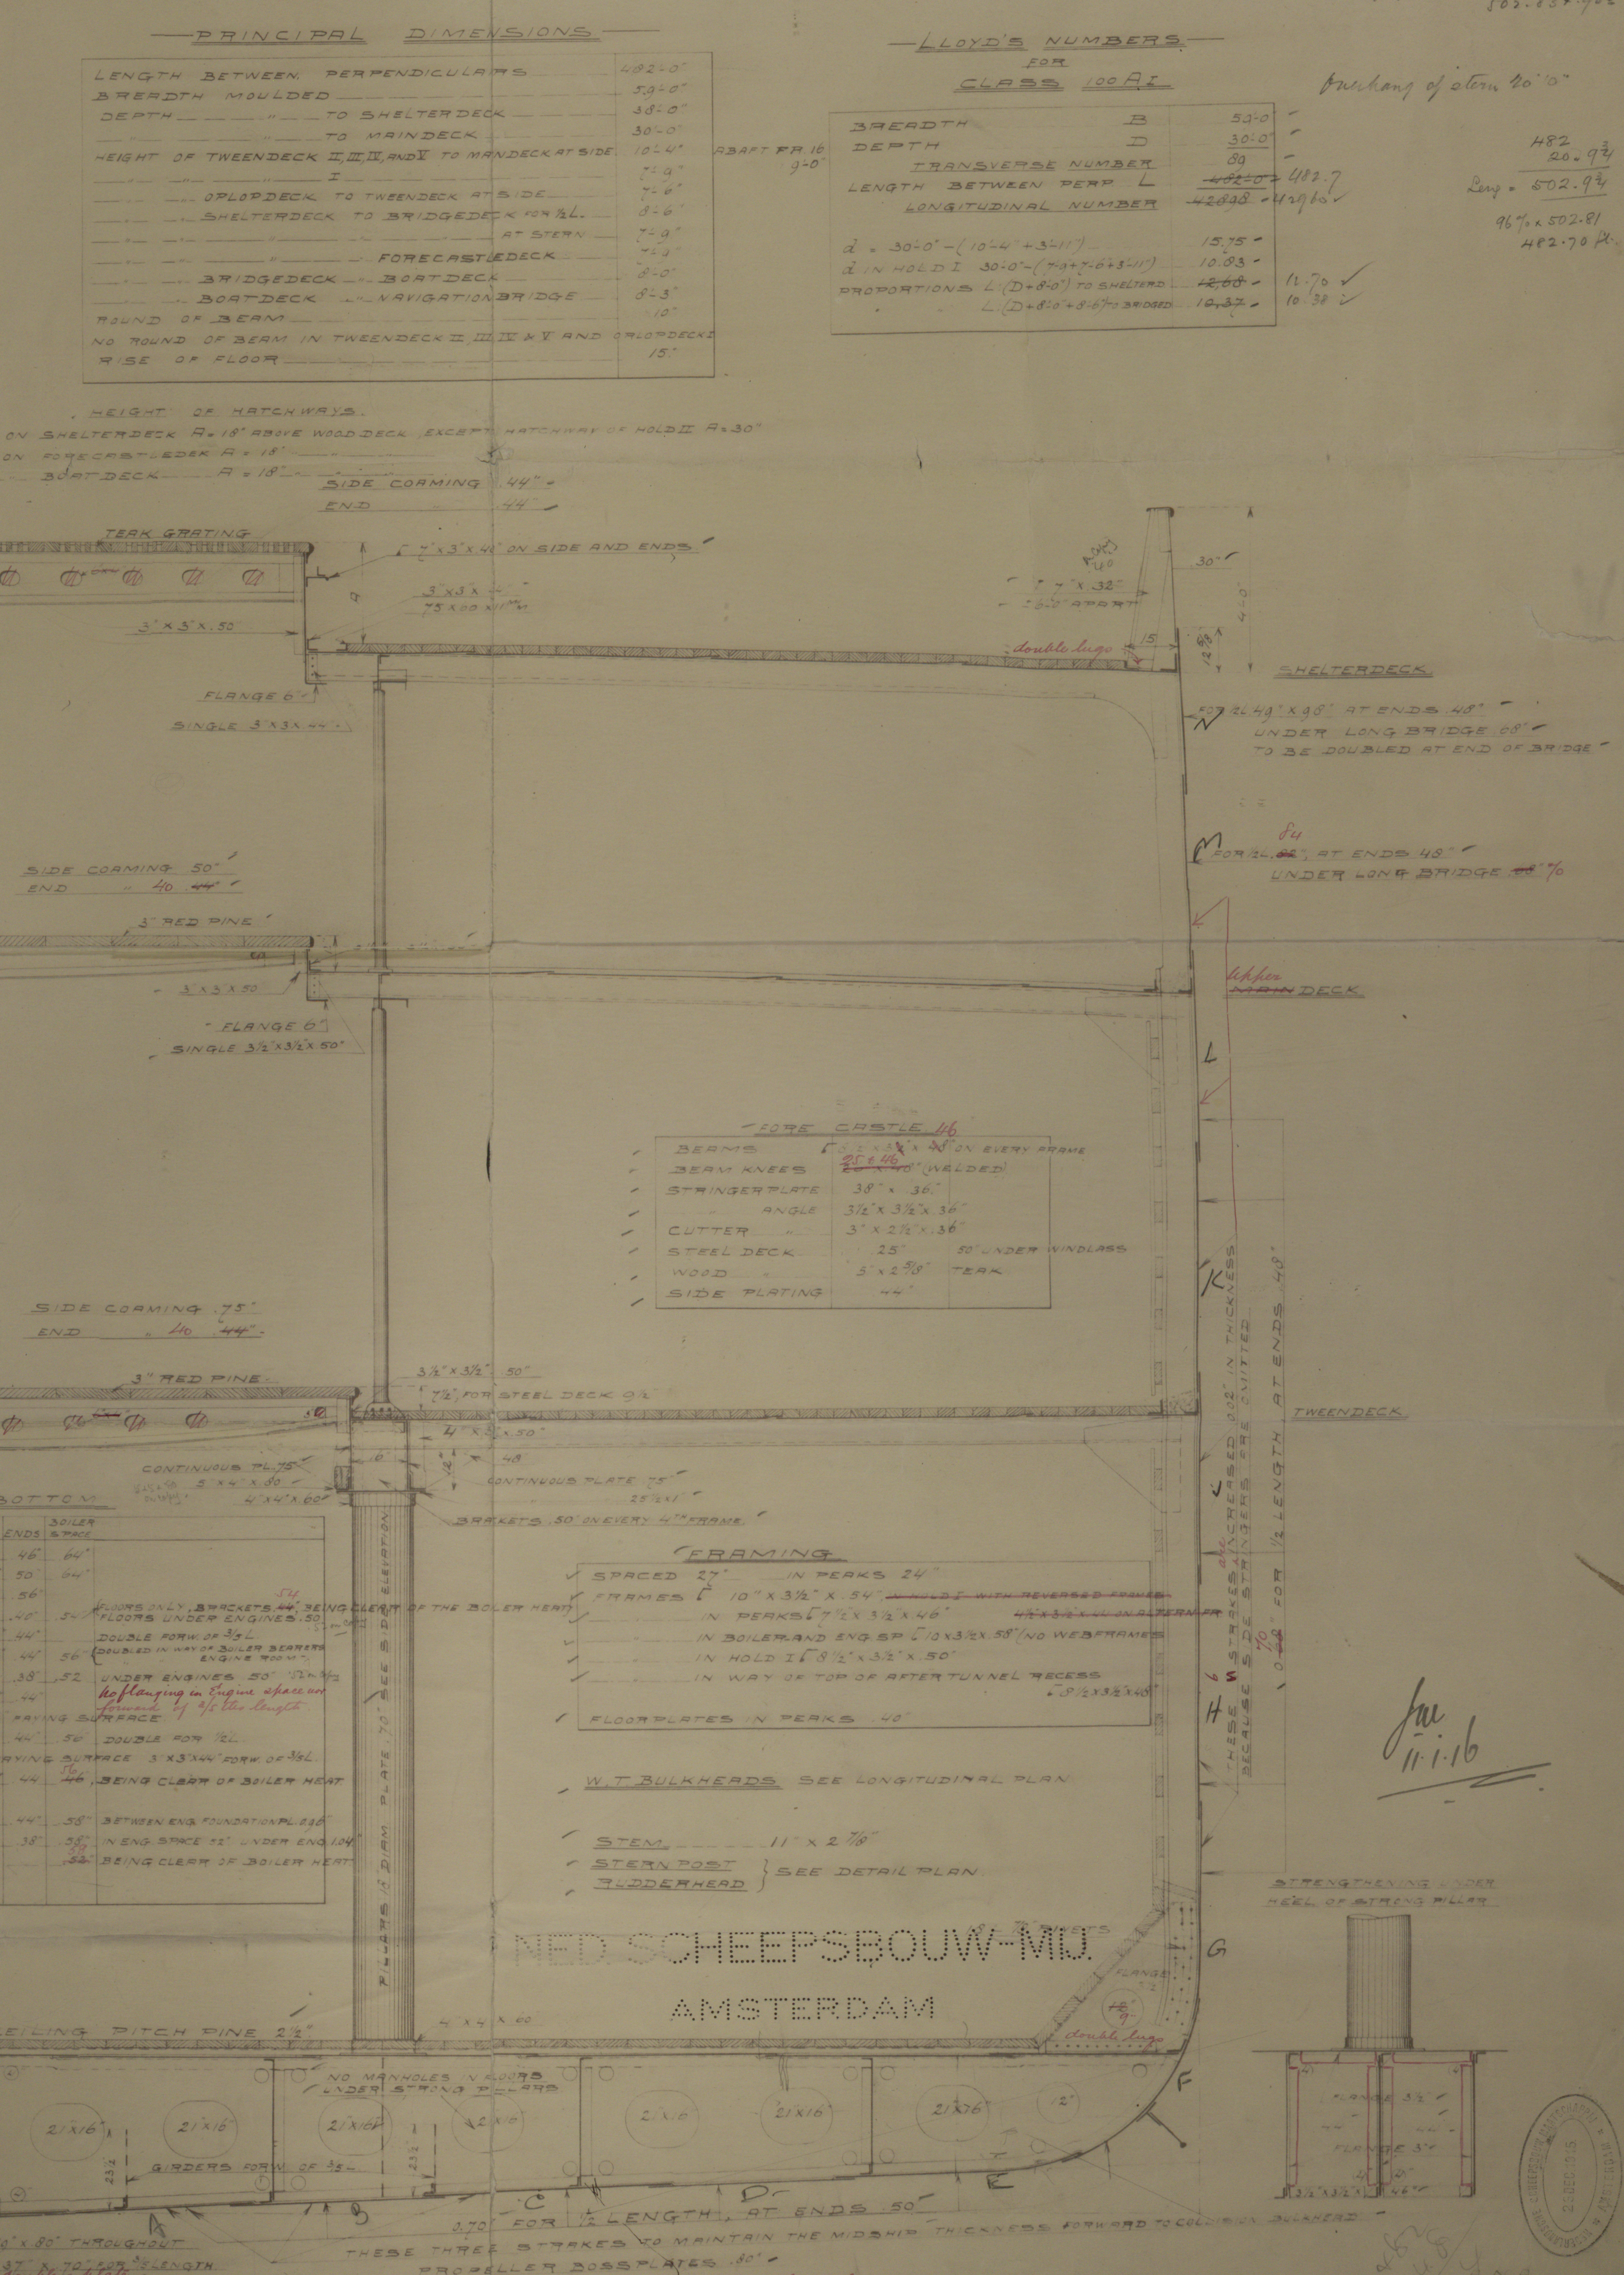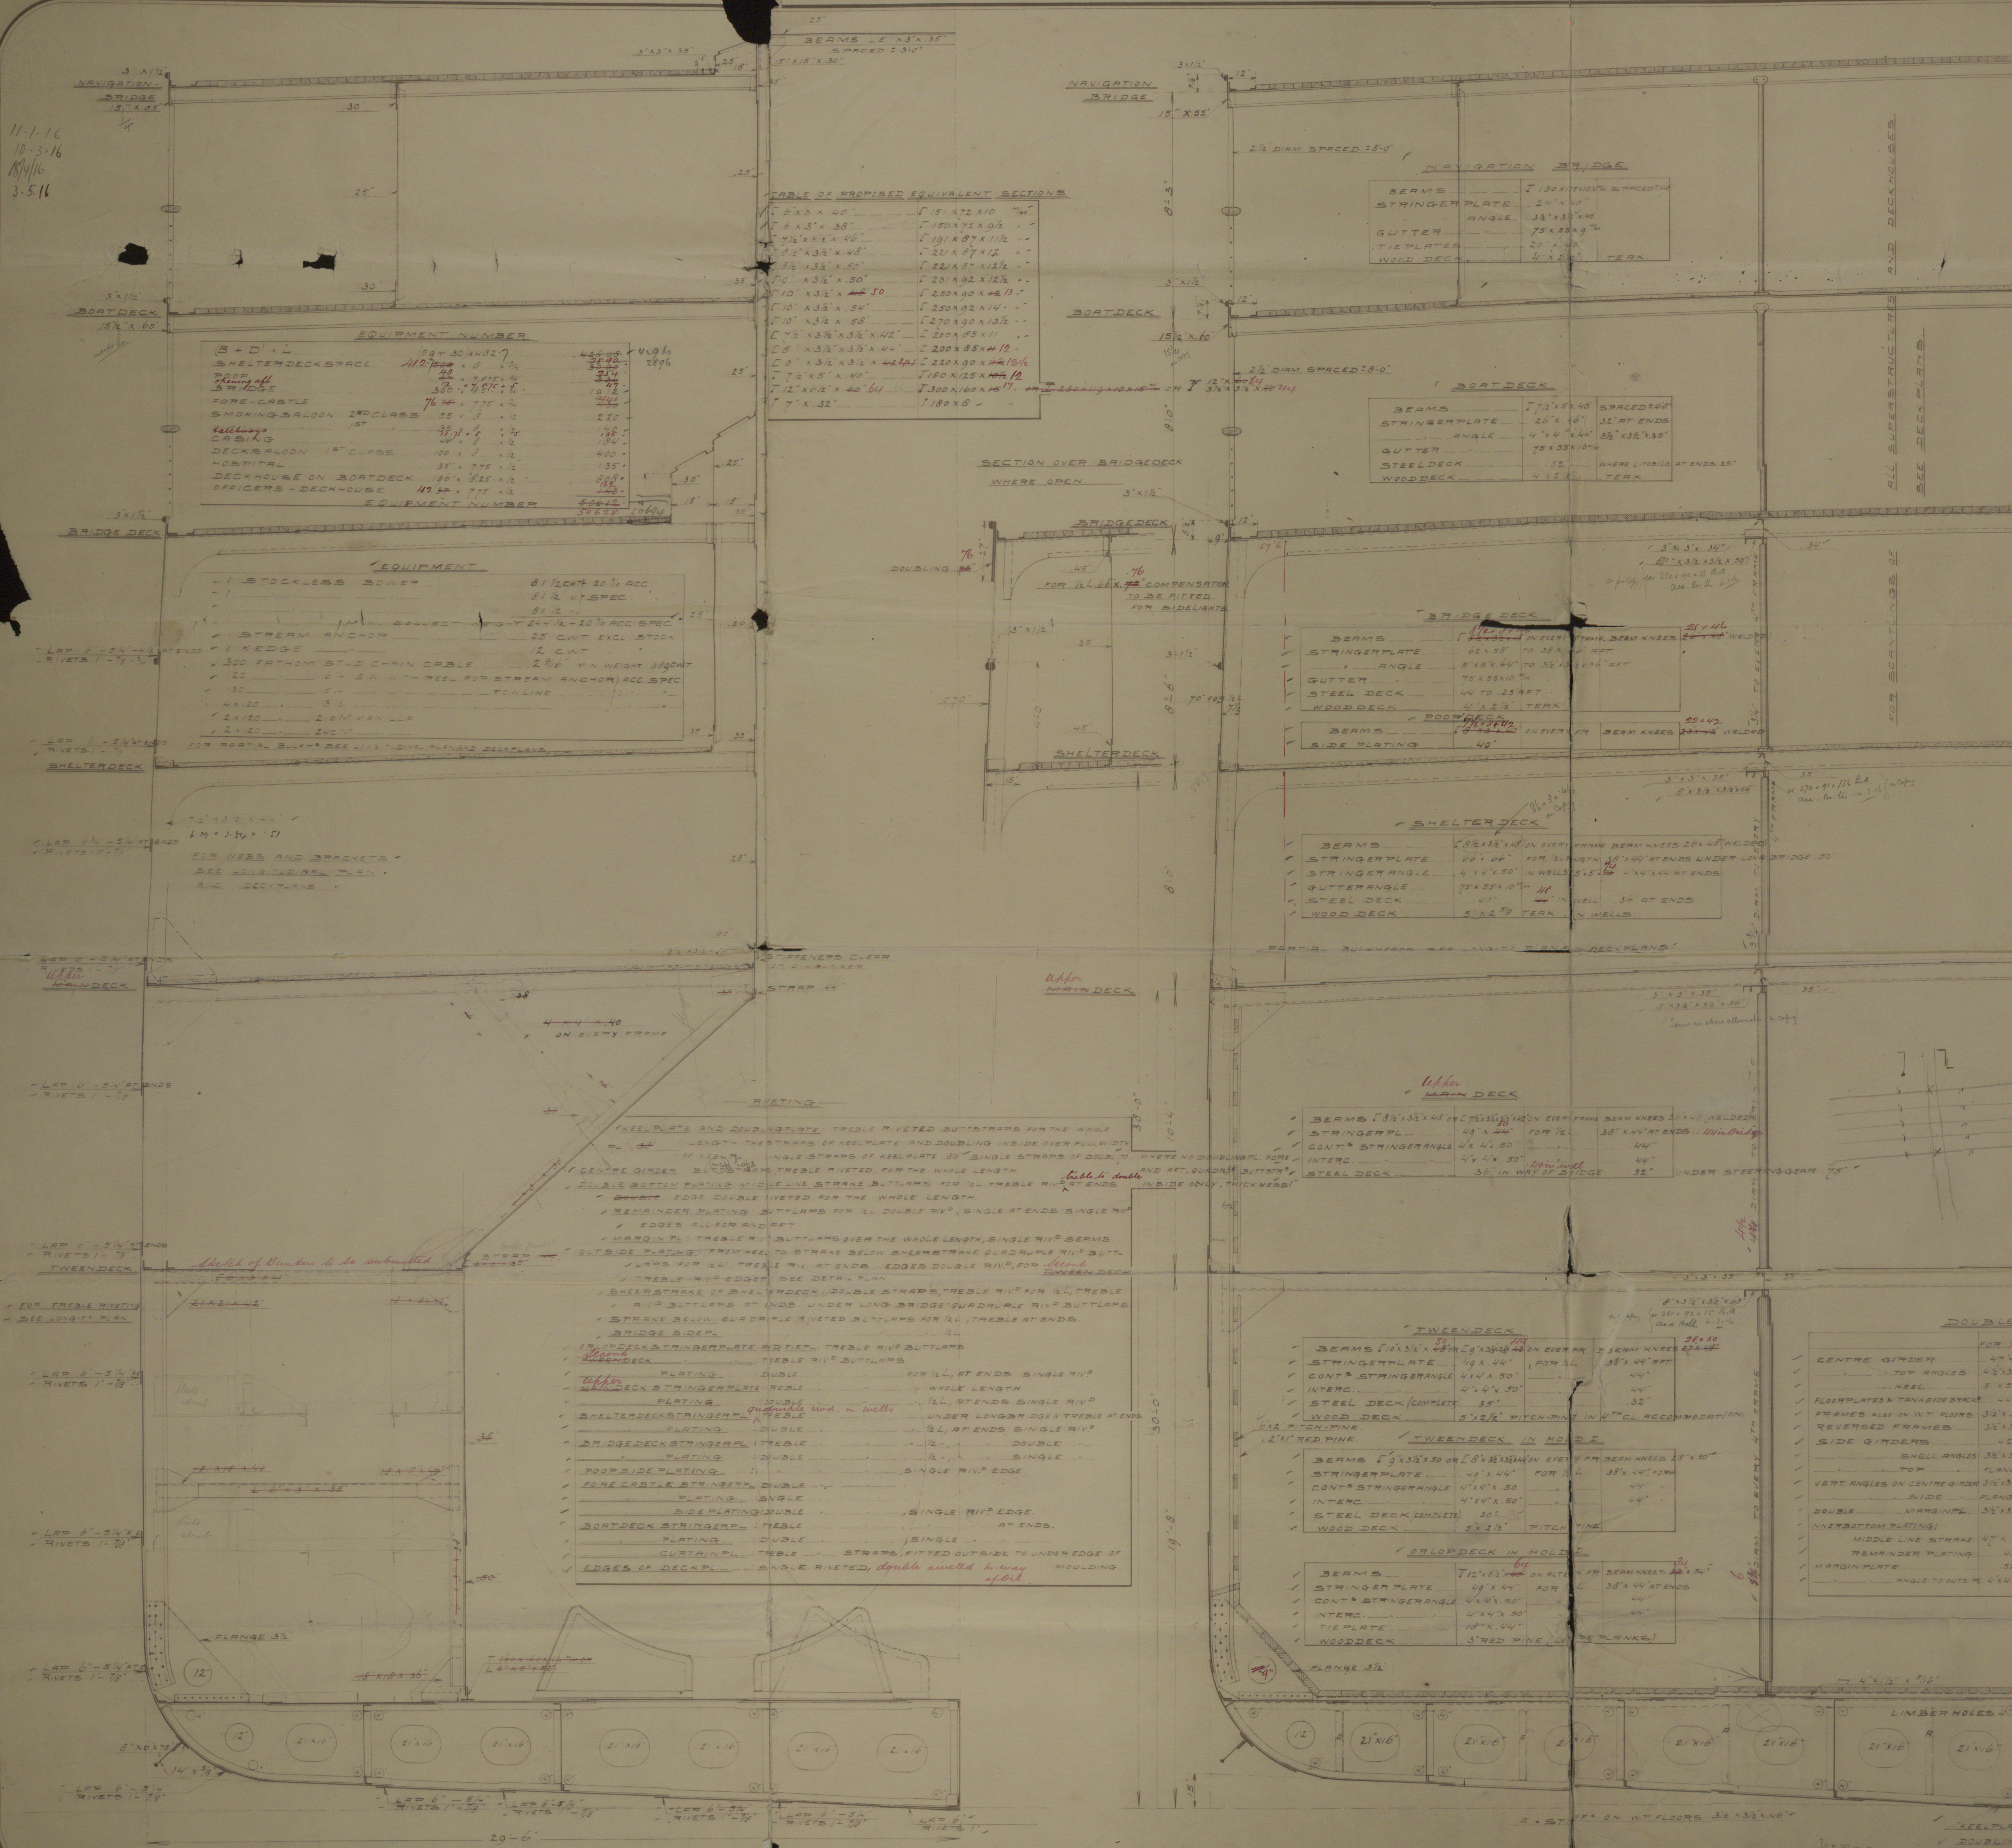

NED SCHEEPSBOUW-MIJ
AMSTERDAM


Jan 11-16

plan 1.

Ned Scheepsbouw Maat?


S.S. N^o 150.

Midship Section



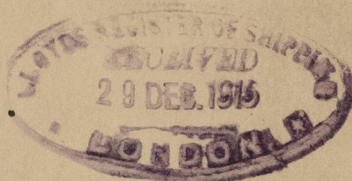


S.S. Johan de Witt

Ams 8141

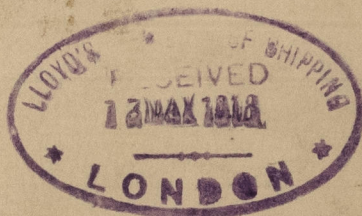

Neptunia

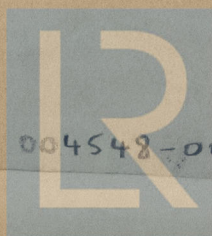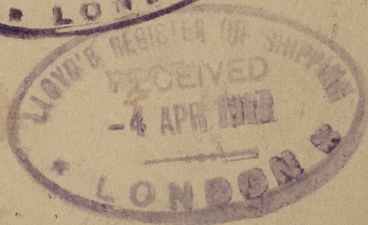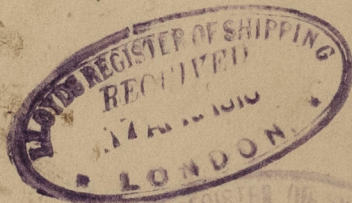

© 2020

004548-004555-0187

Lloyd's Register
Foundation