
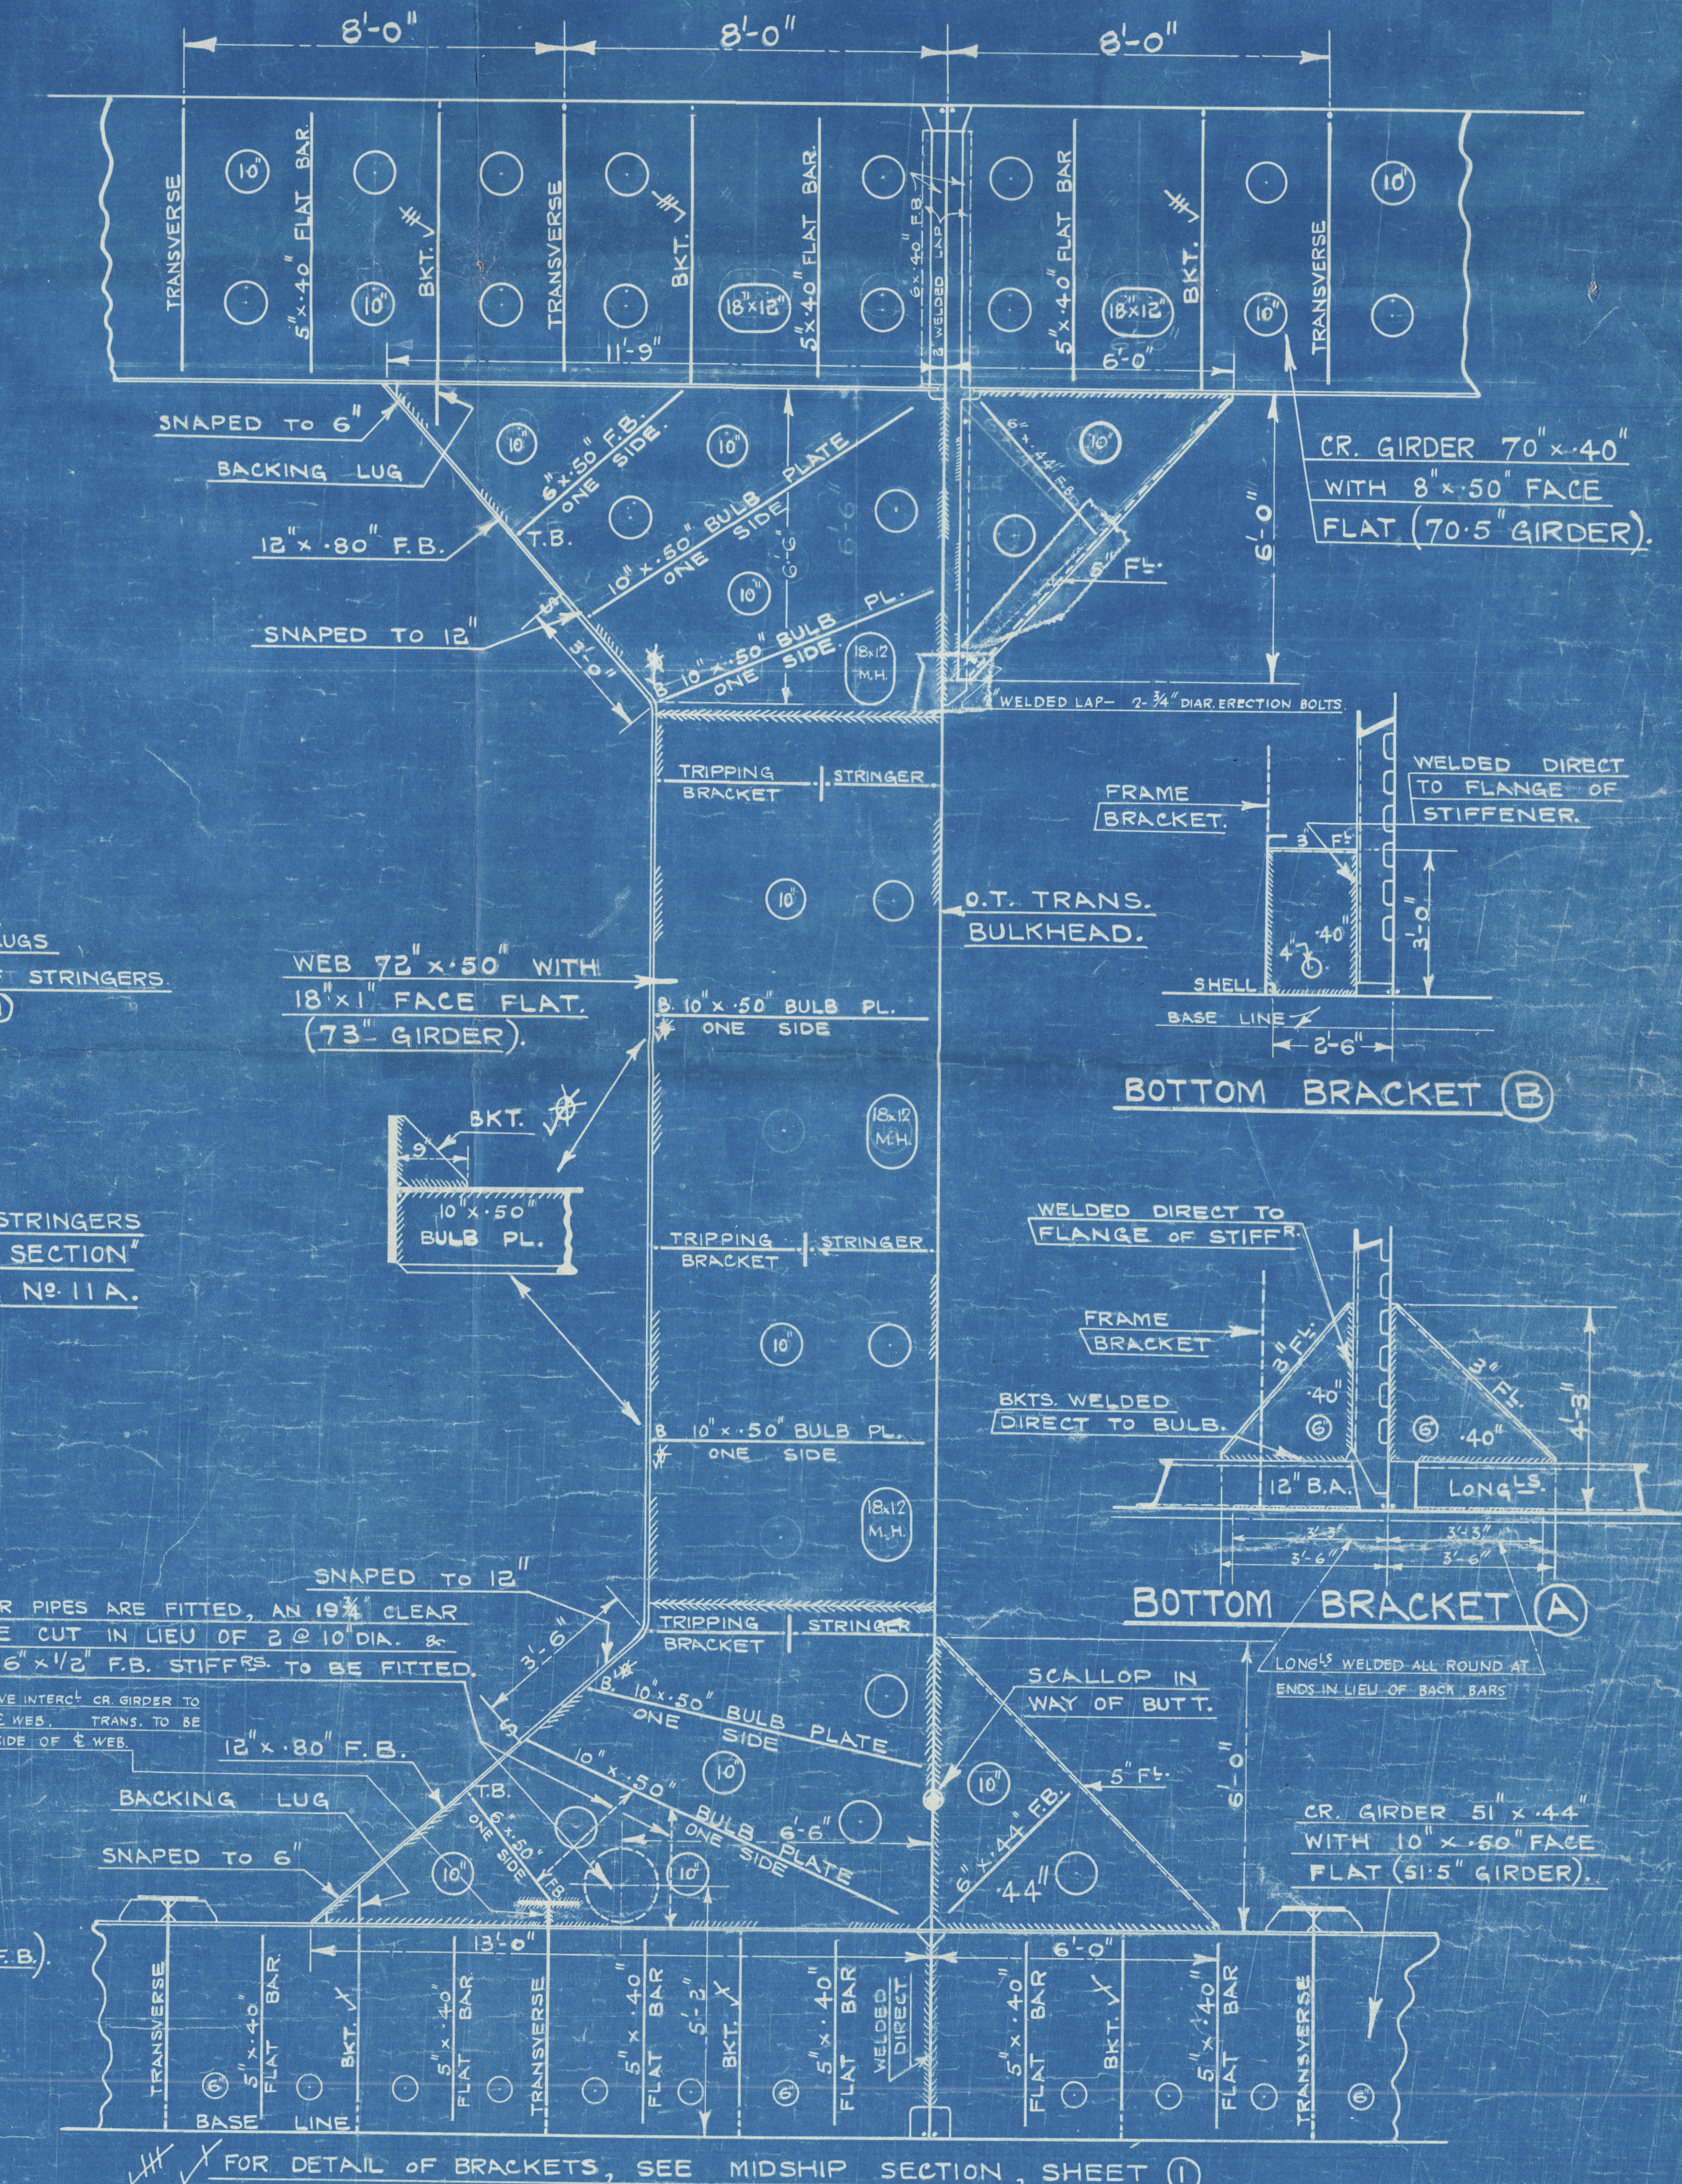
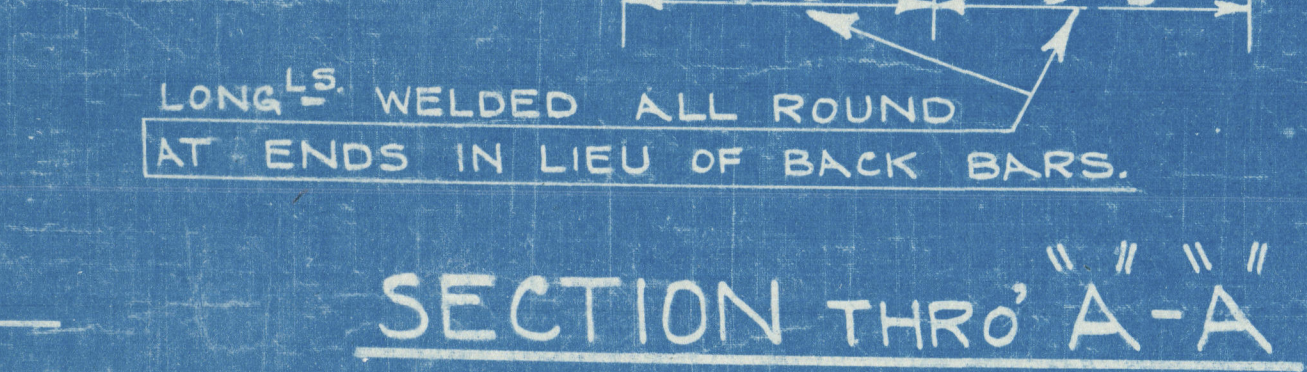
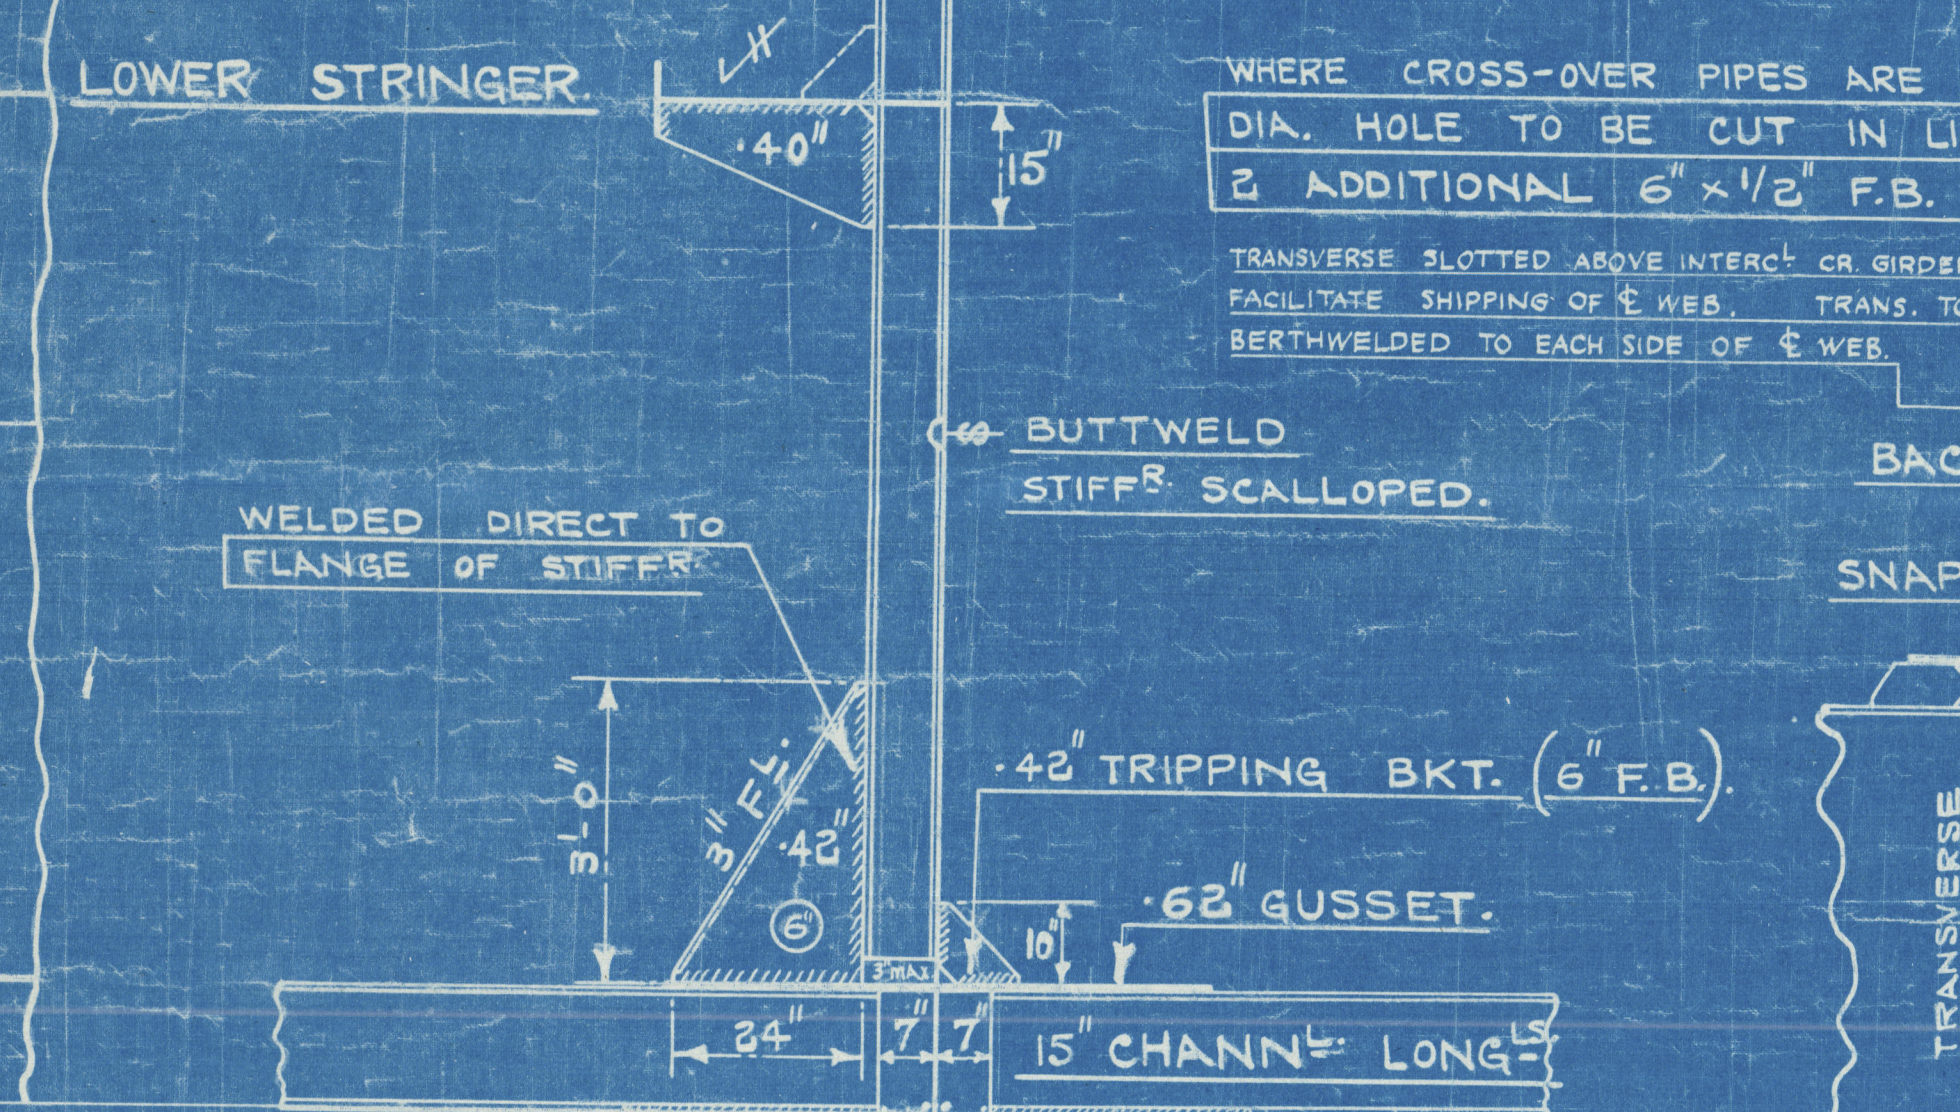
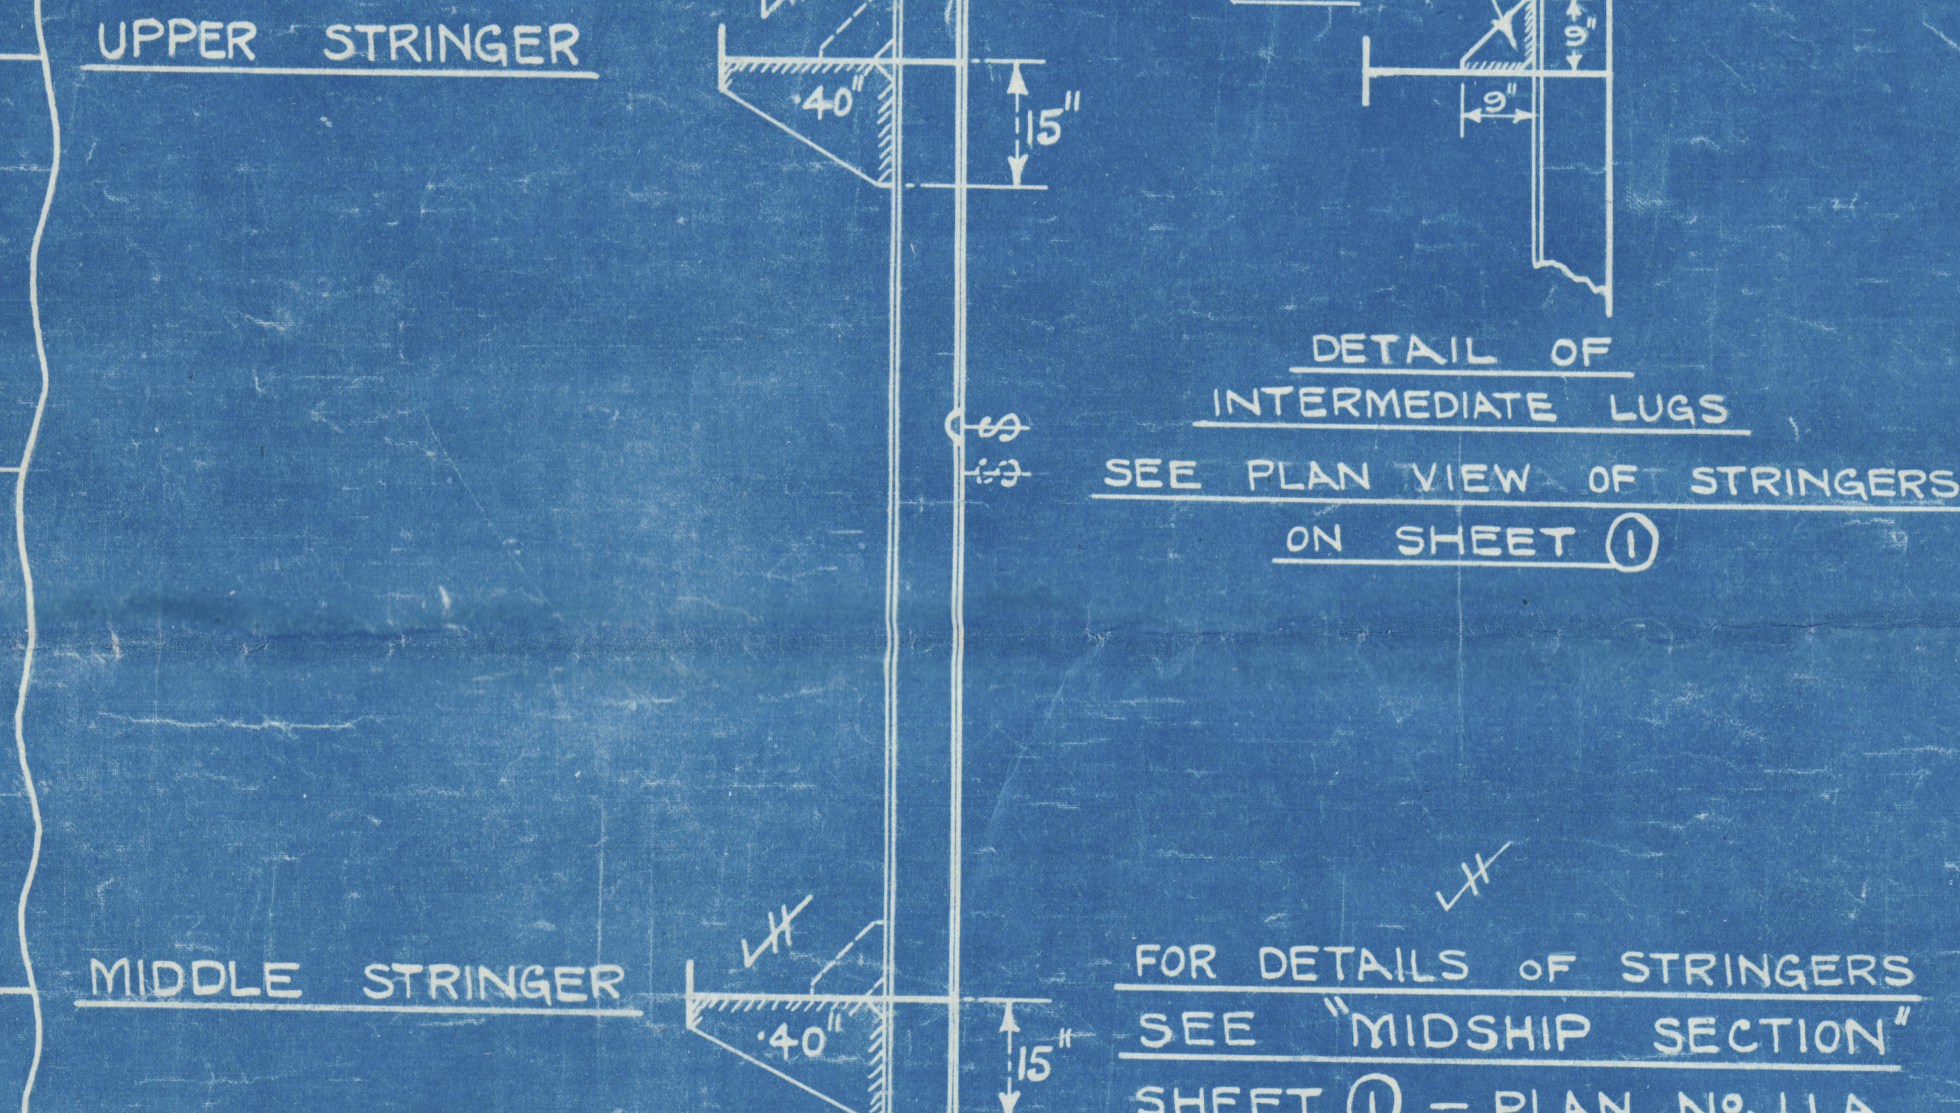
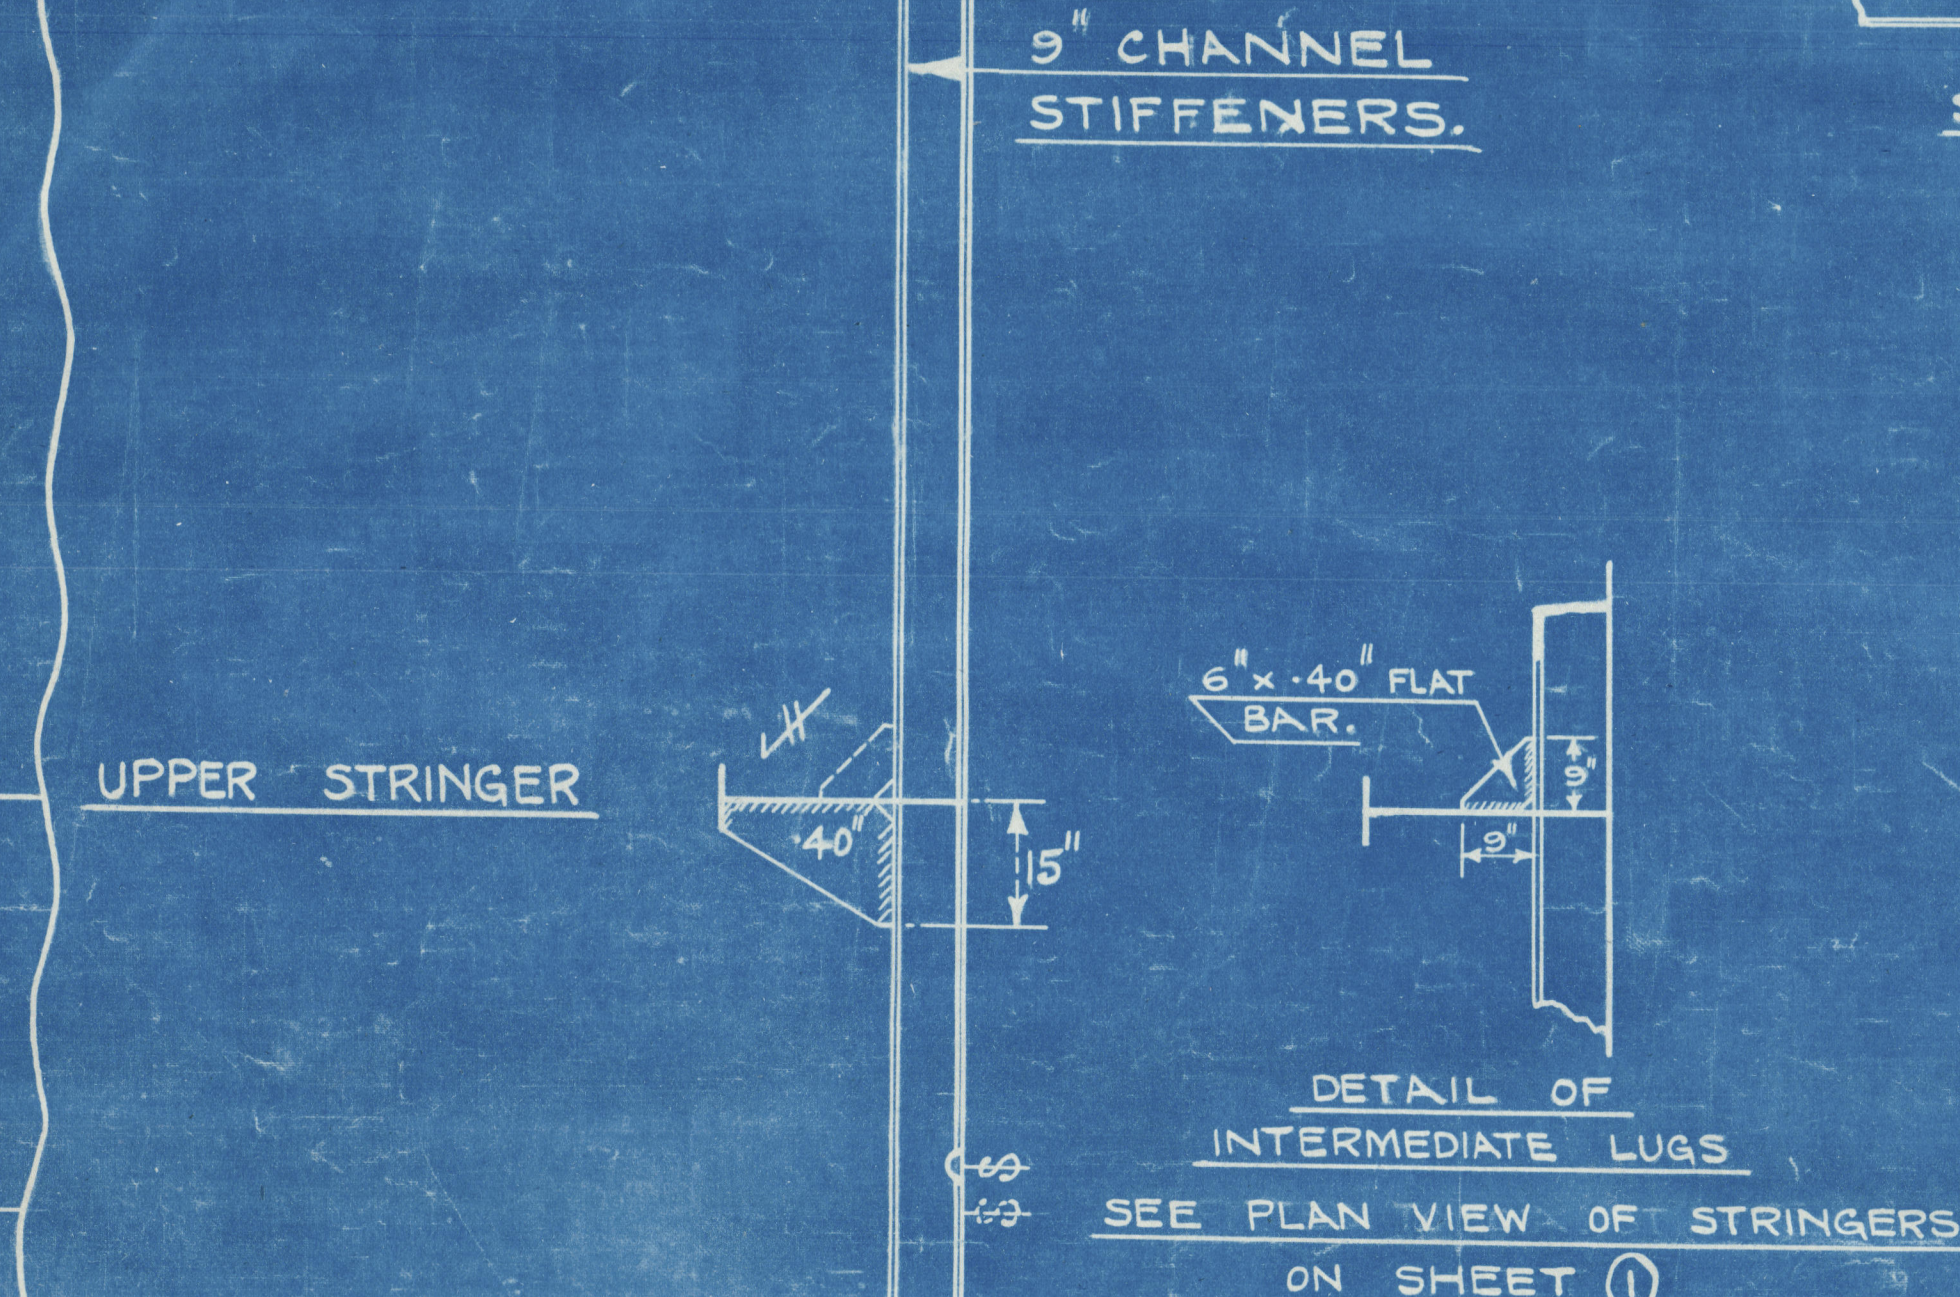
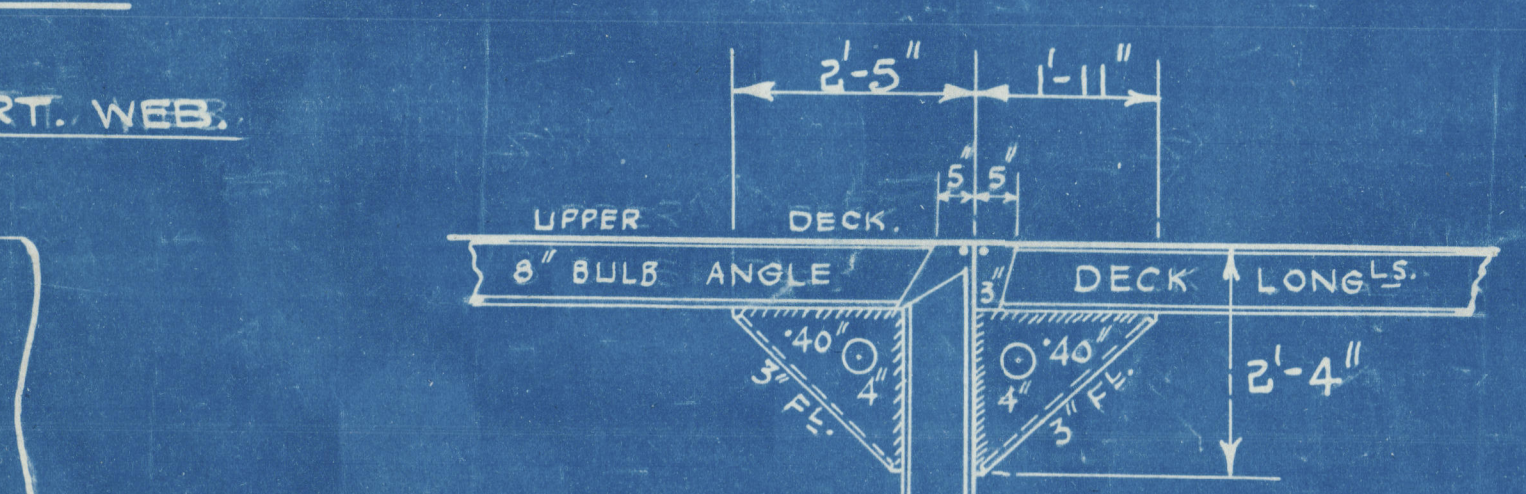
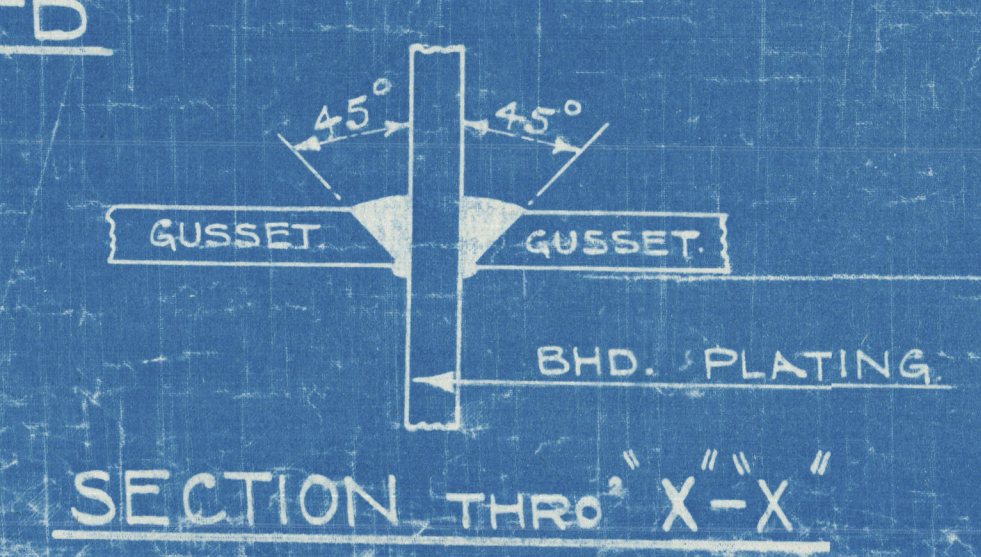


VERTICAL SEAMS UNIONMELT WELDED
TO CHANNEL STIFFENERS.

APPROVED BY LLOYDS - 25/6/48

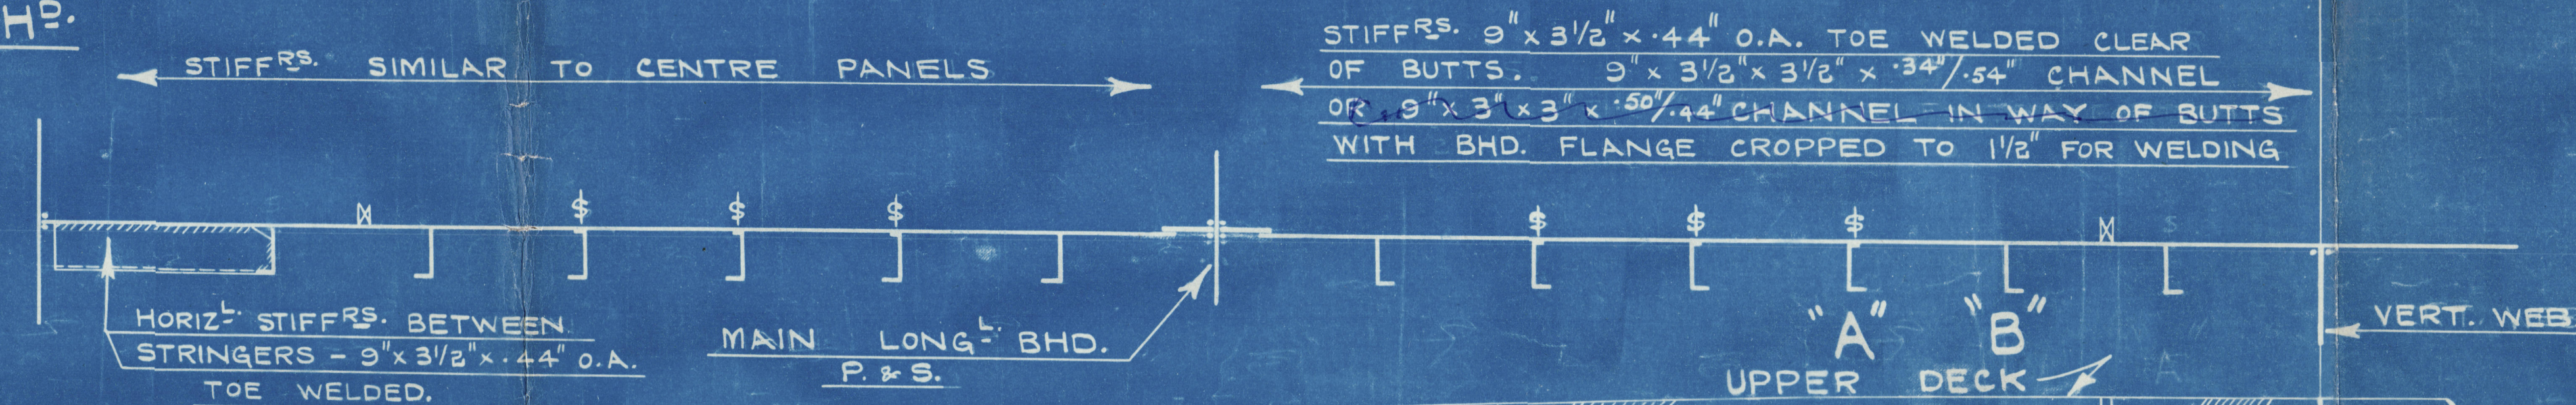

£ WEB ON TRANSVERSE BULKHEADS.

BARCLAY, CURKE & CO.

N^o 724.

MOSMID SECTION SHEET II (AS FITTED)

POLARTANIC

GLASGOW REPORT No. 80034

NO. 5 DEPTH
LONDON

2



© 2021

Lloyd's Register
Foundation

004564-004572-0267