

23 NOV 1928







Nº 629 & 630 (BARCLAY CURLE)
Nº 1381 (SOUTHWICK)
Nº 1383 & 5. (WALLSEND)
PROFILE & DECKS.

DIMENSIONS: - 253'-0" B.P. x 42'-4" E.T. x 20'-0" D.M.¹²
TO CLASS B.S.* FOR SERVICE ON GREAT LAKES &

LOA = 260

Approved *[Signature]*
m 11 28

RIVER ST. LAWRENCE.
SCALE 1/8" = 1 FT.

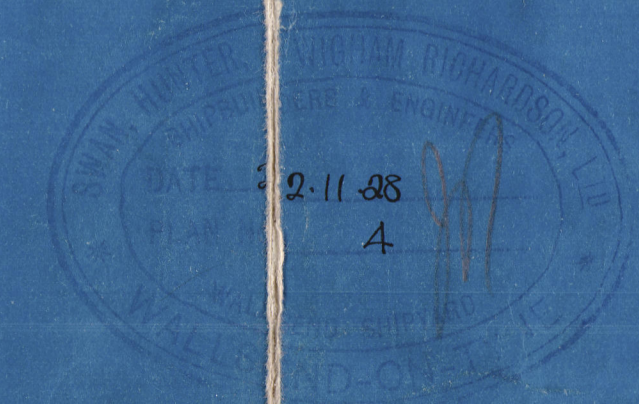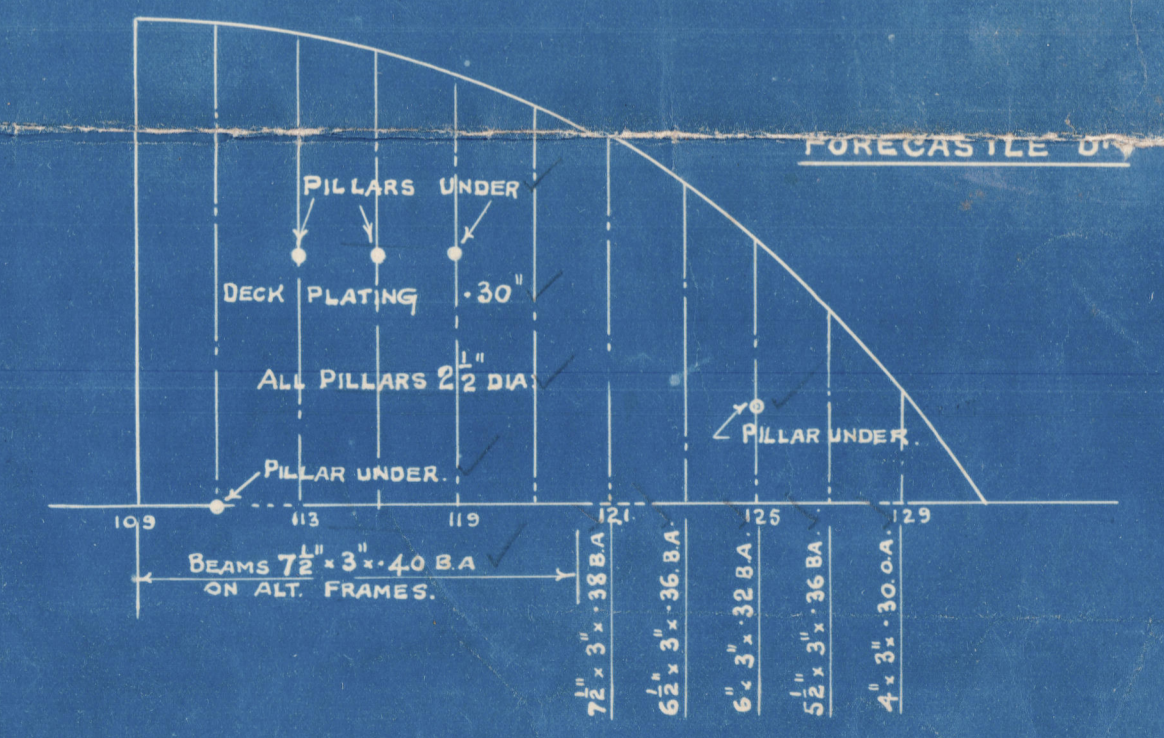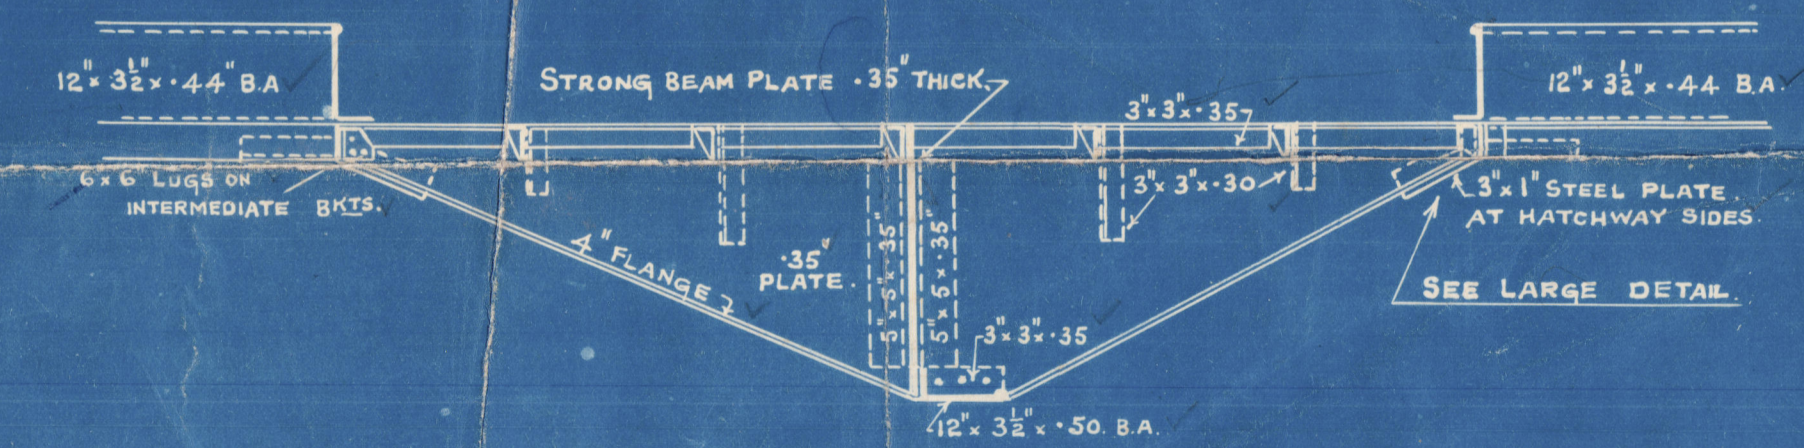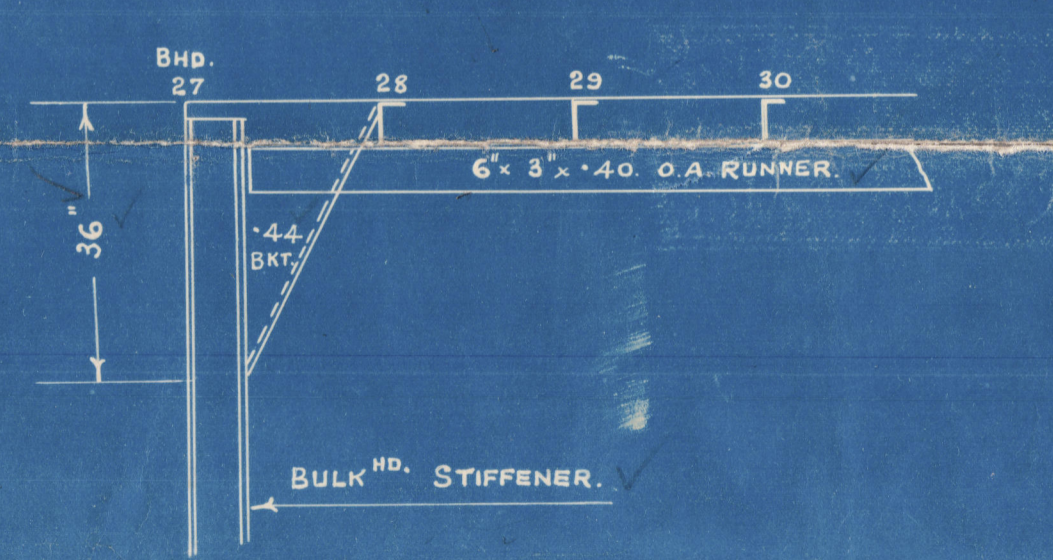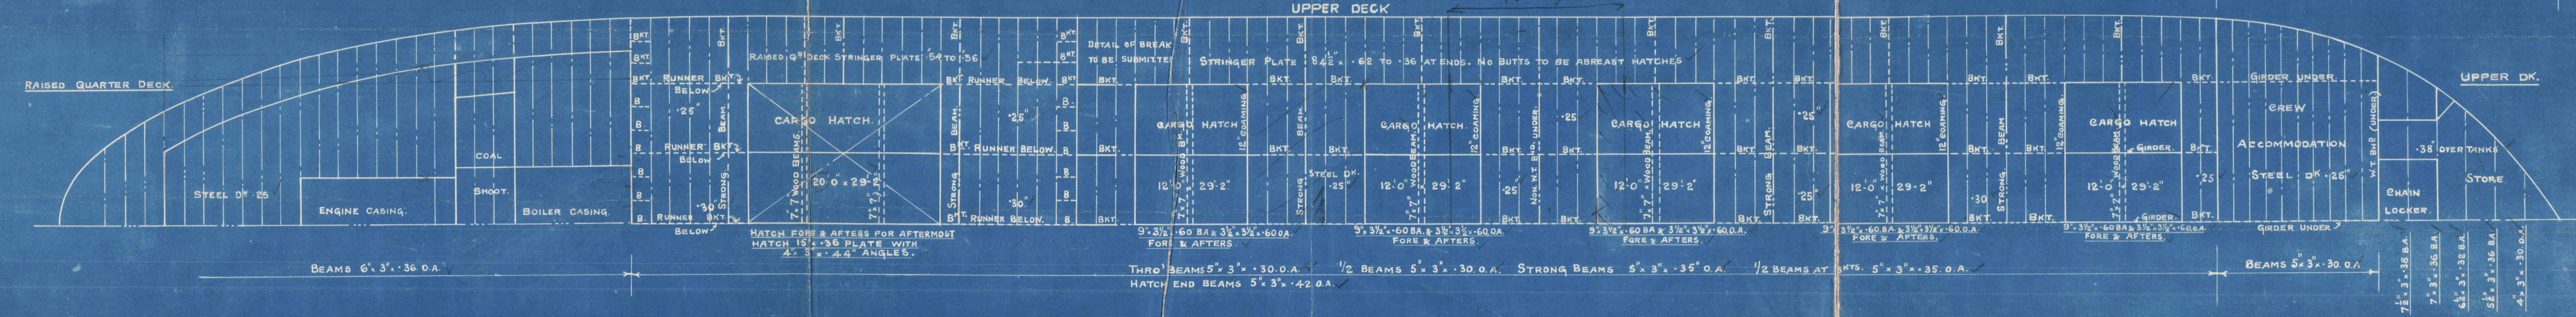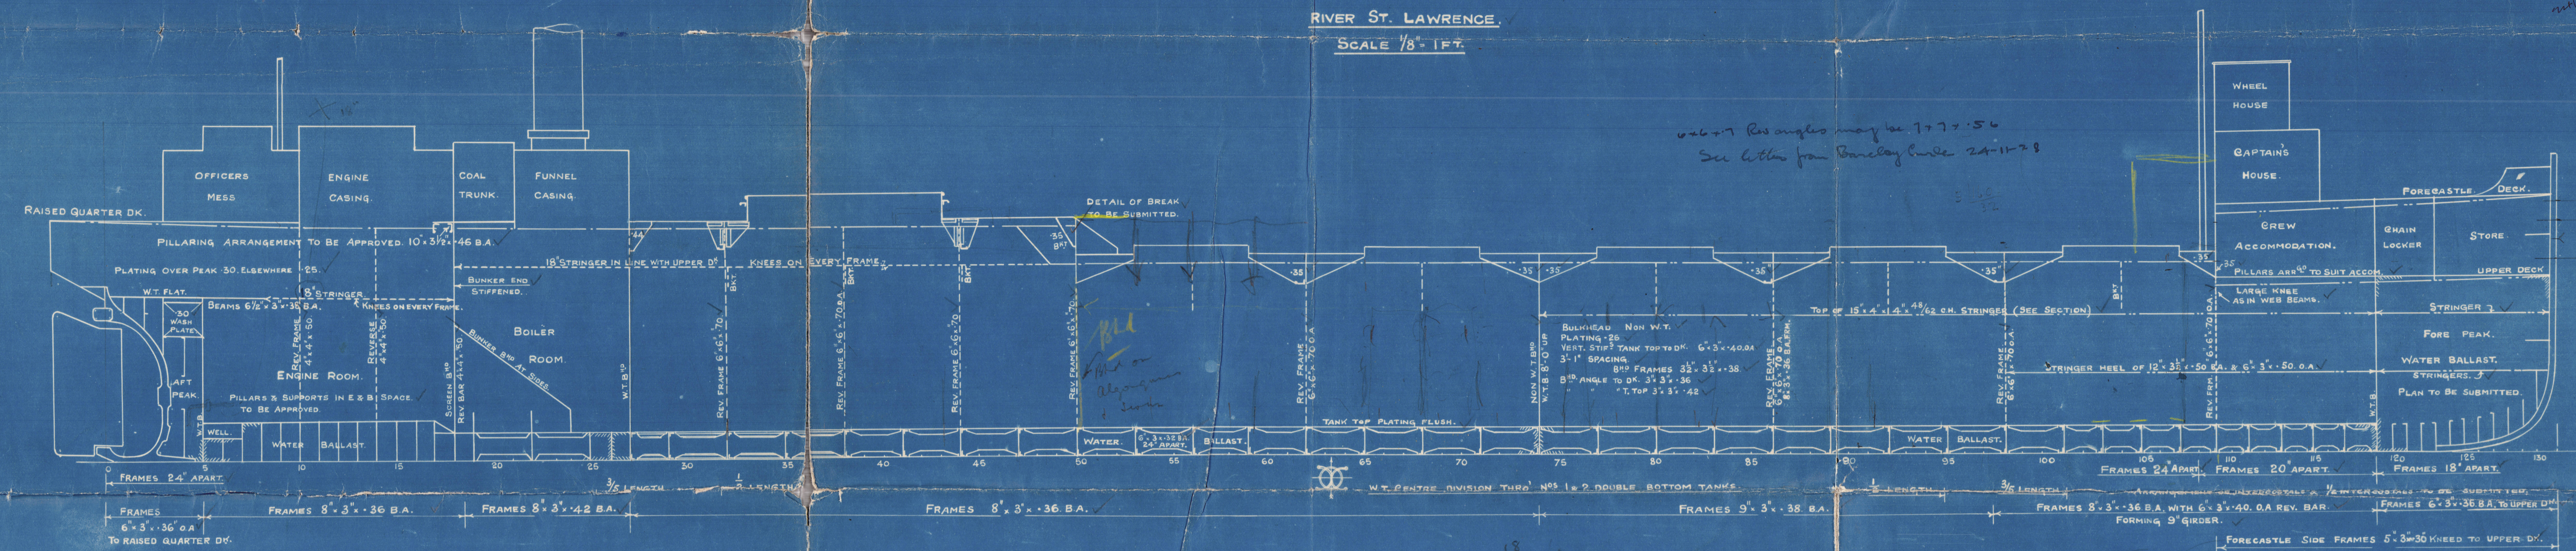

234
12
259

216
175
126
153
56
158-6

Profile & Decks.

Swan Hunter & W.H. N^{os} 1391 - 3.5.7
1381. 3.5.7.

Barclay Curle & Co. N^{os} 629. 0.1.2.3.
1356.
635.

W. B. 6-3-29.

24 - 11 - 28.

EA 1381 Prescodoc.*	1387 Starwell.
1383 Ganandoc.	1391 Portwell.
1385 Lawrendoc.	1393 Lockwell.
629. Sarniadoc.	632 Sioux.
X 630. Potlandoc.	633. Fairlake.
631 Algonquins.	635 Fairstream.
1356 ^W Farrandoc.	1395 Samia.
(new Clayton)	1397. Saracen.

going

FOR.

J. N. Mc WATERS.

PLANS TRANSFERRED
TO SISTER VESSEL

Troisdac



© 2021

Lloyd's Register
Foundation

004573-004578-0079