



S.S. EMPIRE TAGINDA
 OUTLINE MIDSHIP SECTION.
 SCALE: 1/2" = 1 FT

COBIE TONNAGE 3825.

4 FEB 1948

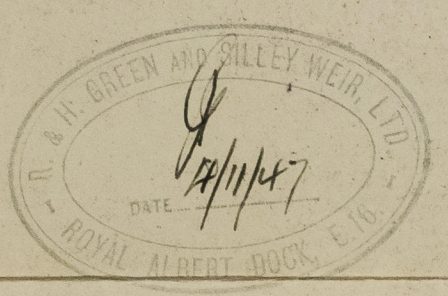

SALVEDOR COMPANY LIMITED
 City Office,
 BASSISHAW HOUSE,
 70, BASSINGHALL ST. E.C.2,
 Telephone WET. 8425 8.

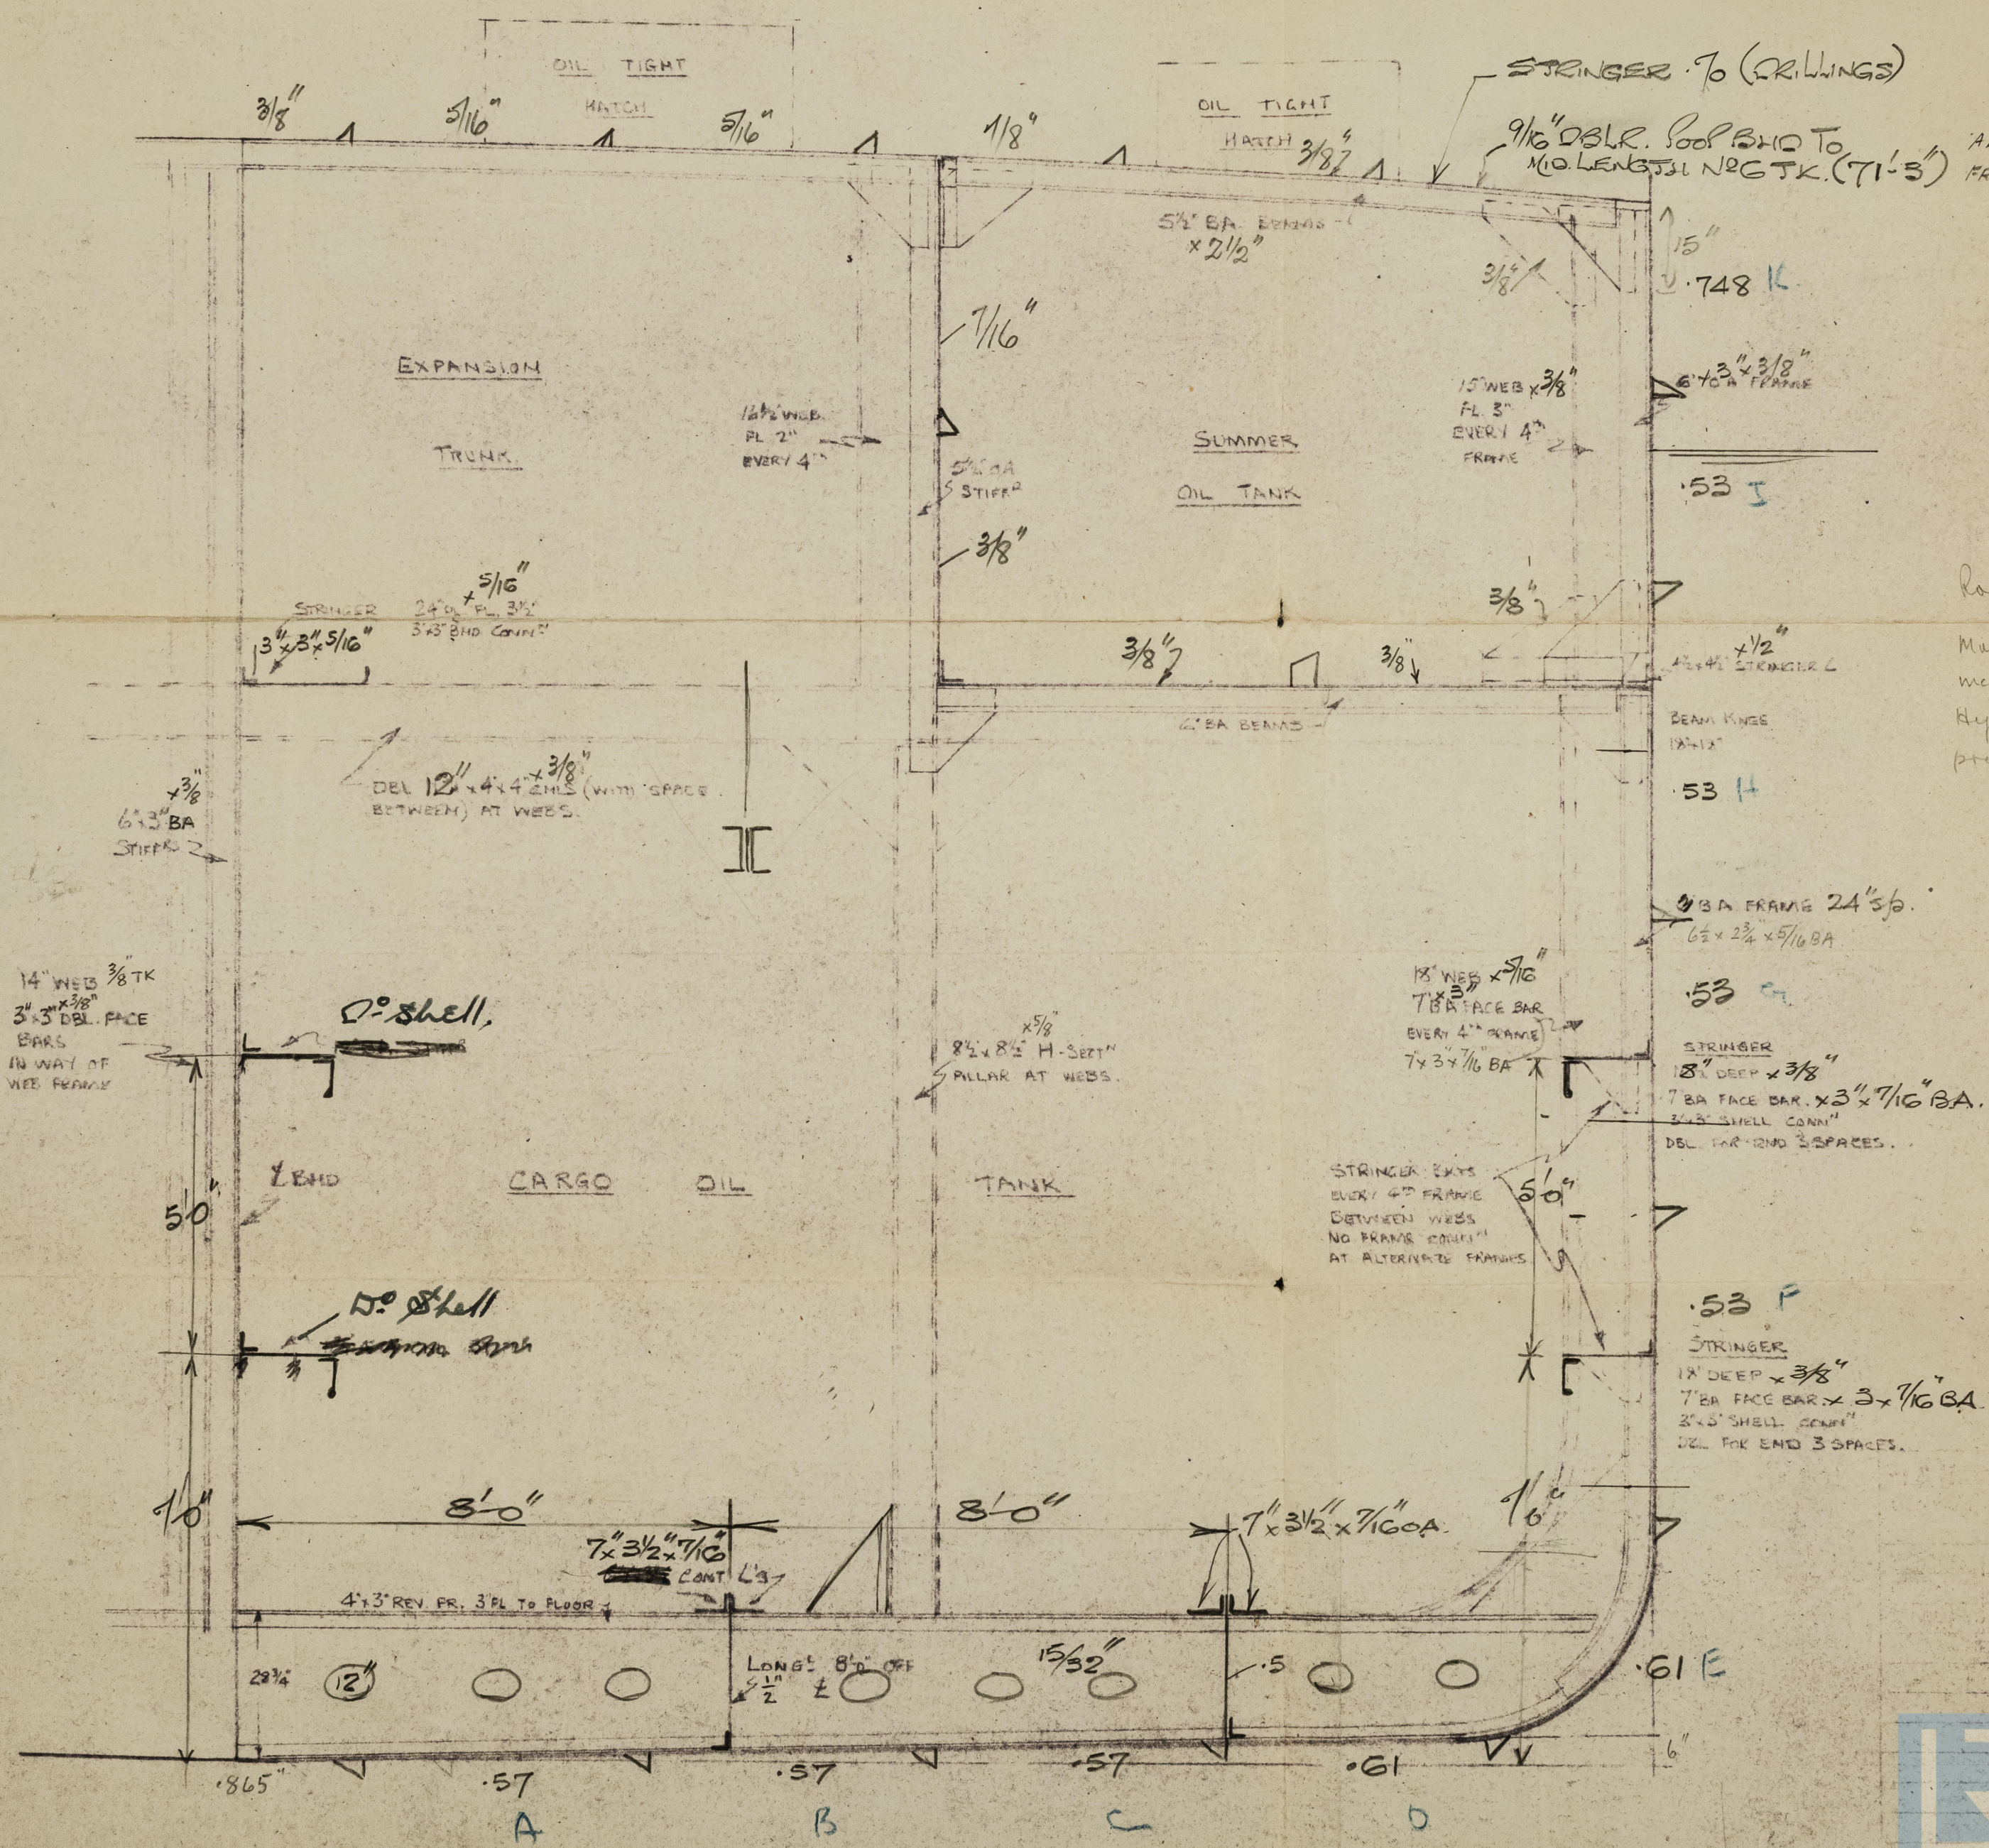

ALSO 7/16\"/>

Round of beam 11 1/2\"/>

31848
 589
 4-11-47.



004579-004590-0316

L.R. 1
VRISSI

Midship Section
~~ex.~~ OILSTREAM
1/2 BASINGSTREAN & EMPIRE TAGINDA.
London 11.2.18.

n.n. "VRISSI" *

SHIP 13

OUTLINE MIDSHIP SECTION

S.S. "BASINGSTREAN"
EX EMPIRE TAGINDA

4 FEB 1918

3/1 Basingstean
London

REMAIN

004579-004590-0316



© 2021
Lloyd's Register
Foundation