


Starboard side.

Port side.

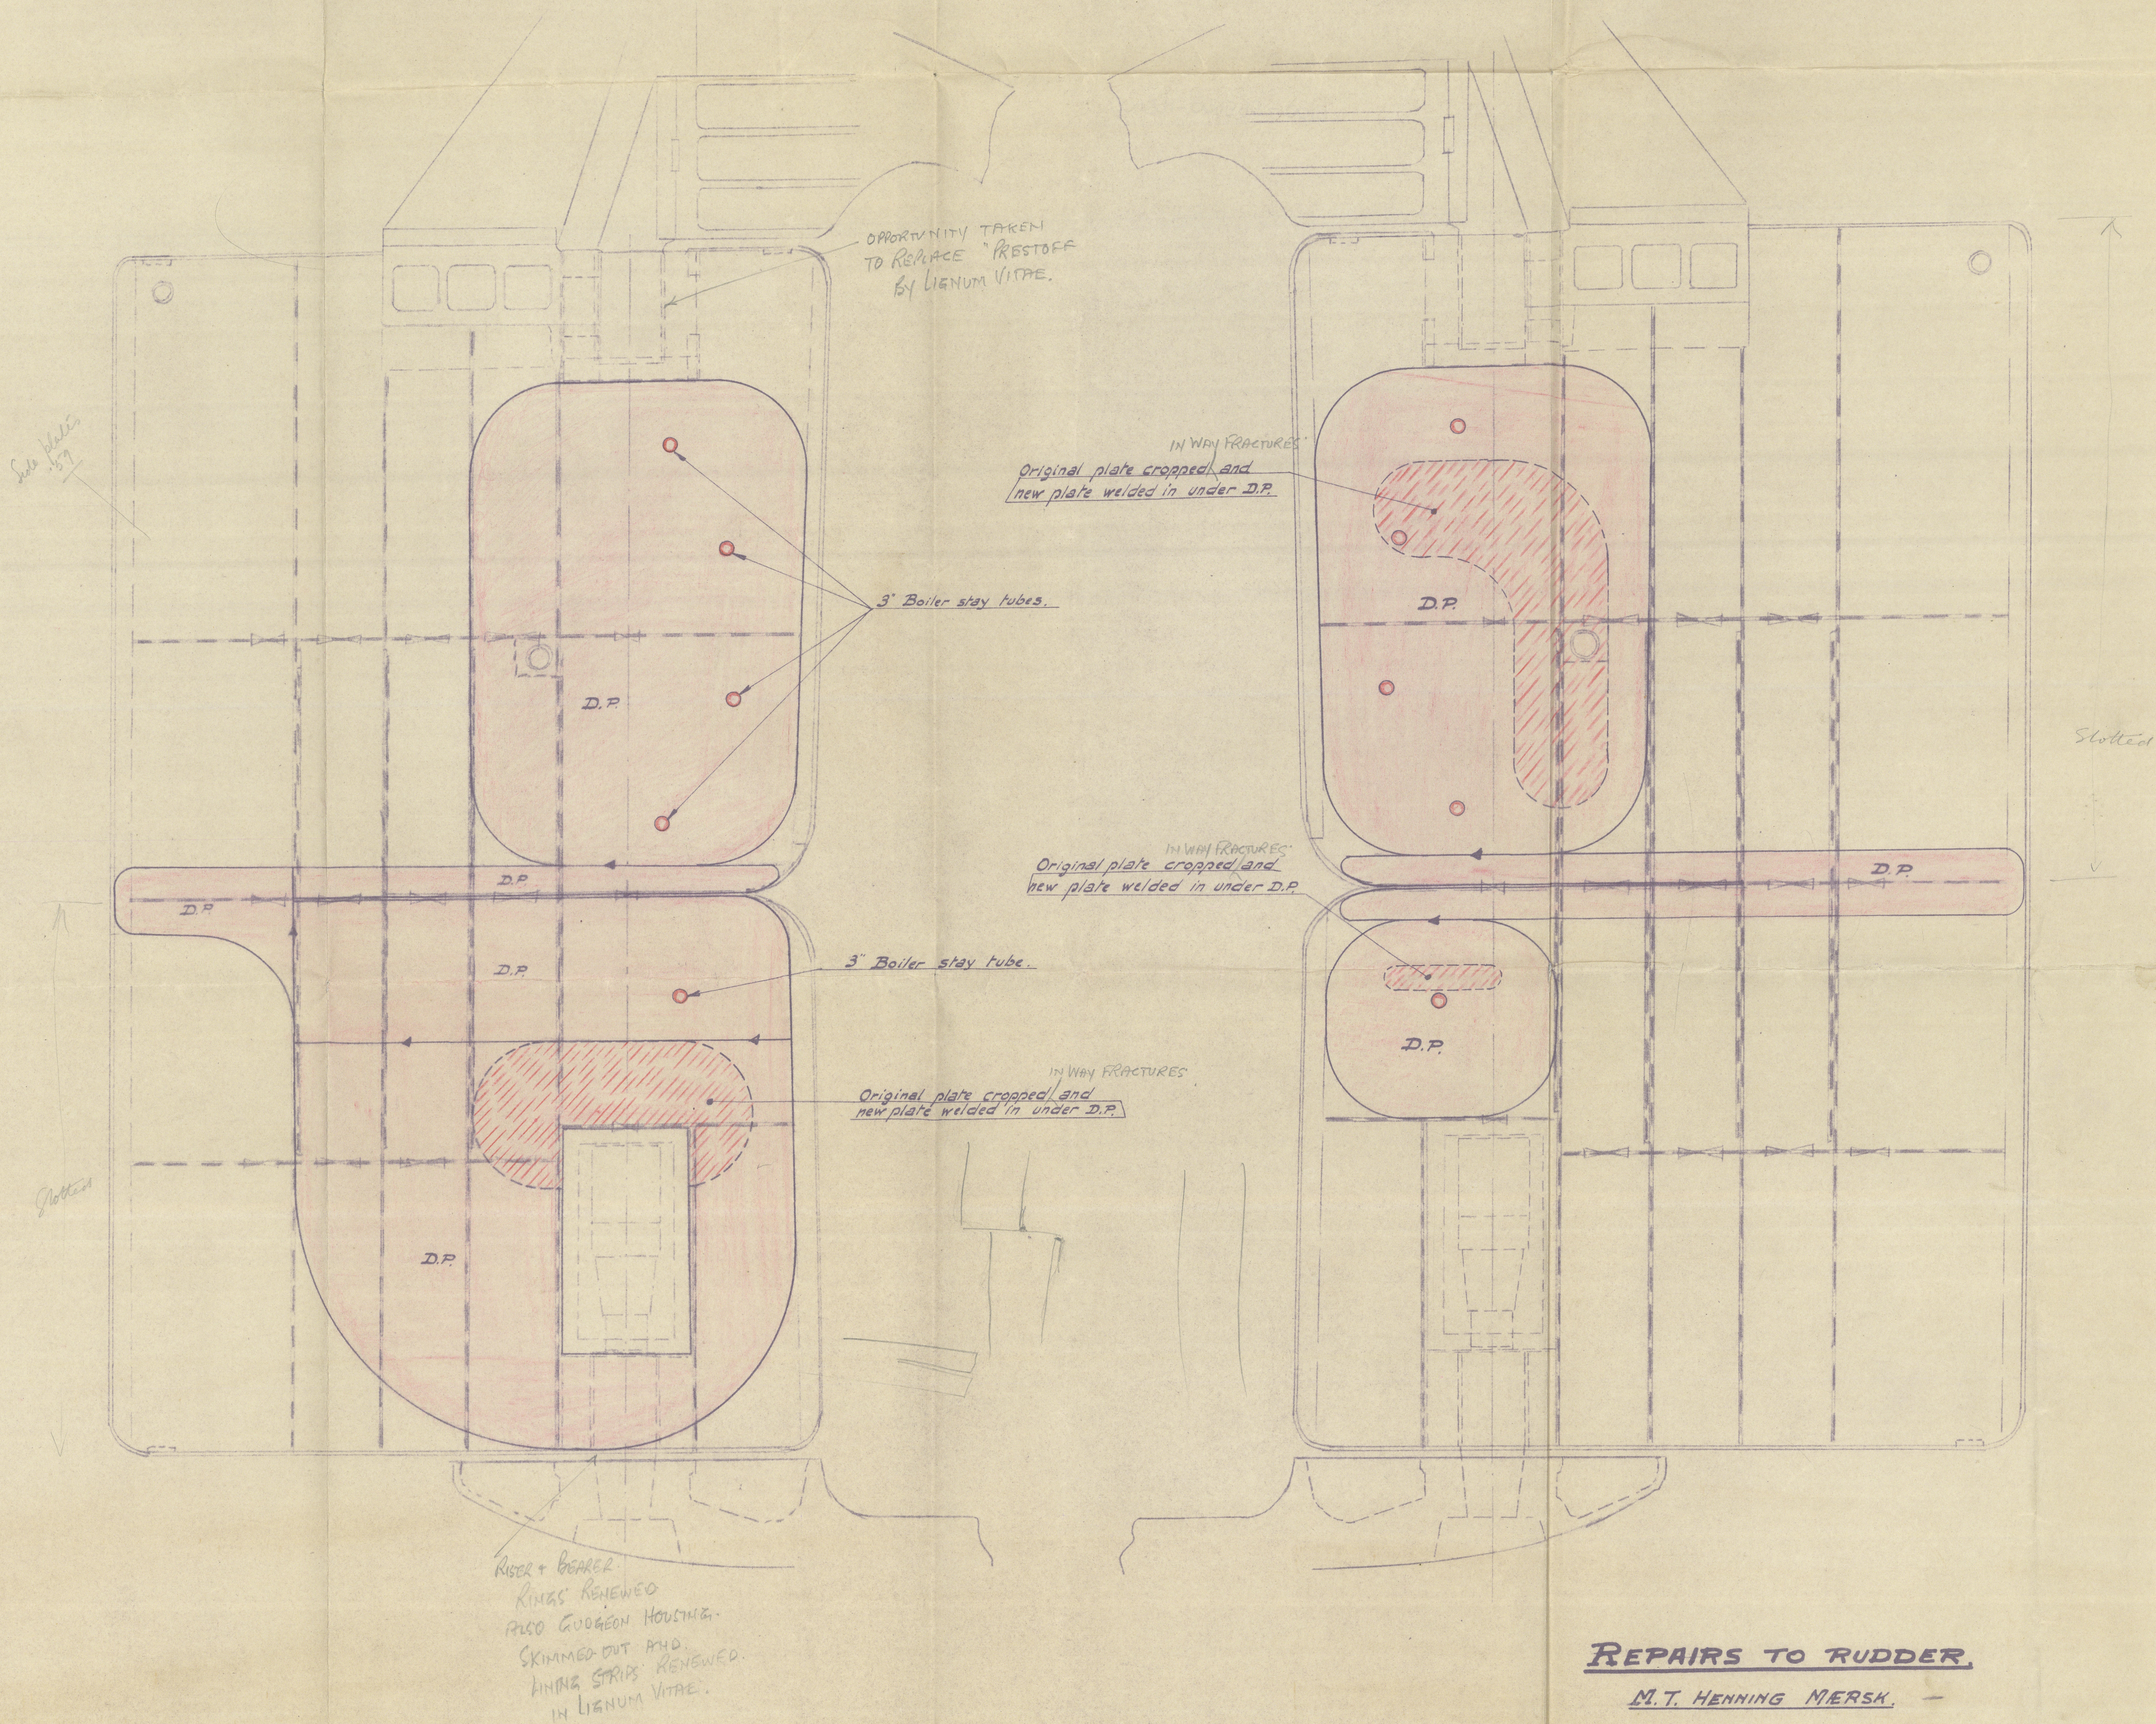

REPAIRS TO RUDDER

M.T. HENNING MERSK.

Guthrie Murdoch & Co

Amsterdamstraat, 2 19-11-48. Antwerpen

Dwg: N° 3206.

004591-004595-0019



© 2020

Lloyd's Register Foundation