

SEE PLAN OF ALTERATIONS
ATTACHED TO MTL RPT 10599

4-55

17 MAR. 1924


MIDLAND SHIPBUILDING CO. LIMITED
MIDLAND, ONTARIO

SCALE 1/2" = 1 FOOT	HULL NO.
DRAWN BY <i>[Signature]</i>	DRAWING NO.
TRACED BY <i>[Signature]</i>	DATE 27 th FEB/24
CHECKED BY <i>[Signature]</i>	PRINT NO.
	SENT OUT

S.S. "GLENELG"

ALTERATIONS SHOWING CONVEYERS MOVED
OUTBOARD 2'-10" & LOWERED 2'-0"

Approved by C.S. See also
to Montreal Surveyors 18.3.24
also cables 18.3.24

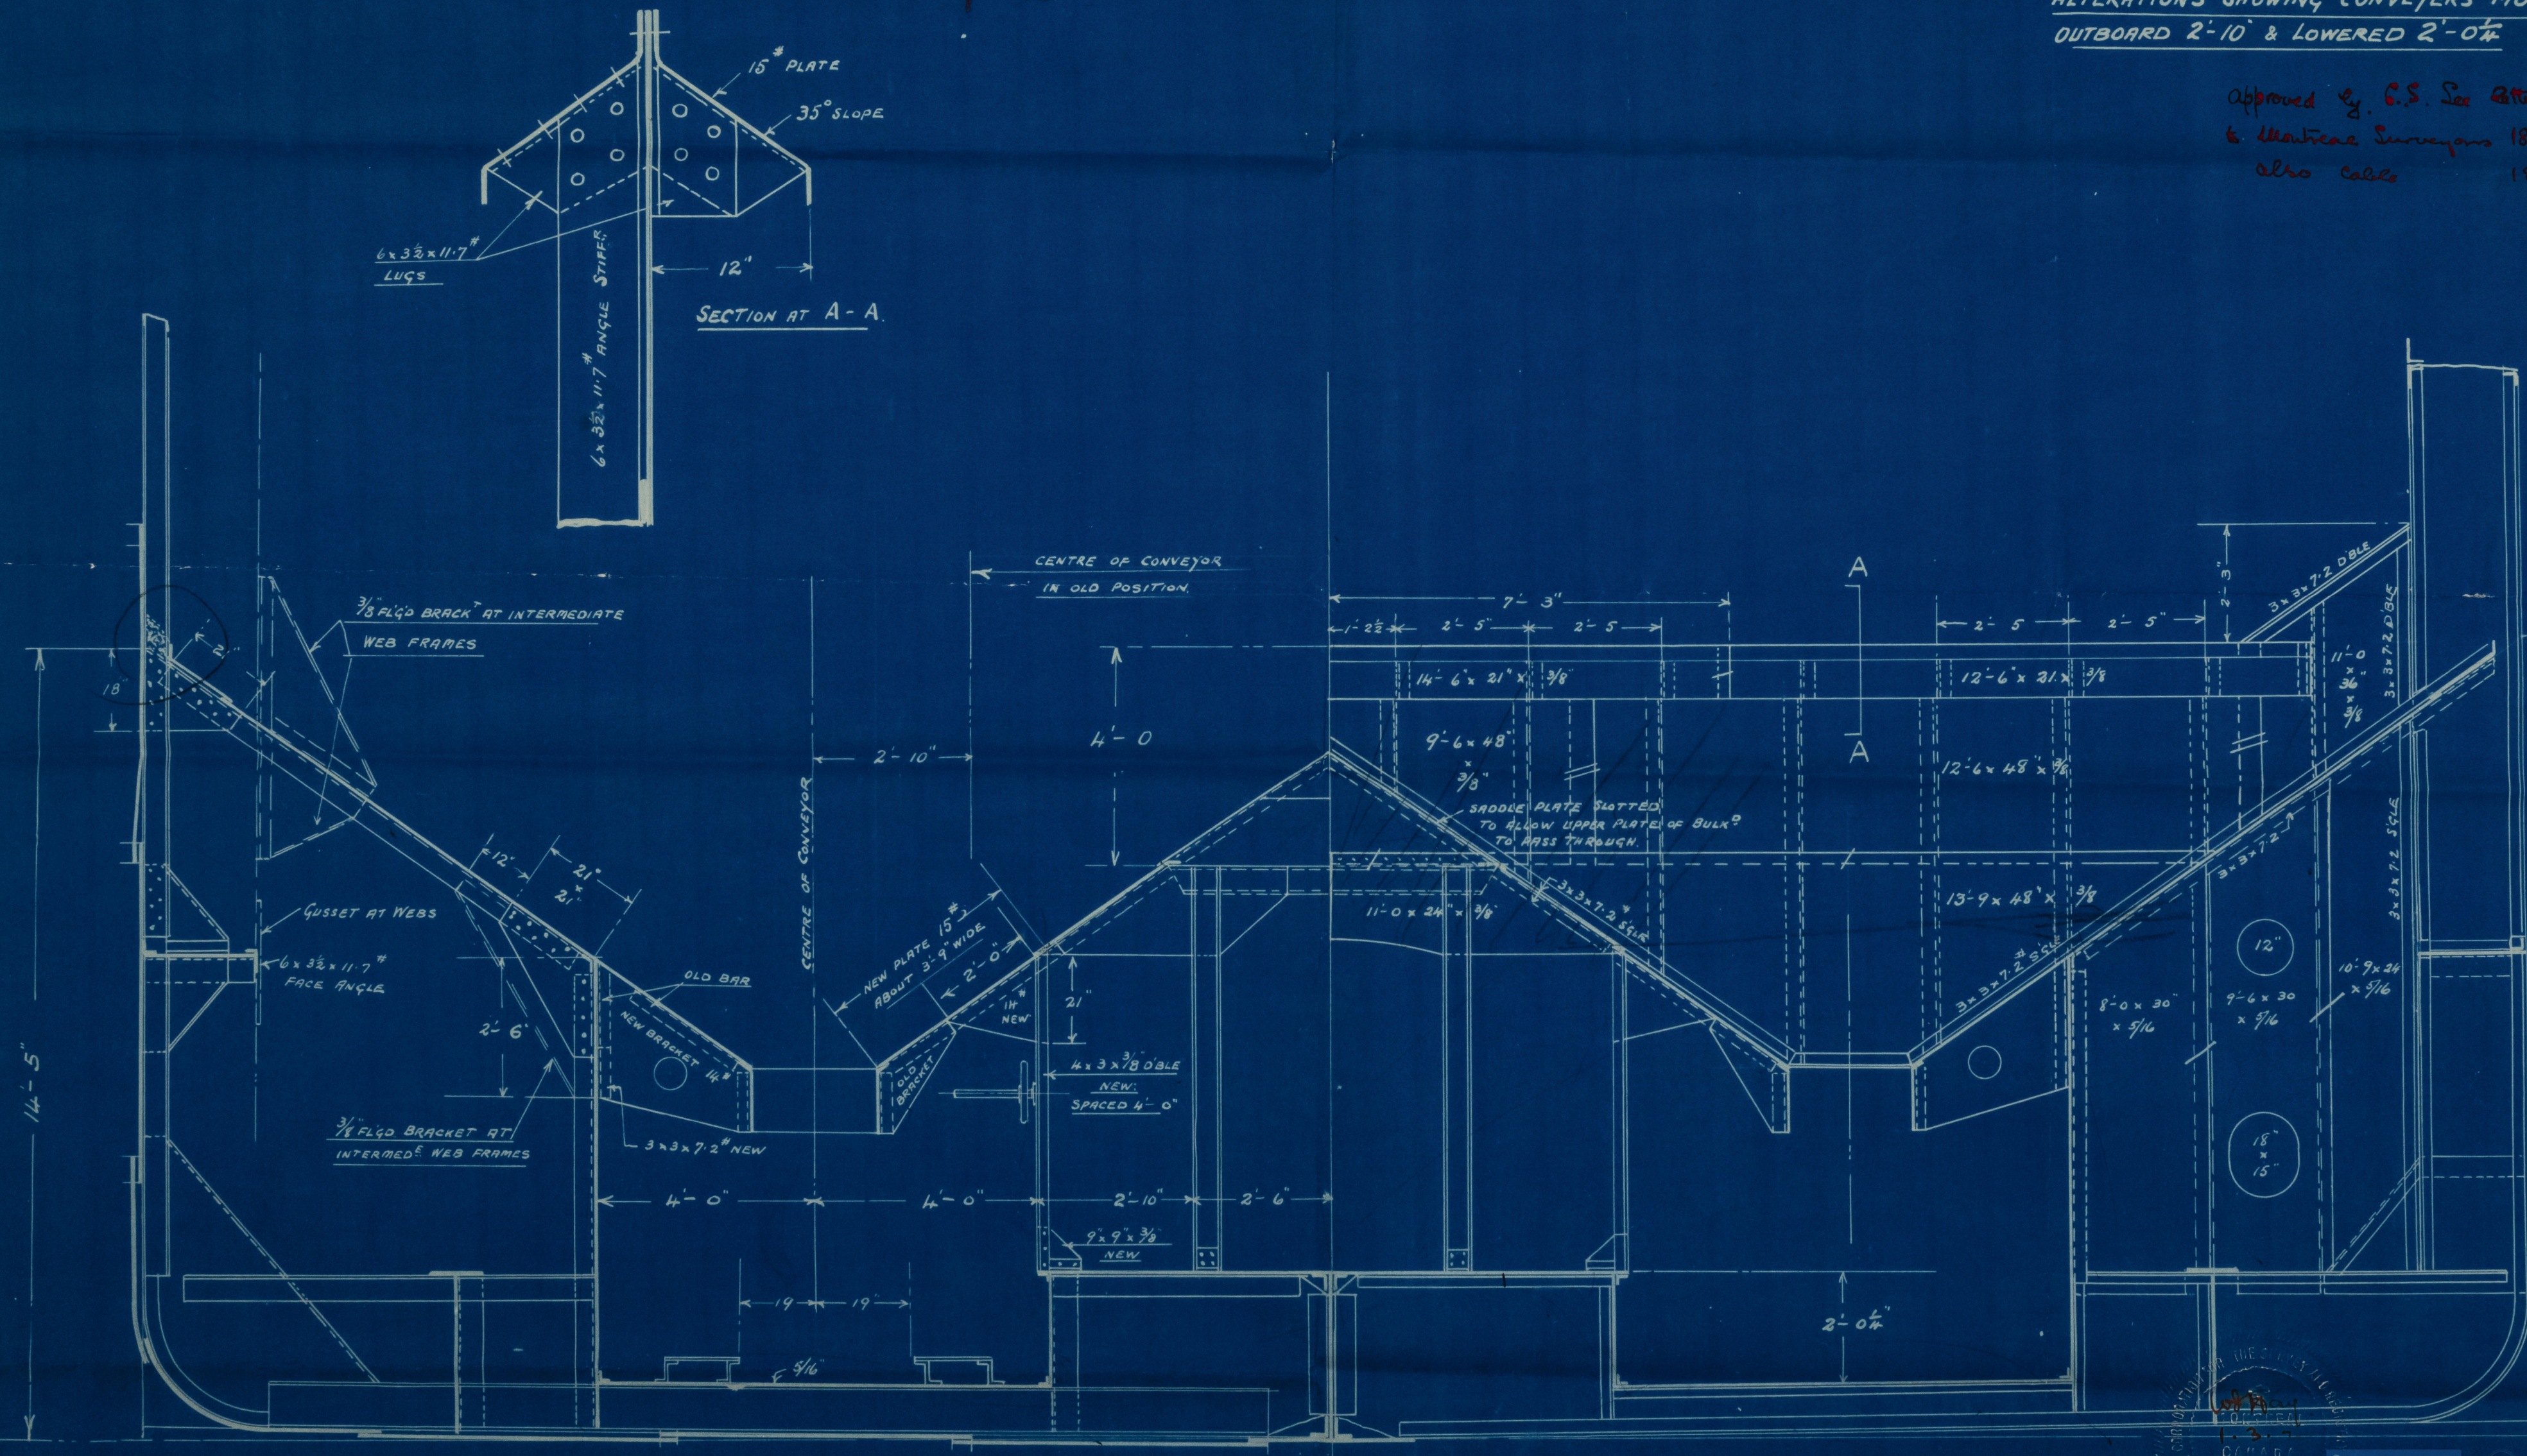


SECTION SHOWING PARTIAL BULKHEAD AT CENTRE OF EACH HOLD



© 2020

Lloyd's Register
Foundation

004591-004595-0072

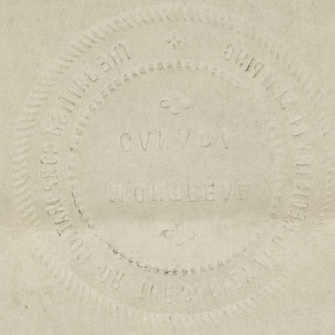

Glendy


Altho^{us} showing
Conveyors stillboard
2-10
Bag

004591-004595-0072

8.
M^{rs} Shewing conveyed
S^{rs} Glendy

DESTROY
1976

004591-004595-0072

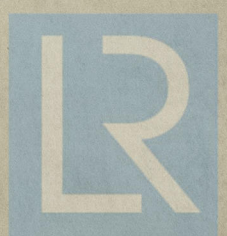

© 2020

Lloyd's Register
Foundation