


NOTES: EXISTING GIRDERS NOT TO BE CUT

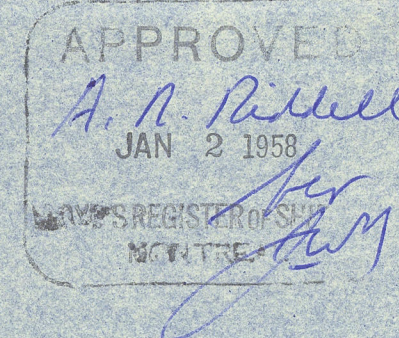

S.S. "GLENELG"
PROP'D REMOVAL OF SCREEN
BHD.

SCALE: 1/2" = ONE FOOT

DEC 20th '57

KINGSTON, SHIPYARDS
KINGSTON, ONT.

SECTION AT BHD 73 (NON. W.T.)

COPIES:-
LLOYD'S (3)
C.S.L. (3) 10-12-57
C.S.L. (2)

004591-004595-0075

'GLENELG'

MTL 12192

PROP'D REMOVAL OF SCREEN

BH D.

004591-004595-0075



© 2020

Lloyd's Register
Foundation