


SCALE 1:20 - 1:10.

LENGTH BETWEEN RA 485' 0" = 147.825 M.  
BREATH MOULDED. 66' 6" = 20.268 M.  
DEPTH MOULDED TO UPPER DECK. 35' 11" = 10.95 M.  
DRAFT 28' 6" = 8.686 M.  
SPEED 13 KNOTS.  
AREA OF RUDDER  $\frac{1}{2}$  = 17.85 M.  
CLASS BR LLOYDS. 100. A.1.  
CARRYING PETROLEUM IN BULK.

BR LLOYDS TEST TO BE DELIVERED.



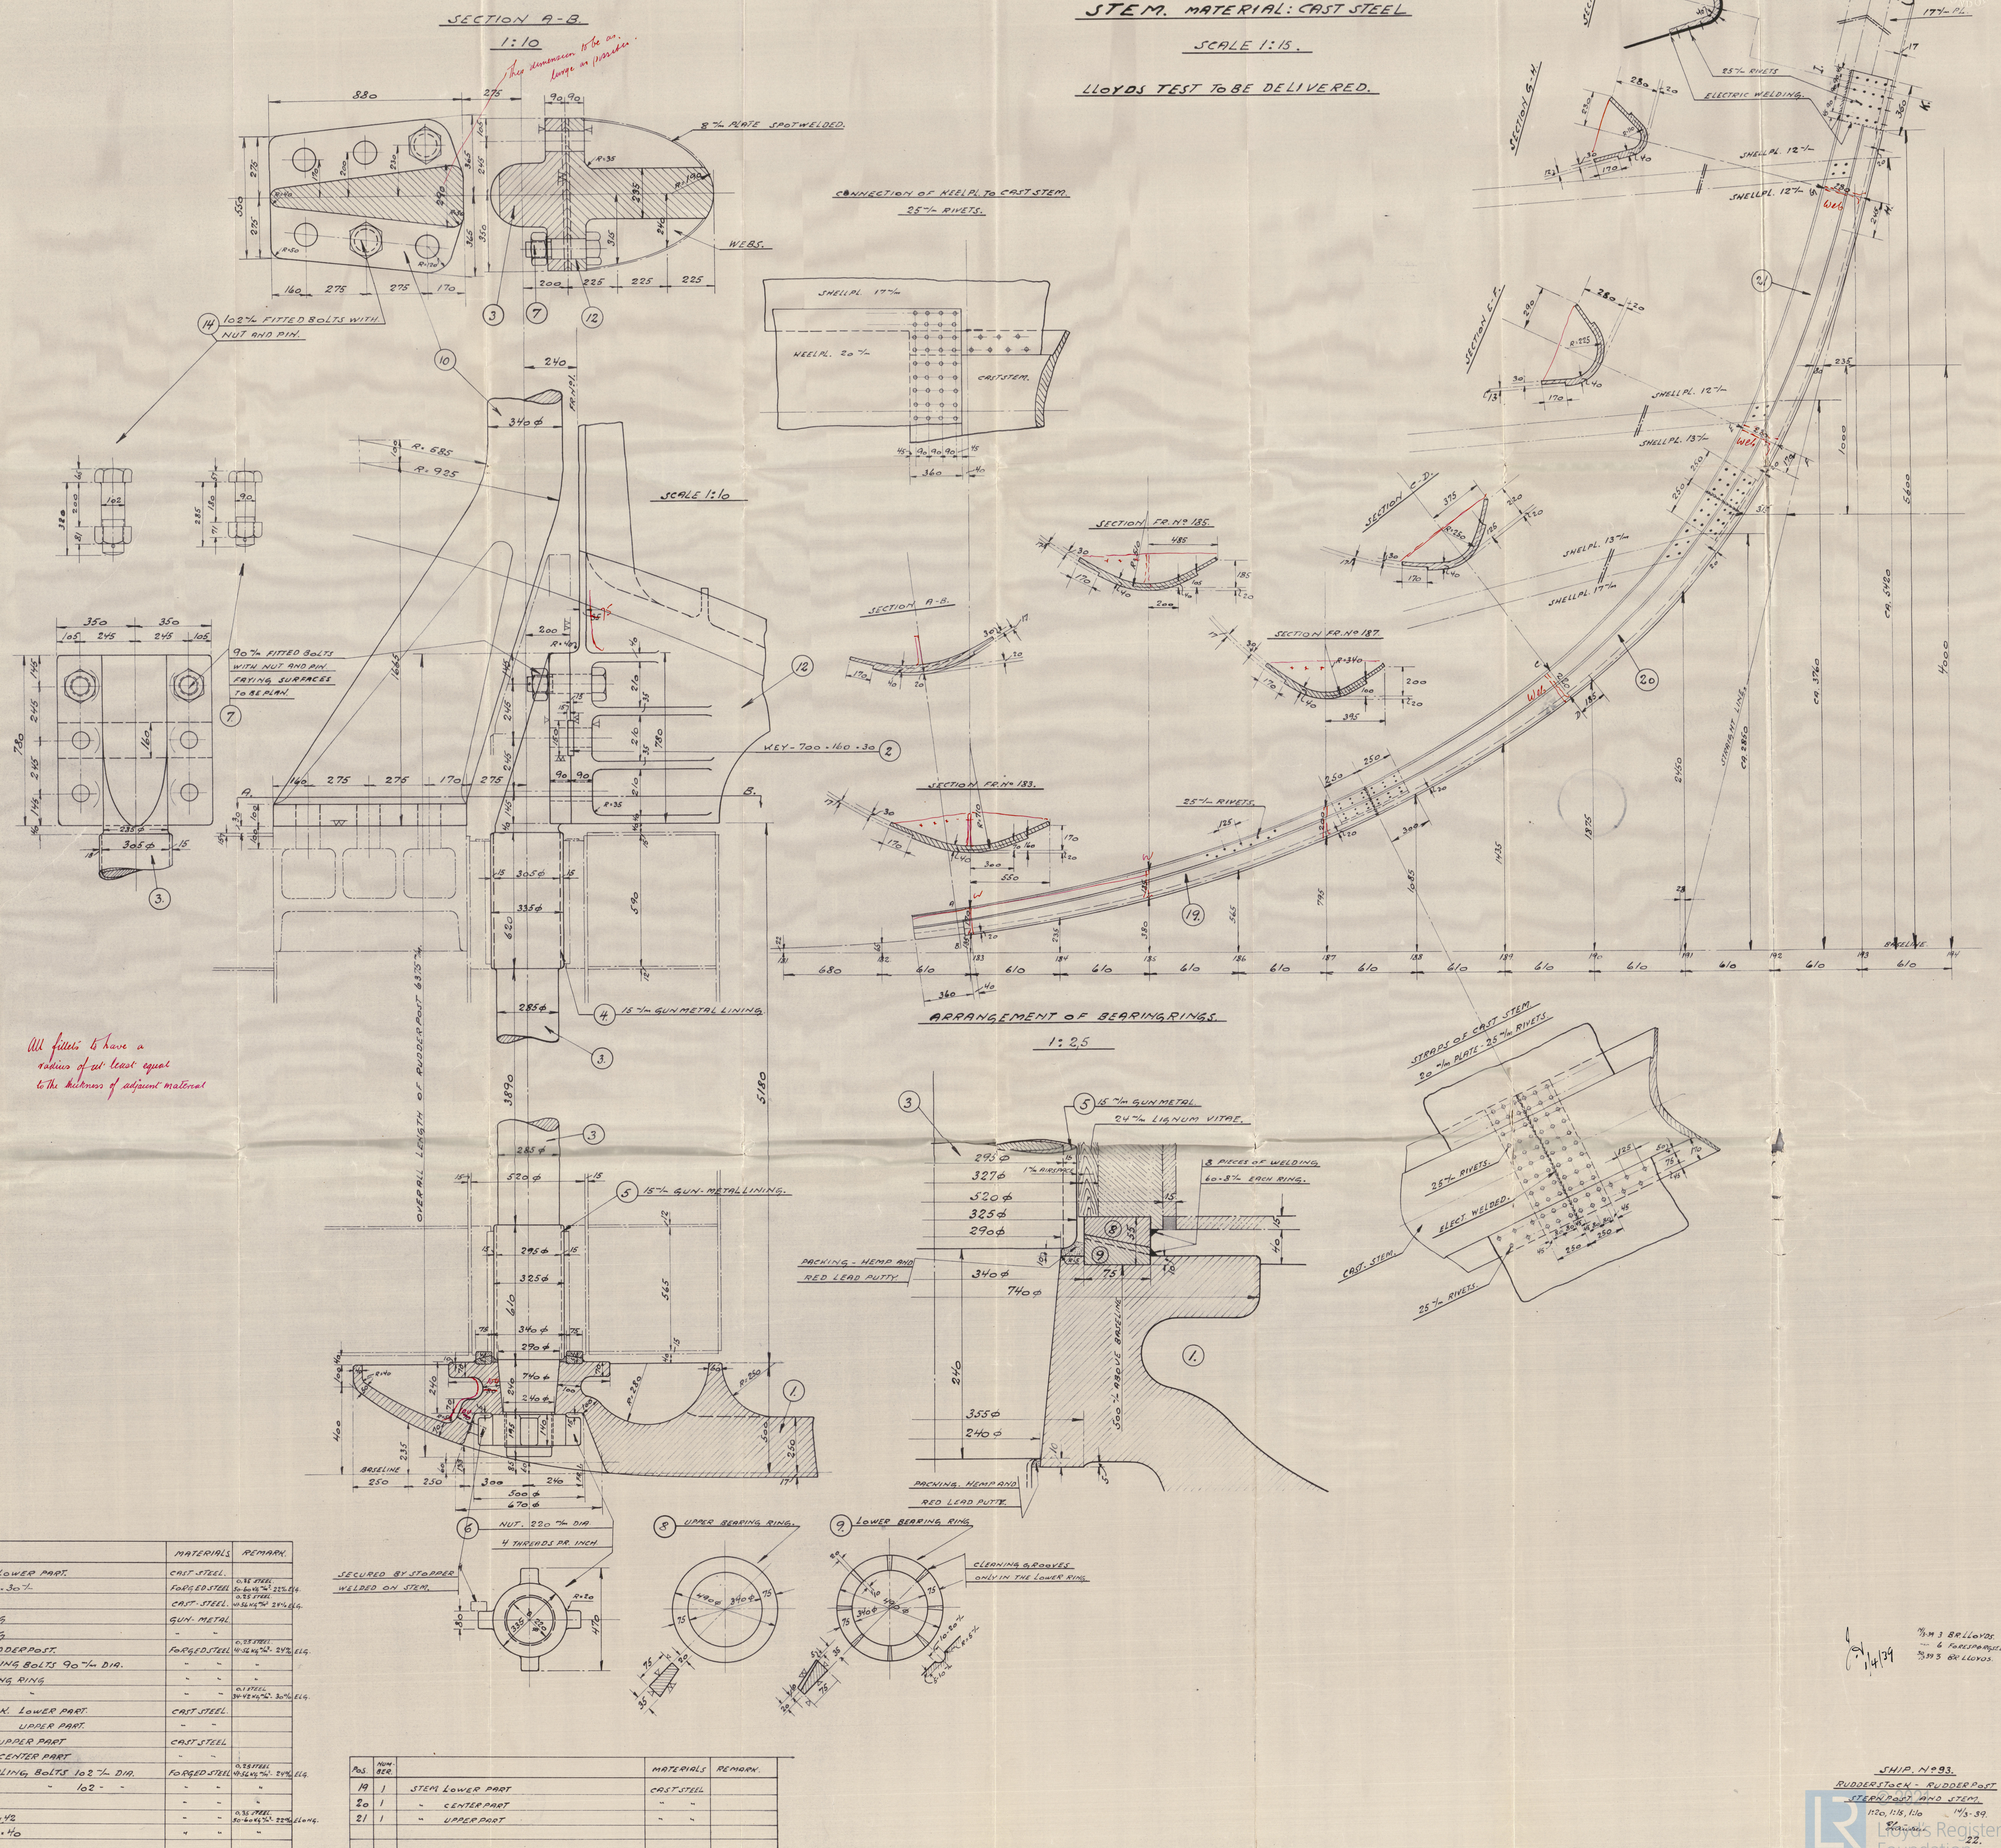


Surveyor

Narskov. 93.

Amended Sternframe.

T Stem.

15

m/s - Henning Marsh   
Gpr. Rpt. No. 11387.

5

004603-004611-0016



© 2021

Lloyd's Register  
Foundation