


Doc No 3241
S/N 290
7/7/30

S/S. No 290.

DETAILS OF FINS ON RUDDER POST.

10.7.30

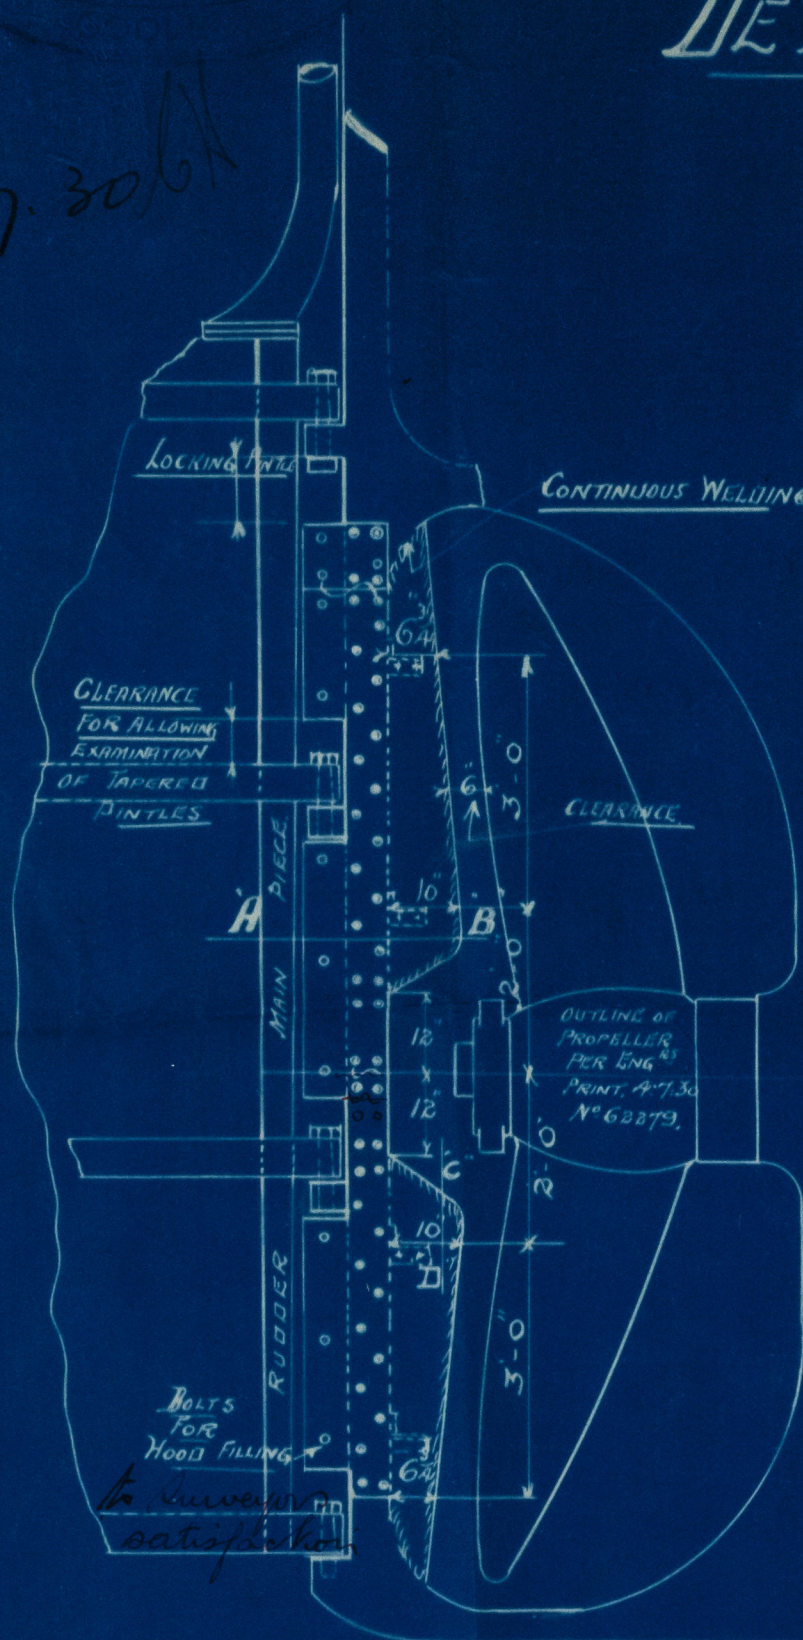


ELEVATION

1/2" SCALE

SECTION THRO "A" "B"

3" SCALE

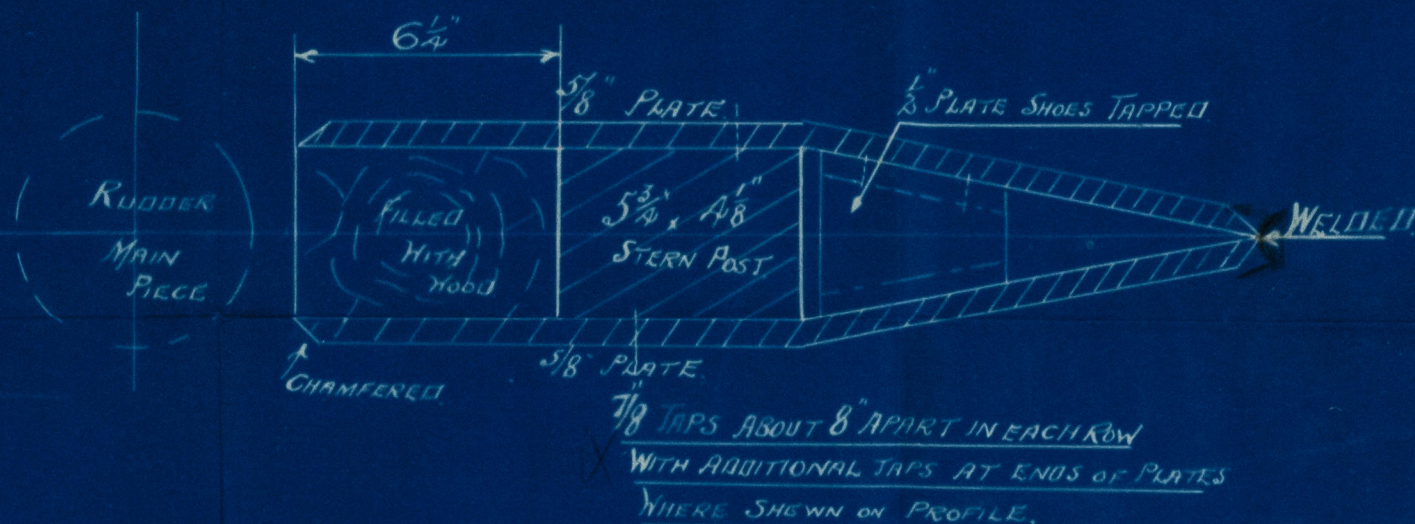

SECTION THRO C.D.

LOOKING AFT.

Heads of taps to be welded over or other suitable arrangements to be made to prevent taps slacking back, to Surveyor's satisfaction.

1002
290
7/7/30

Fins to be made watertight or filled with suitable material to Surveyor's satisfaction.
pitch filling

GOOLE SHIPBUILDING & REPAIRING CO (1927) LTD

GOOLE



Lloyd's Register Foundation

004603-004611-0059

No 290

Details of Fins on
Rudder Post.

Goole S.B. & R. Co. Ltd.

S.S. "Sanfry"

HULL REPORT No. 41162.

N.A. "FORTELET" X



© 2021

Lloyd's Register
Foundation

004603-004611-0059