

# S. S. No. 122.


## PROFILE & DECK PLAN.

SCALE  $\frac{1}{8}$ " = ONE FOOT.

DIMENSIONS:-

LENGTH B.P. 153'-0"  
BREADTH MLD 34'-0"  
DEPTH MLD TO UPPER DK. 12'-6"

BULKHEAD		SCANTLINGS.	
No OF BHD	BOUNDARY ANGLE.	LOWER PLATE.	UPPER PLATE.
FR. 4	5' 3" x 3' 4"	16' IN LIEU OF DOUBLING	30"
" 32	3' 3" x 3' 3"	36"	26"
" 70	3' 3" x 3' 3"	30"	26"

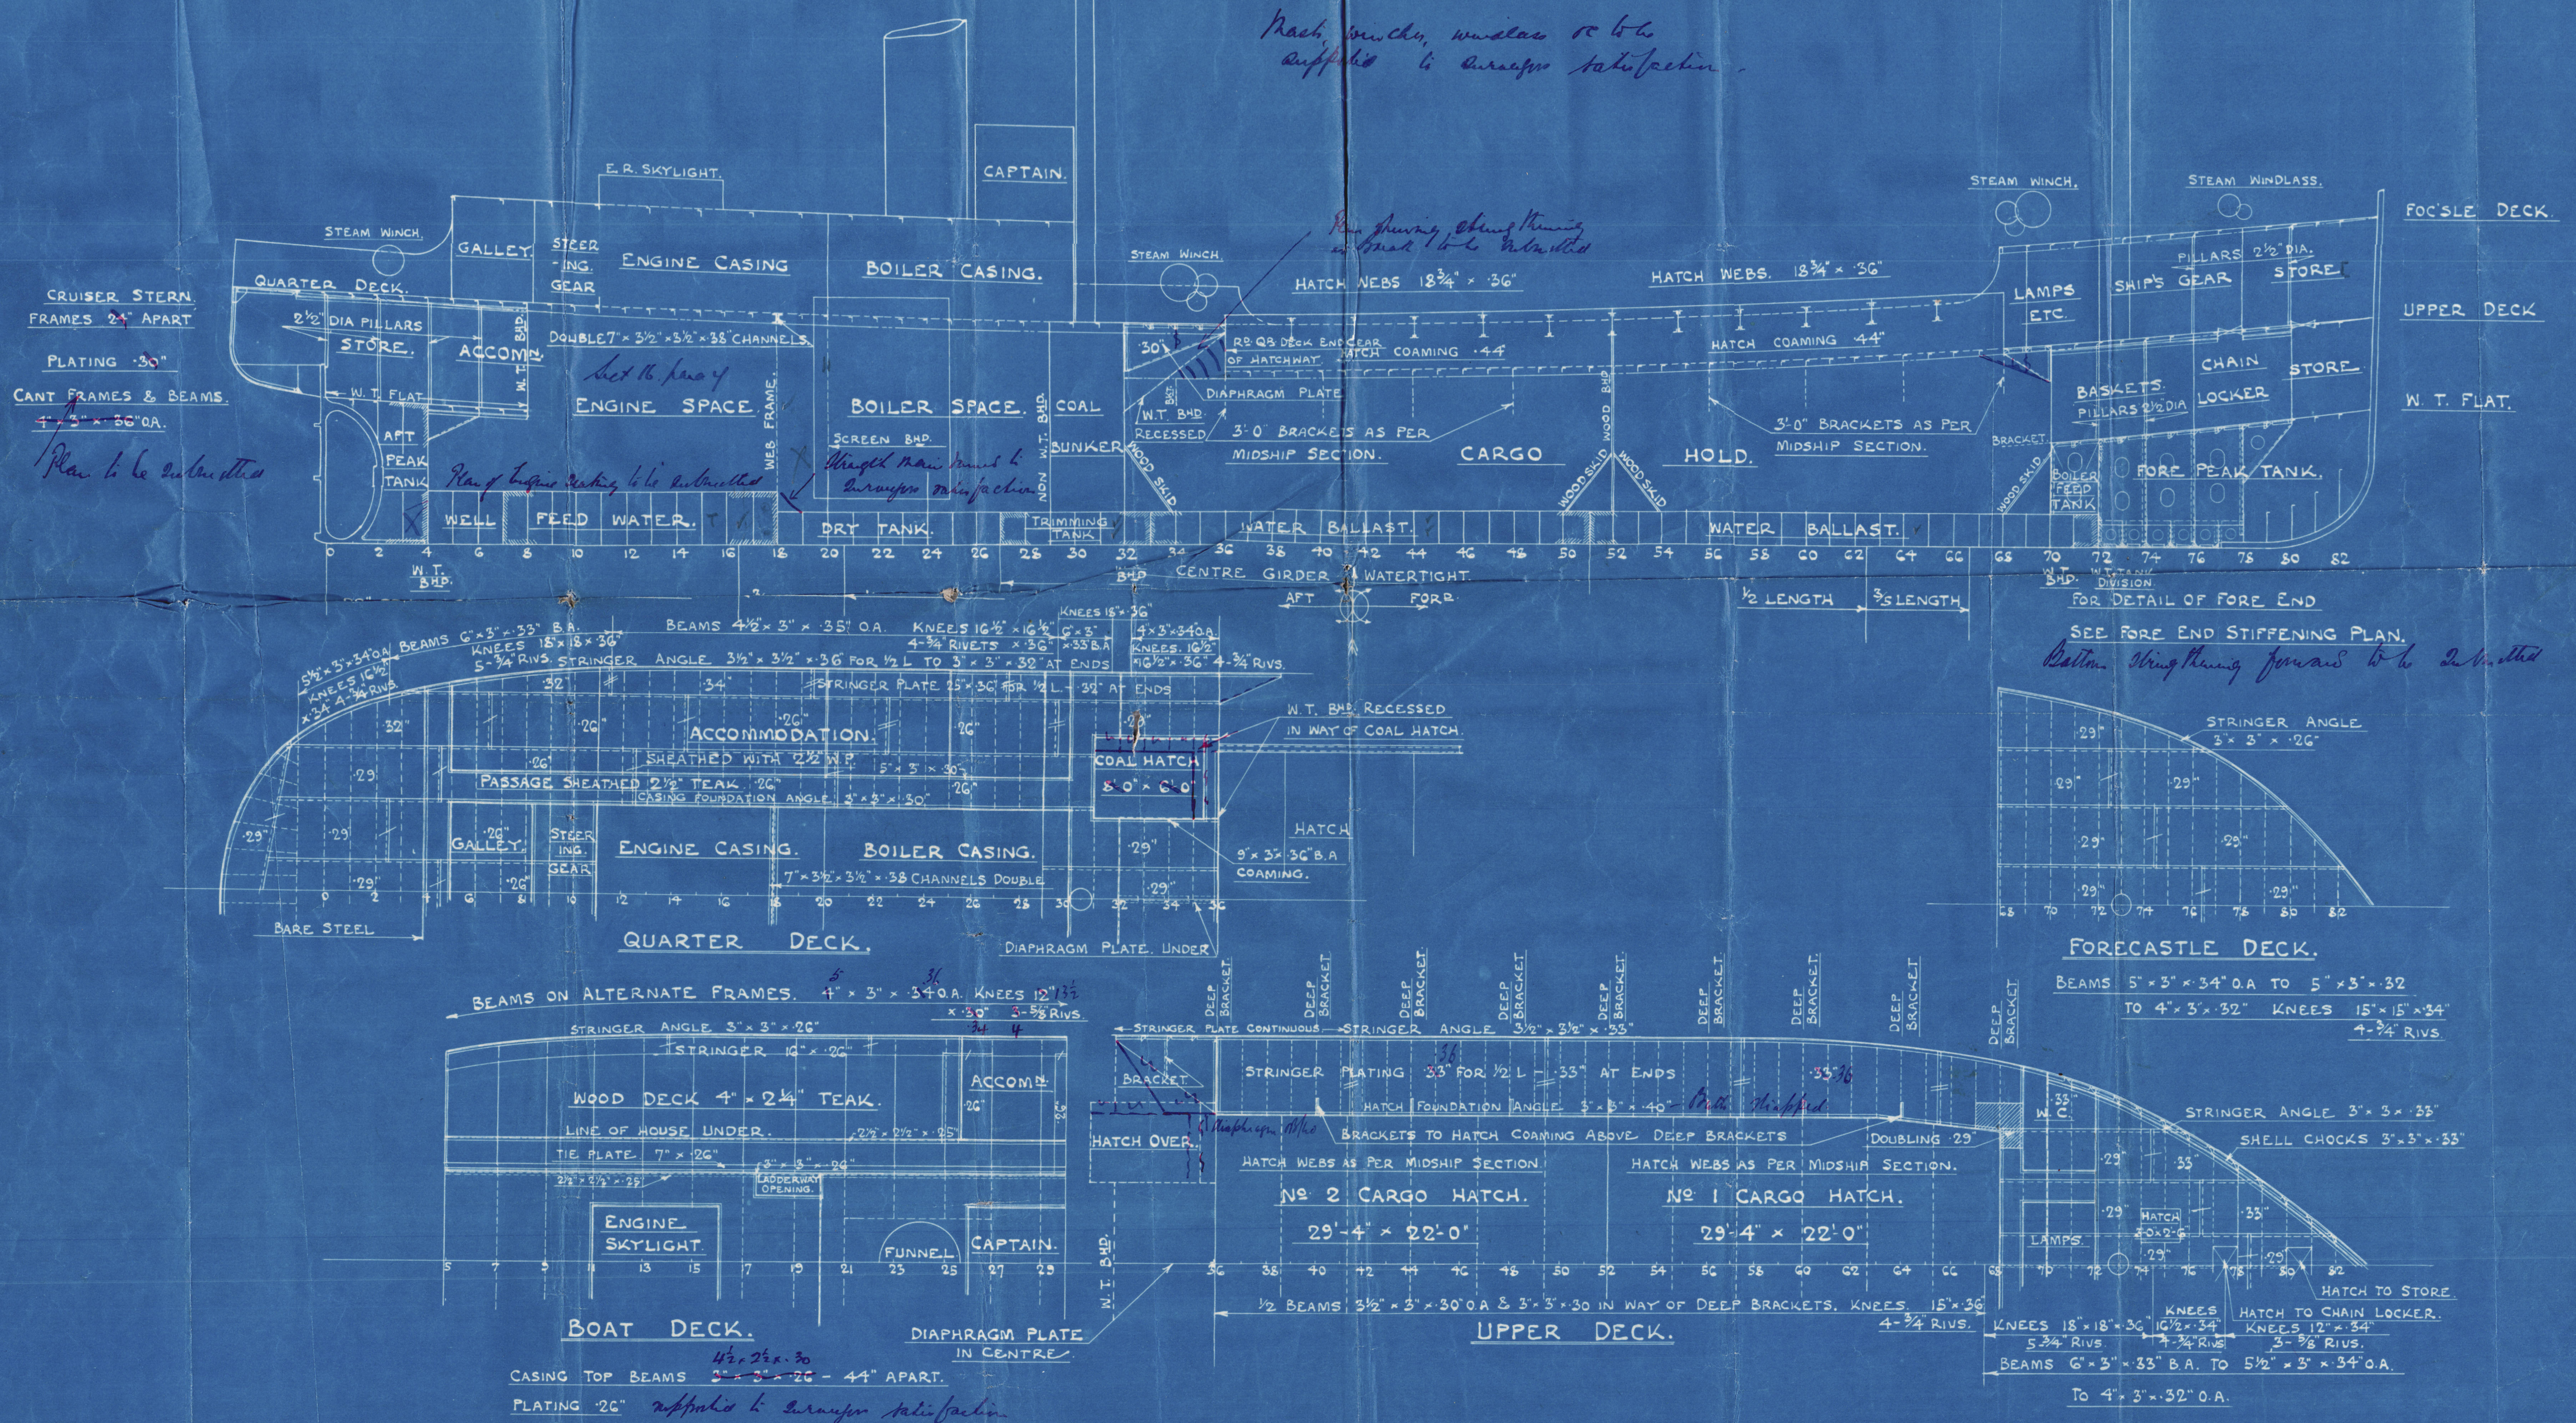


APPROVED

LLOYDS REGISTER OF SHIPPING

*Handwritten signature*

18-2-30

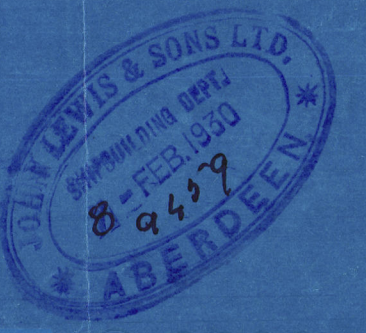

004612-004620-0136



Lloyd's Register Foundation



Nº. 122.

J. Lewis & Sons Ltd.

Profils & Becks.

S.S. "BIRCHGROVE"

abw. Report. 16346

✓

RETAIN

© 2020

Revised Plan.

Amended F.E.

Lloyd's Register

004612-004626-0136