
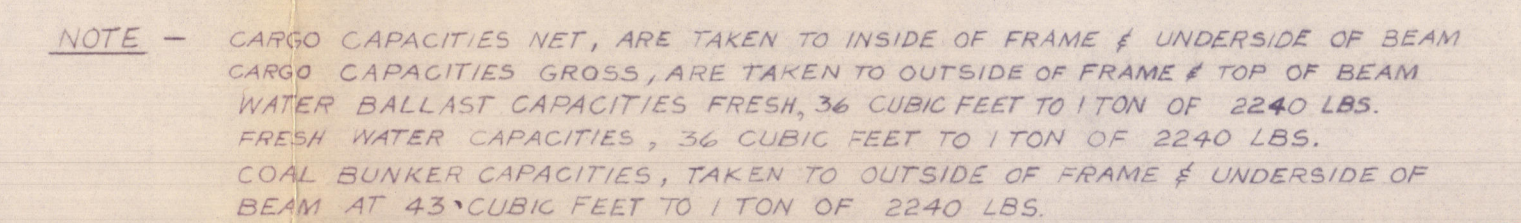


SCALE $\frac{1}{16}'' = 1 \text{ FOOT}$

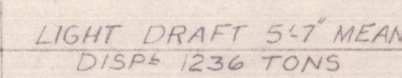

NOTE : ACCOMMATION ADDED AND HATCHES

S.S. WEYBURN HULL N°21

KINGSTON SHIPYARDS

KINGSTON ONTARIO

CAPACITY PLAN

1/16" = 1 FI
H. SLOAN.

© 2020

Lloyd's Register
Foundation

004642-004645-0128