

# PRINCIPAL DIMENSIONS


LENGTH	OVER ALL	± 43.40 M	142'-5"
"	BETW. P.P.	± 40.00 "	131'-0"
BREADTH	MID	± 7.95 "	26'-0"
DEPTH		± 2.60 "	8'-6"
DRAFT		± 2.20 "	7'-4"

7.77  
7.33  
1.44

CLASS: LLOYDS REGISTER OF SHIPPING  
100 A.I. FOR SPECIAL TRADE IN BRISTOL CHANNEL

100 A.I. "Hopper Dredger" "For Service in the Bristol Channel"  
"Fitted for carrying and pumping sand"

Particulars of Equipment to be submitted

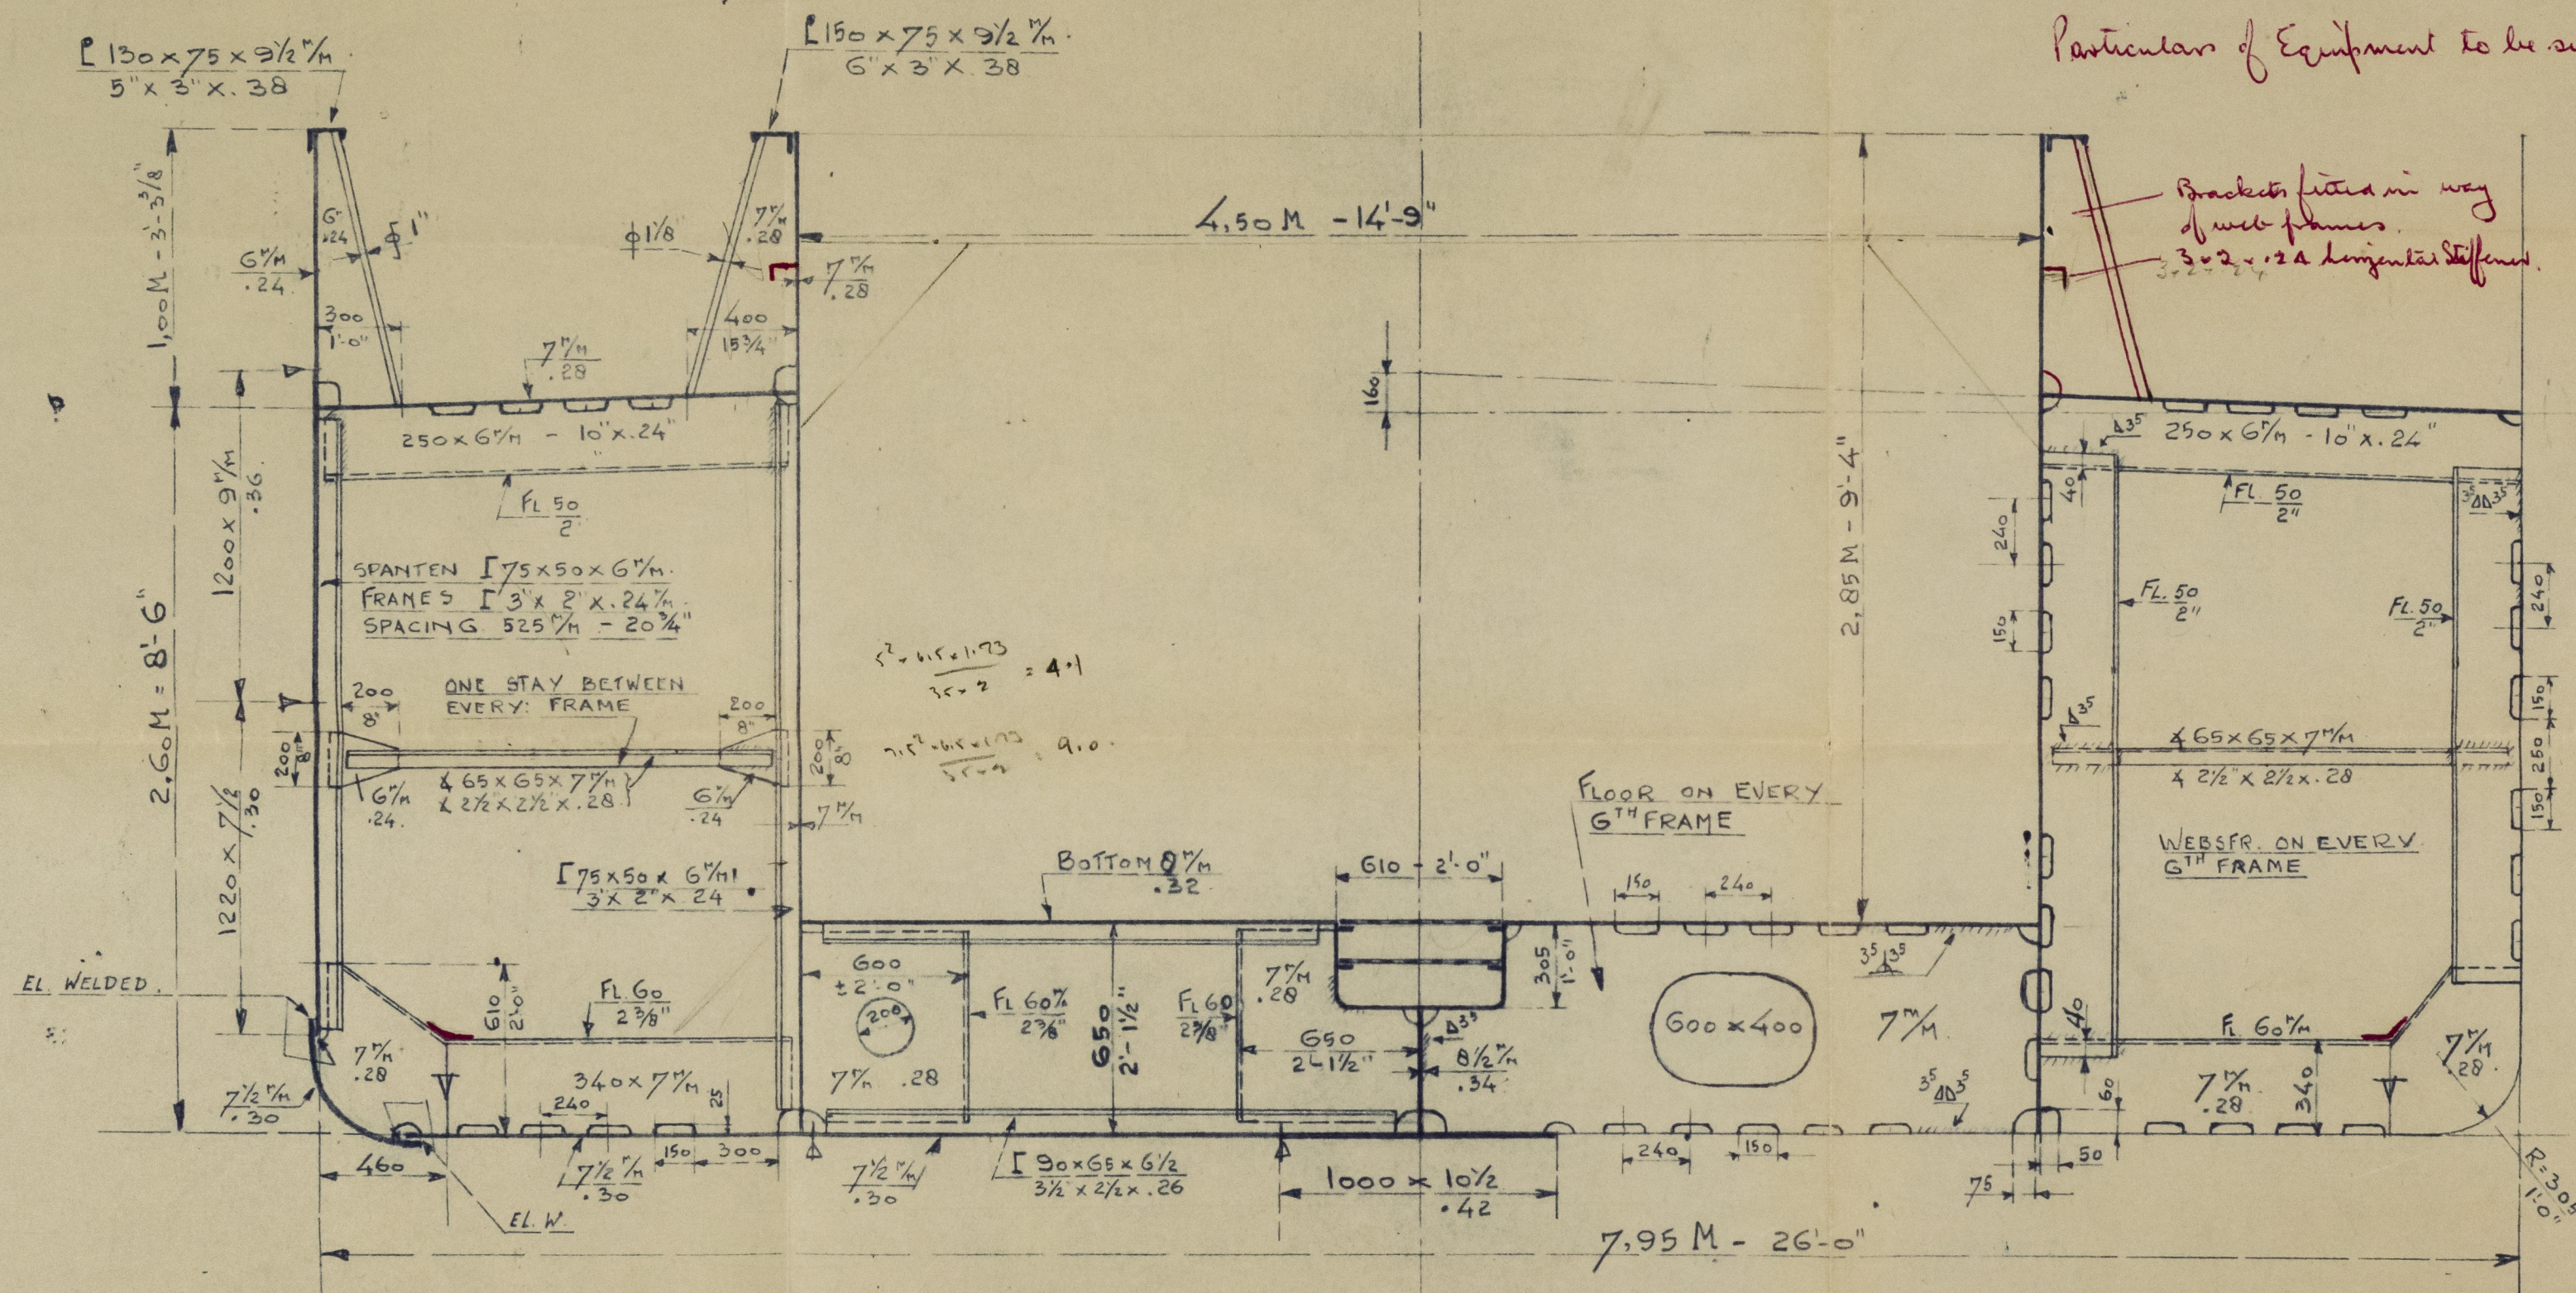

N.V. SCHEEPSWERF GEBR. VAN DER WERF	
DEEST BI. NIMEGEN HOLLAND	
SCHAAL	1:20
GETEEKEND	Only
GEALOUKEERD	
DATUM	26-1-55
AFGEGEVEN	
VERZONDEN	1-2-55
ONTVANGEN	
GEWUZZIGD	
TEEK. N <sup>o</sup>	2
Bouw N <sup>o</sup>	261

GROOTSPANT

MIDSHIP SECTION

HOPPER DREDGER

© 2021

Lloyd's Register

Foundation

004646-104652-0176



"STAN WOOLAWAY" ★

Midship Section

RECORDS DEPT.,  
LONDON.

4

SCHIEDSMAK VAN DER WERK

Yard No 261 (Hopper  
Dredger)

MIDSHIP SECTION



© 2021

Lloyd's Register  
Foundation

004646-004652-0176