

EQUIPMENT (LETTER e)

18 MEI 1955

- 2 STOCKLESS BOWER ANCHORS 405 KG. EACH.
- 1 STREAM ANCHOR 115 KG (EX STOCK).
- 275 M. STUD LINK CHAIN CABLE DIAM. 23 1/2 MM.
- 90 M. STREAM WIRE (6x12) CIRCUMF. 2 1/2".
- 145 M. TOWLINE (6x12) CIRCUMF. 2 1/4".
- 2 MOORING ROPES, EACH 165 M. (6x12) CIRCUMF. 1 1/2".

PRINCIPAL DIMENSIONS


LENGTH OVER ALL	± 43.40 M	142'-5"
" BETW. P.P.	± 40.00 "	131'-0"
BREADTH MLD.	± 7.95 "	26'-0"
DEPTH	± 2.60 "	8'-6"
DRAFT	± 2.20 "	7'-4"

CLASS: LLOYDS REGISTER OF SHIPPING

100 A.I. "HOPPER DREDGER" FOR SERVICE IN THE
BRISTOL CHANNEL" FITTED FOR CARRYING AND PUMPING SAND"

The scantlings as shown and amended are suitable for a summer draught measured from top of keel of 7'-4"


later 7'-9 1/4"

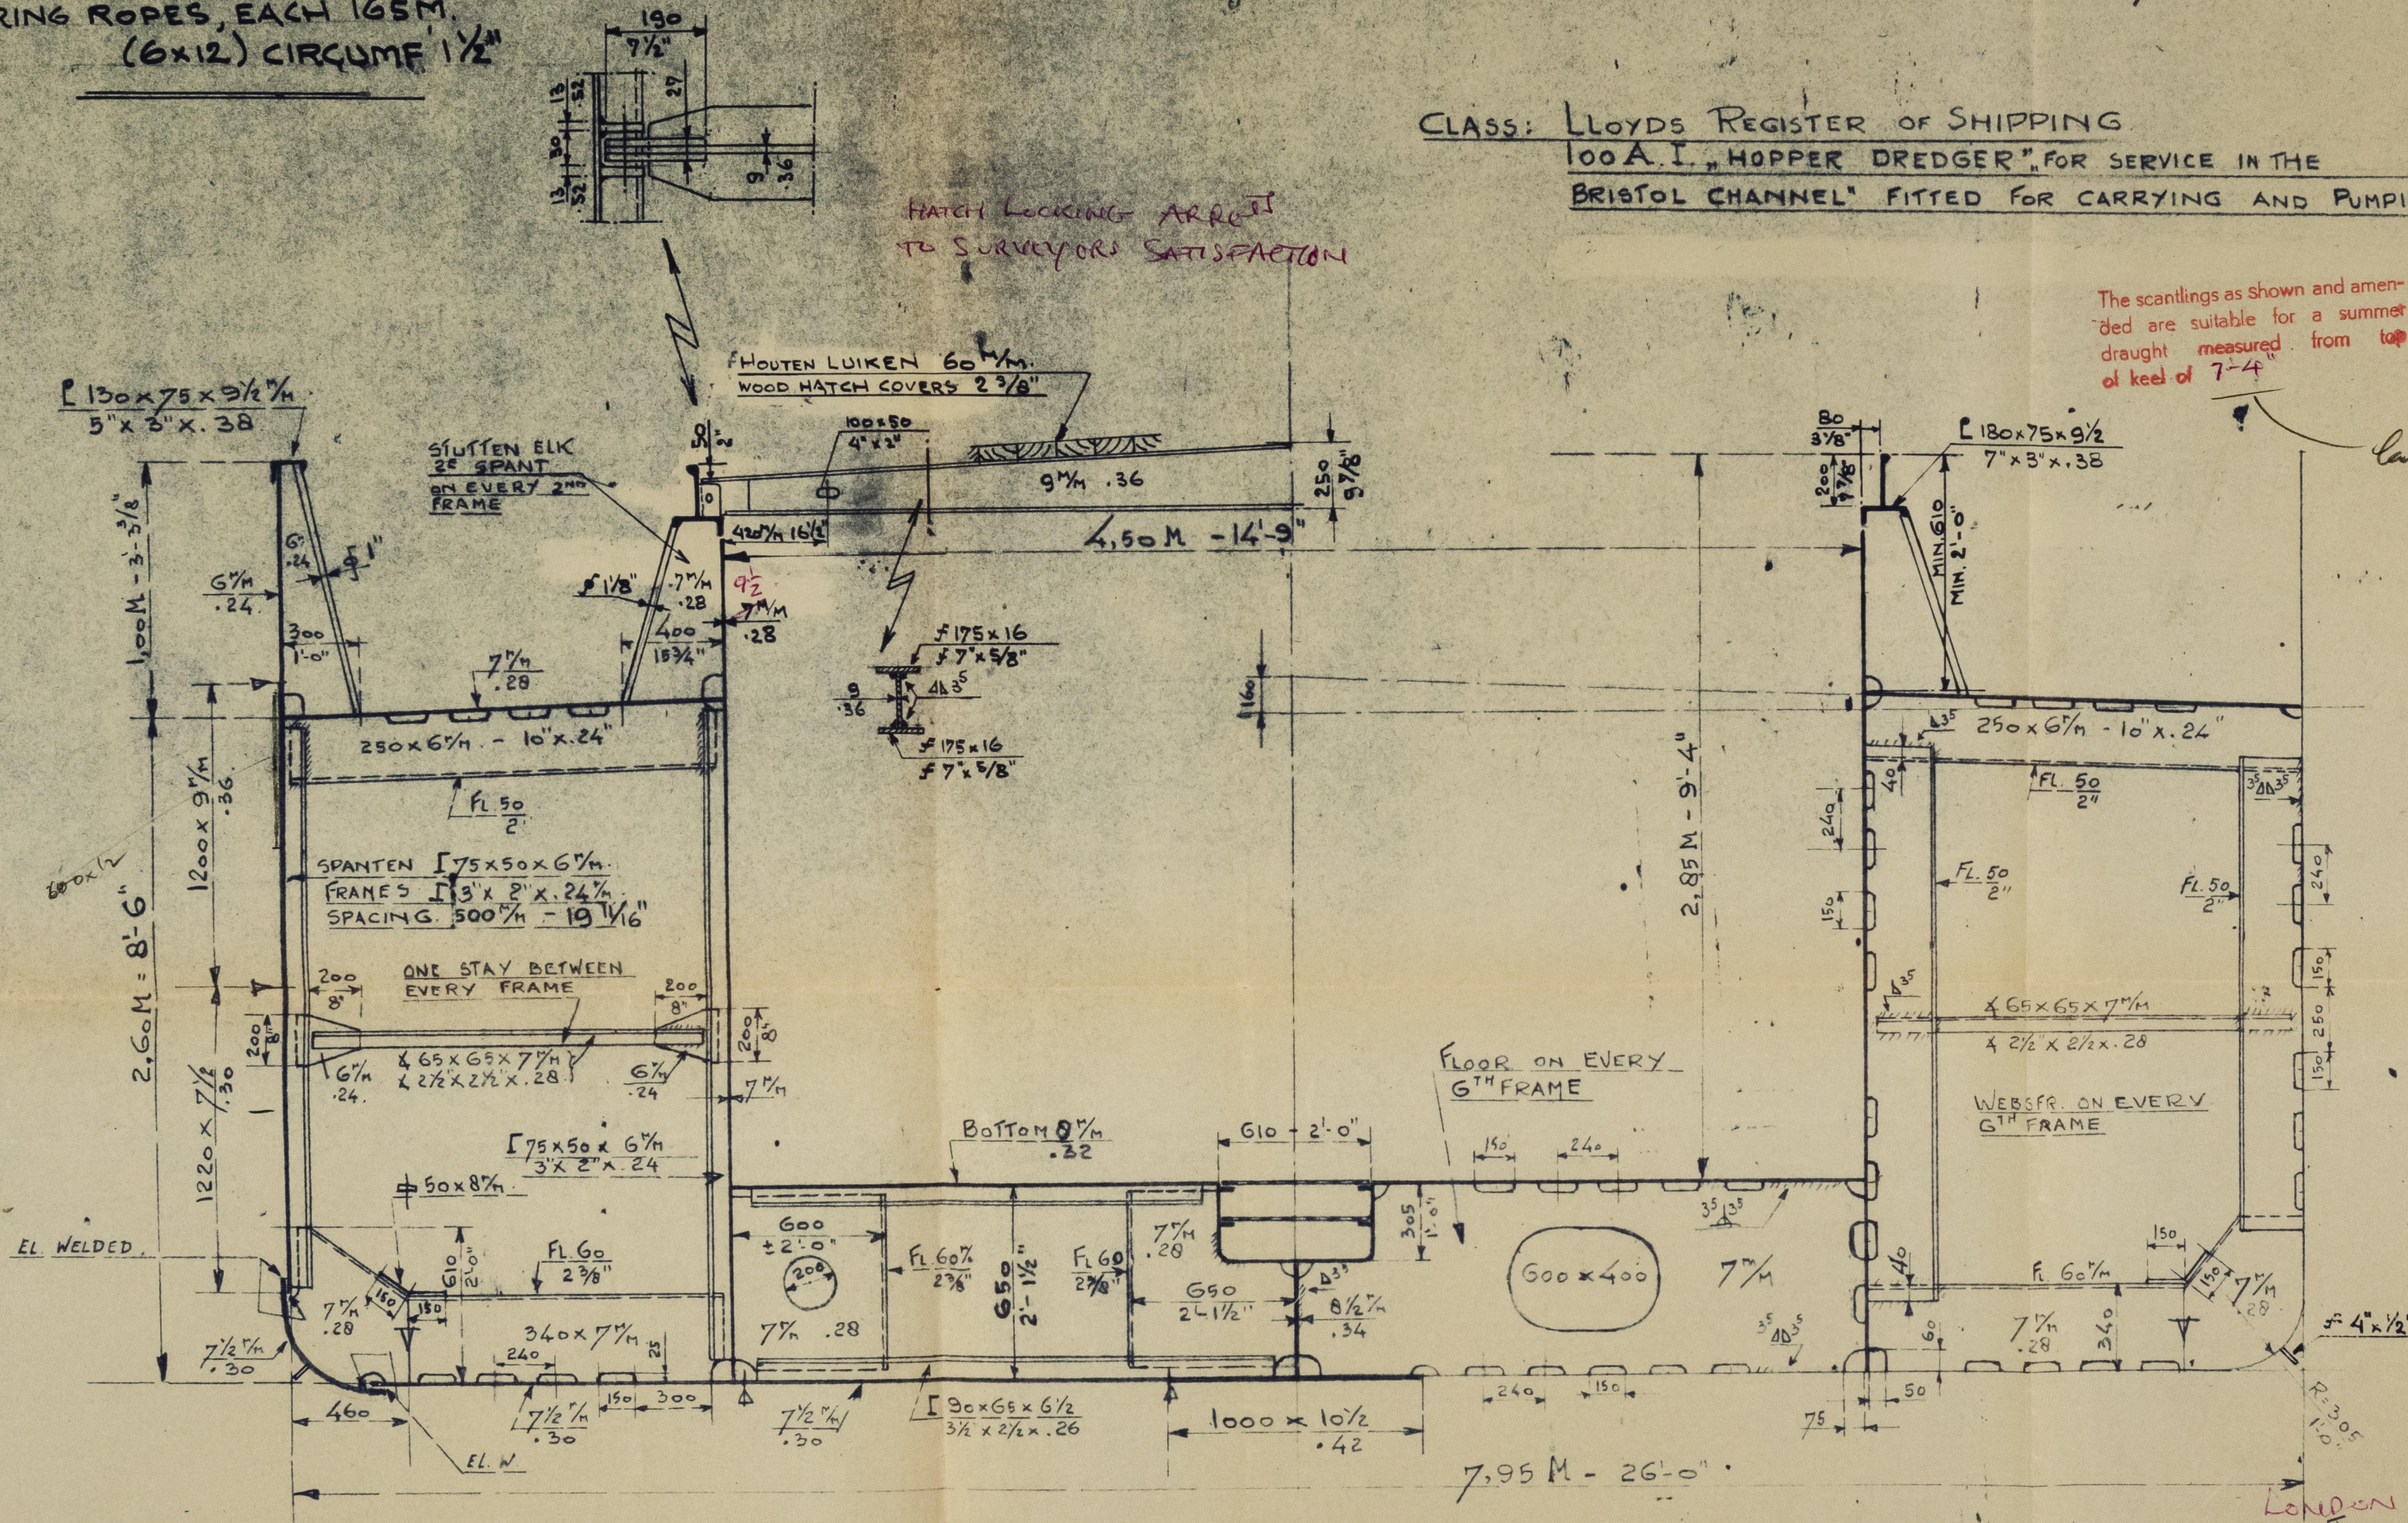

BIJGEWERKT VOLGENS LLOYDS GEKEURDE TEKENING

N.V. SCHEEPSWERF GEBR. VAN DER WERF	
DEEST RIJNMEGEN HOLLAND	
SCHAAL	1:20
GETEKEND	Grootspant
GEVALOUEERD	
DATE	26-1-55
AFGEGEVEN	
VERZONDEN	26-3-55
ONTVANGEN	
GEWIJZIGD	25-3-55

TEEK N° 1-02^B Bouw N° 261

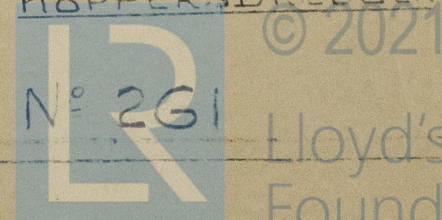

Lloyd's Register Foundation

004646-004652-0177 1/2

BIJGEWERKT VOLGENS LLOYDS GEKEURDE TEKENING

18-5-55

N.V. SCHEEPSWERF GEBR. VAN DER WERF

DEEST

LENDEN

Yard no.: 261

Yard: VAN DER WERF

at: DEEST


Title of Plan:

REVISED MIDSHIP SECTION

PROFILE & DECKS

Rotterdam letter:

18-5-55

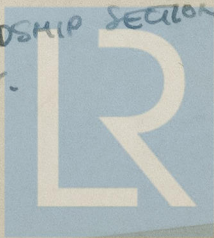

© 2021

Lloyd's Register
Foundation

0177 2/2

004646-004652-0177 1/2

"STAN WOOLAWAY" ★

RECORDS DEPT.
LONDON.

Midship Section.

3

VAN der WERK

Yard No 261

MIDSHIP SECTION

3

004846-004852-0177 1/2



© 2021

Lloyd's Register
Foundation