

GOVT. COPY ISSUED 3 SEP 1956

Rpt. C.11.

OWNERS' C.11 ISSUED 3 SEP 1956

Index No. 23 NOV 1955 45878
(For London Office only.)


Lloyd's Register of Shipping.

SURVEYS FOR FREEBOARD.

(CONDITIONS OF ASSIGNMENT.)

Ship's Name *M/V. STAN WOOLAWAY*Port of Survey *ROTTERDAM*Official Number *184201*Surveyor's Signature *G. J. de Jong*Nationality and Port of Registry *BRITISH - BARNSTAPLE*Date of Survey *BUILDING 1955*

Disposition and dimensions of superstructures, trunks, deckhouses and machinery casings to be inserted in the diagrams and tabular statement:—

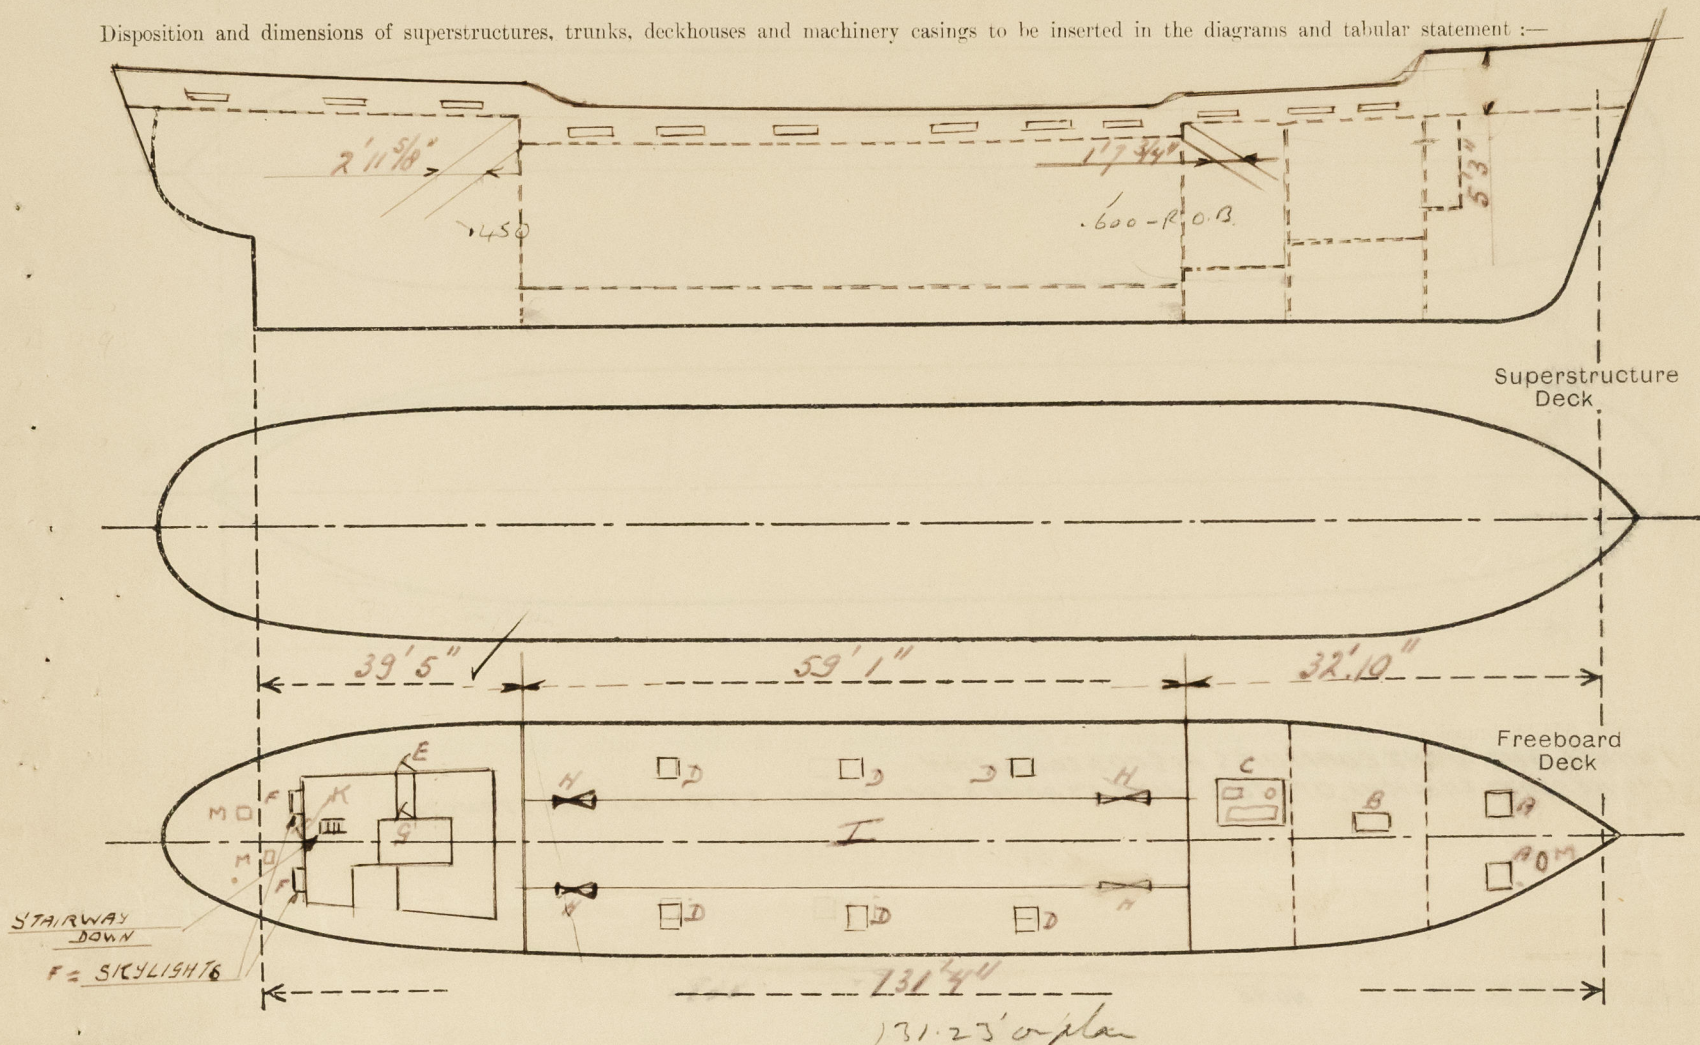

Particulars of Superstructures, Trunks, Casings, Deckhouses.

	Coaming	Plating	Stiffeners	Spacing	End Attachments of Stiffeners	Size of Openings	Height of Sills	Height of Casings
Poop Bulkhead	✓	.28	90 x 75 x 1 1/2 ✓	575 ✓	✓	NONE		
Raised Quarter Deck Bulkhead ...	✓							
Bridge, After Bulkhead	✓							
Bridge, Forward Bulkhead	✓	.28	90 x 75 x 1 1/2 ✓	575 ✓	✓	NONE		
Forecastle Bulkhead								
Trunk, Aft								
Trunk, Forward								
Exposed Machinery Casings on Freeboard or Raised Quarter Decks24	65 x 50 x 6 ✓					
Exposed Machinery Casings on Superstructure Decks		ENCLOSED STEEL DECKHOUSE		500	EN	1700 x 600	230	2100
Machinery Casings within Superstructures not fitted with Class I Closing Appliances								
Deckhouses on Flush Deck Ships ...								

Particulars of Closing Appliances (state if capable of being manipulated from both sides).

Poop Bulkhead	NONE
Raised Quarter Deck Bulkhead ...	
Bridge, After Bulkhead	
Bridge, Forward Bulkhead	
Forecastle Bulkhead	NONE.
Exposed Machinery Casings on Freeboard or Raised Quarter Decks ...	
(Exposed) Machinery Casings on Superstructure Decks	ONE OPENING "9" FL. STEEL PLATE O.B.S. ✓
Machinery Casings within Superstructures not fitted with Class I Closing Appliances	
Deckhouses on Flush Deck Ships ...	




© 2021

Lloyd's Register
Foundation

PARTICULARS OF PROTECTION TO OPENINGS, ETC.

The following diagrams should be used to indicate the positions of cargo and coaling hatchways, gangway, cargo and coaling ports, ventilators, companionways, etc., which would affect the seaworthiness of the ship:—

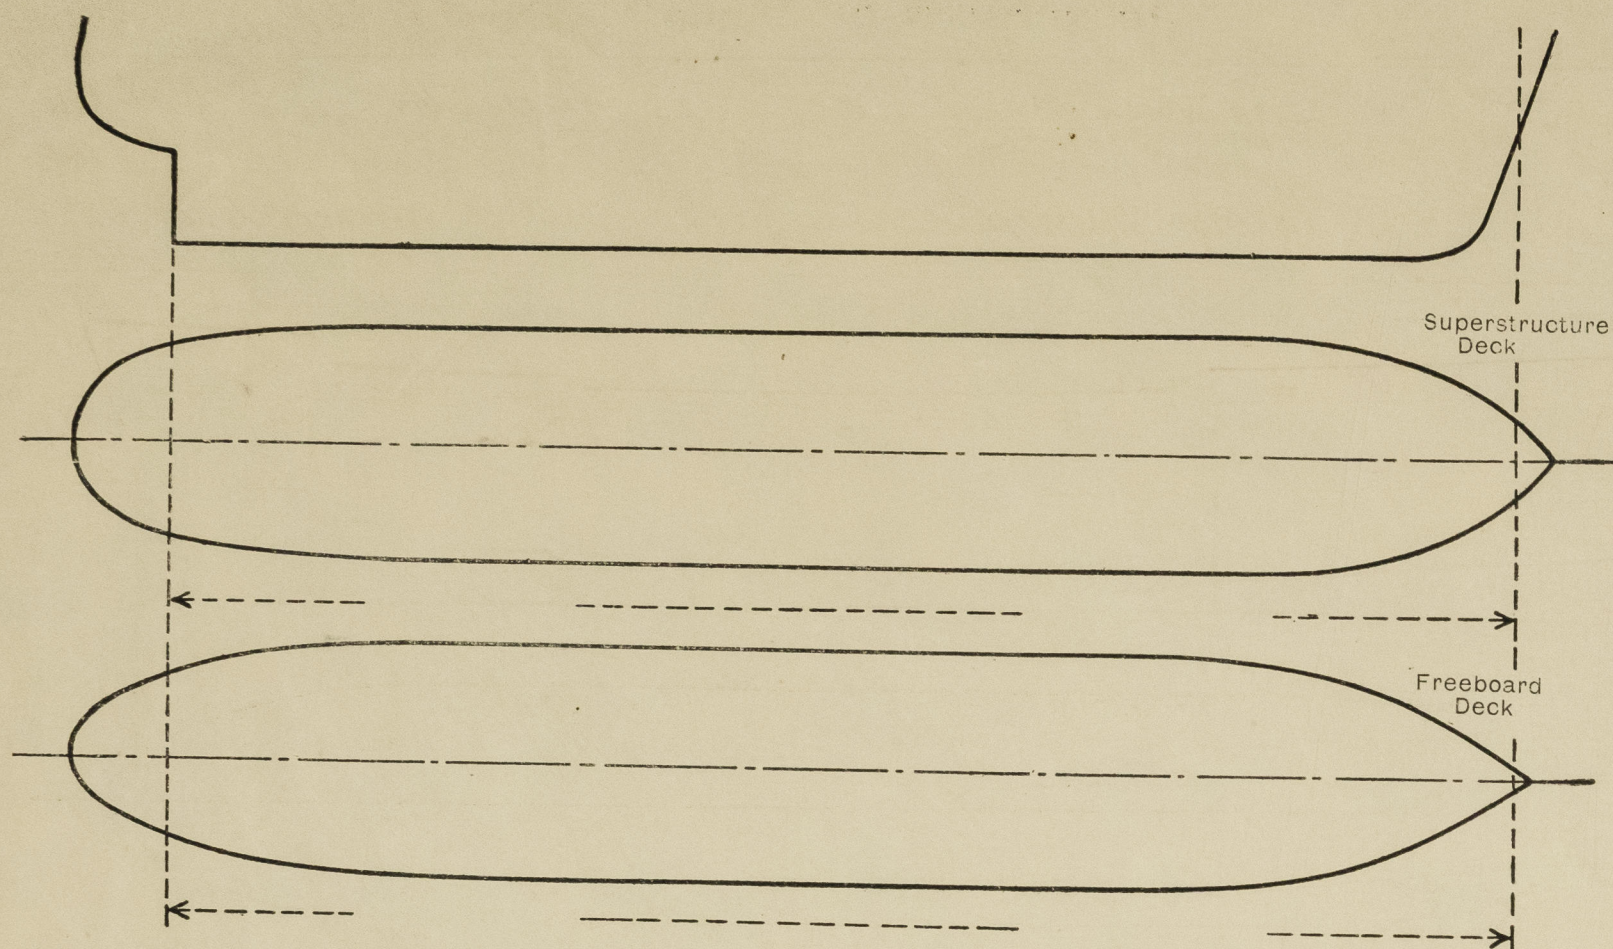

Particulars of fiddle, funnel and ventilator coamings, engine room skylight and other openings in machinery casing tops and their means of closing:—

FUNNEL AND VENT COAMINGS IN GOOD CONDITION
ENGINE ROOM SKYLIGHT OF STEEL WITH STRONG STEEL FLAPS STRONGLY CONSTRUCTED

Particulars of Flush Bunker Scuttles:— *NONE*

Particulars of Companionways:—

ONE STEEL STRONG DECKHOUSE AFT. WITH ONE OPENING 6' 6" x 15' 0" SILL 1' 6" WITH PLATE STEEL FL DOOR O.B.S.
ONE OPENING 12' 6" LEADING TO CREWSPACE DOOR. 6' 6" x 15' 0" SILL 1' 6" WITH HARDWOOD DOOR O.B.S.

Particulars of Ventilators in exposed positions on freeboard and superstructure decks:—

TORPEDO (MUSHROOM) VENTILATOR ON EACH CABIN.

Particulars of Air Pipes in exposed positions on freeboard, raised quarter, or superstructure decks:—

ALL AIRPIPES 3' ABOVE FREEBOARD DECK
AIRPIPES OF OILTIGHTS FITTED WITH WIRE GAUGE & CANVAS COVERS.
WOODEN PLUGS AND CANVAS COVERS AVAILABLE

Particulars of Gangway Cargo and Coaling Ports:—

NONE

Particulars of Scuppers and Sanitary Discharge Pipes:—

ALL SANITARY DISCHARGES ON FREEBOARD DECK ONLY
LEADING TO SHIP SIDES WITH S.D.H.V. CONTROLLED FROM
UPPER DECK WITH INDICATOR

Particulars of Side Scuttles:—

ABOVE FREEBOARD DECK ONLY

Vertical distance of Sill of lowest Side Scuttle above top of keel:—

Particulars of Guard Rails:— *CLOSED BULWARK 3' 3 1/2" x 1/2" THICK SUFF SUPPORTED*

Particulars of Gangways, Lifelines, etc.:— *NONE*

LIFELINES FITTED FORE & AFT.

Particulars of Freeing Arrangements.

	Length of Bulwark	Height of Bulwark	Size of Freeing Ports	Number each side	Area each side	Rule area each side
After Well ... <i>POOP</i> ...	<i>39' 5"</i>	<i>3' 3 1/2"</i>	<i>4' 7 1/2" x 9"</i>	<i>3</i>	<i>10.32</i>	
<i>FREEB. DECK</i>	<i>59' 1"</i>	<i>3' 3 1/2"</i>	<i>4' 7 1/2" x 9"</i>	<i>6</i>	<i>20.64</i>	<i>11.82</i>
Forward Well ... <i>FLG</i> ...	<i>32' 10"</i>	<i>3' 3 1/2"</i>	<i>4' 7 1/2" x 9"</i>	<i>3</i>	<i>10.32</i>	

State position of each freeing port ... { After Well:—
(F. and A. position and height above deck edge) { Forward Well:—


OPEN 3"

State whether the freeing ports are fitted with shutters, bars, or rails, and give particulars of such:—

Additional area where sheer is less than standard.

Stan Woolaway.

PARTICULARS OF PROTECTION TO OPENINGS, ETC.

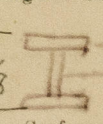HATCHWAYS ON FREEBOARD AND SUPERSTRUCTURE DECKS.									
Description of Hatchway			I	A	B	C	D	H	M
Dimensions of Hatchway			59' x 14' 9"	1' 11" x 17' 1/2"	3' 2" x 3' 2"	6' 7" x 3' 2"			
COAMINGS	Height above Deck	...	2' ✓	24"	2' 11" ✓	3' 2" ✓			
	Thickness	{ Sides36	.36	.36			
		{ Ends	...						
	Stiffeners						
Brackets, Stays			...						
			FL STEEL PLATE .20 ✓						
HATCH BEAMS	Number	...	11 ✓						
	Spacing	...	4' 11" ✓						
	Scantling and Sketch	...							
	Bearing Surface	...	7 3/8" x .64 ✓ 8 1/2" x .36 ✓ 7 1/2" x .64 ✓ 3" ✓						
FORE AND AFTERS	Number	...							
	Spacing	...							
	Unsupported Lengths	...							
	Scantling* and Sketch	...							
Bearing Surface			...						
HATCH COVERS	Material	...	ONE ✓						
	Thickness	...	2 1/2" ✓						
	How fitted	...	F.A. ✓						
	Bearing Surface	...	3" ✓						
Spacing of Cleats			...						
Number of Tarpaulins			...						
			NOT EXCEEDING 4' ✓						
			2 ✓						
<p>*Are wood fore and afters steel shod at all bearing surfaces? ✓</p> <p>Are battens and wedges efficient and in good condition? YES ✓</p> <p>Are tarpaulins in good condition and in accordance with rule requirements? YES ✓</p> <p>Are lashings provided in accordance with rule requirements? LASHING ROPS. ✓</p>									

Particulars of any special features:—



© 2021

Lloyd's Register Foundation