

19 MAY 1949

Index No.

36306

## Lloyd's Register of Shipping.

Ship's Name

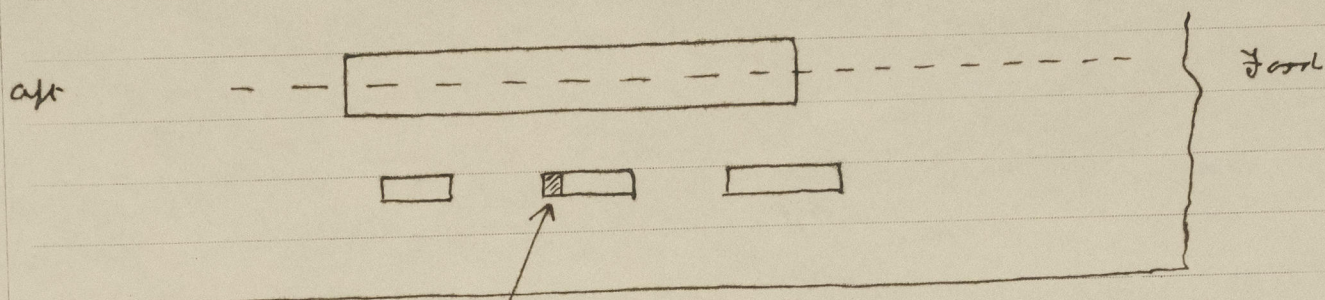
"ITOLA"

Official No.

167619

Memorandum of alterations reported since ship was surveyed for assignment of Load Lines in ✓

alteration in coaling hatch on foreboard deck  
abreast casings starboard side consequent on  
vessel being converted to oil fuel burning.

UPPER D<sup>5</sup> STAIR<sup>D</sup>

Length of hatch shortened from 11ft to 10ft.

Deck subsequently plated over for 12" and 9" B.A.  
Criming removed & fitted in new position complete  
with all bolting arrangements, closing appliances,  
and tarpaulins as previously reported in C11 Form.

Non return valve fitted to shell in turret recess for  
fire pump supply. Valve geared to foreboard deck  
with indicator showing when open & closed.

*W. F. Crain*  
9.5.49.

G.H.W.  
20 MAY 1949