


PLAN No 66.
R.F.A. "SPABECK"

GENERAL ARRANGEMENT. (AS FITTED)


SCALE 1/4 INCH = ONE FOOT.

AMITY RECORD.

PROFILE.

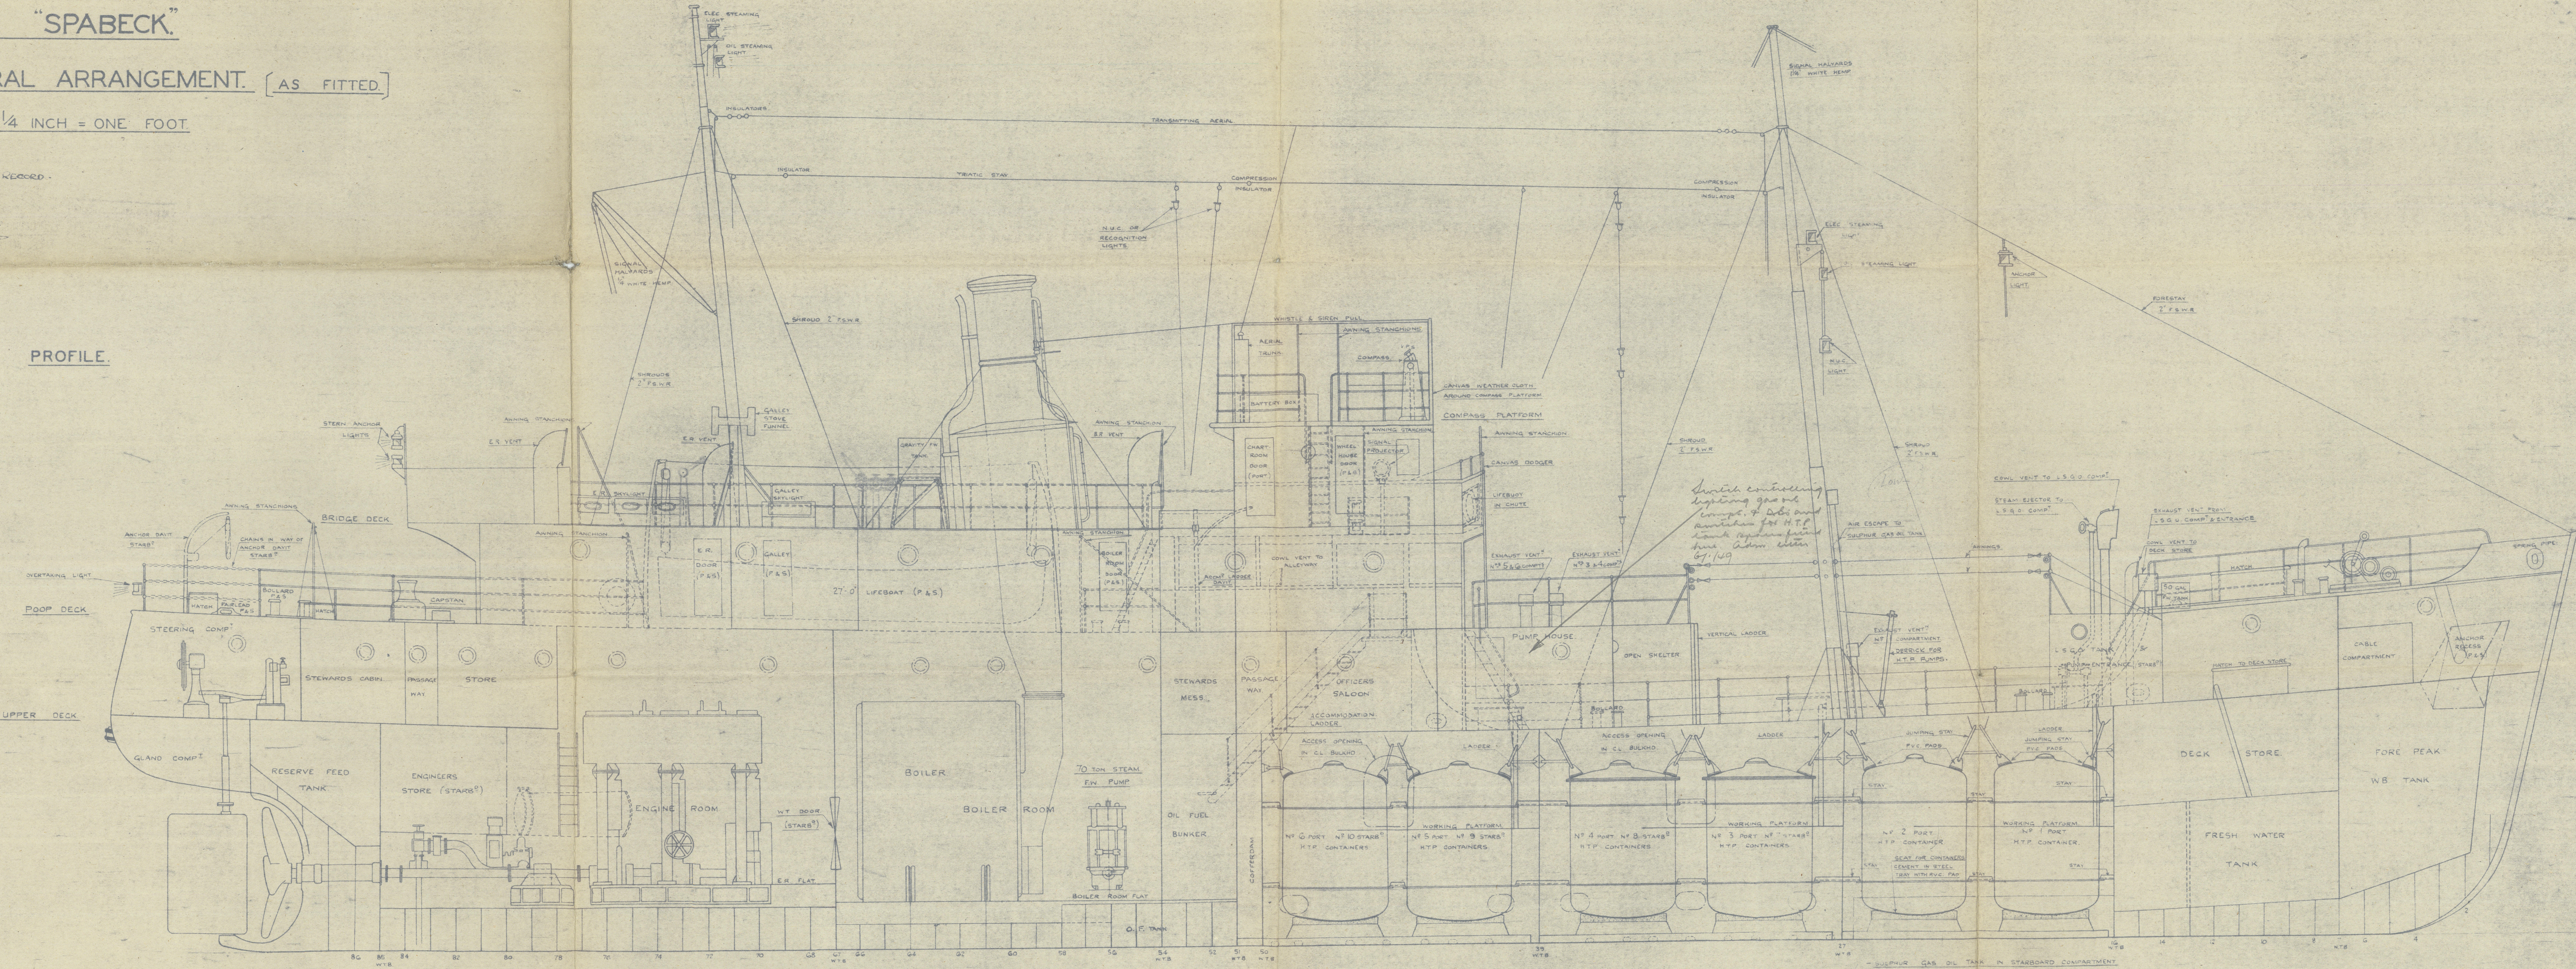

BRIDGE DECK.

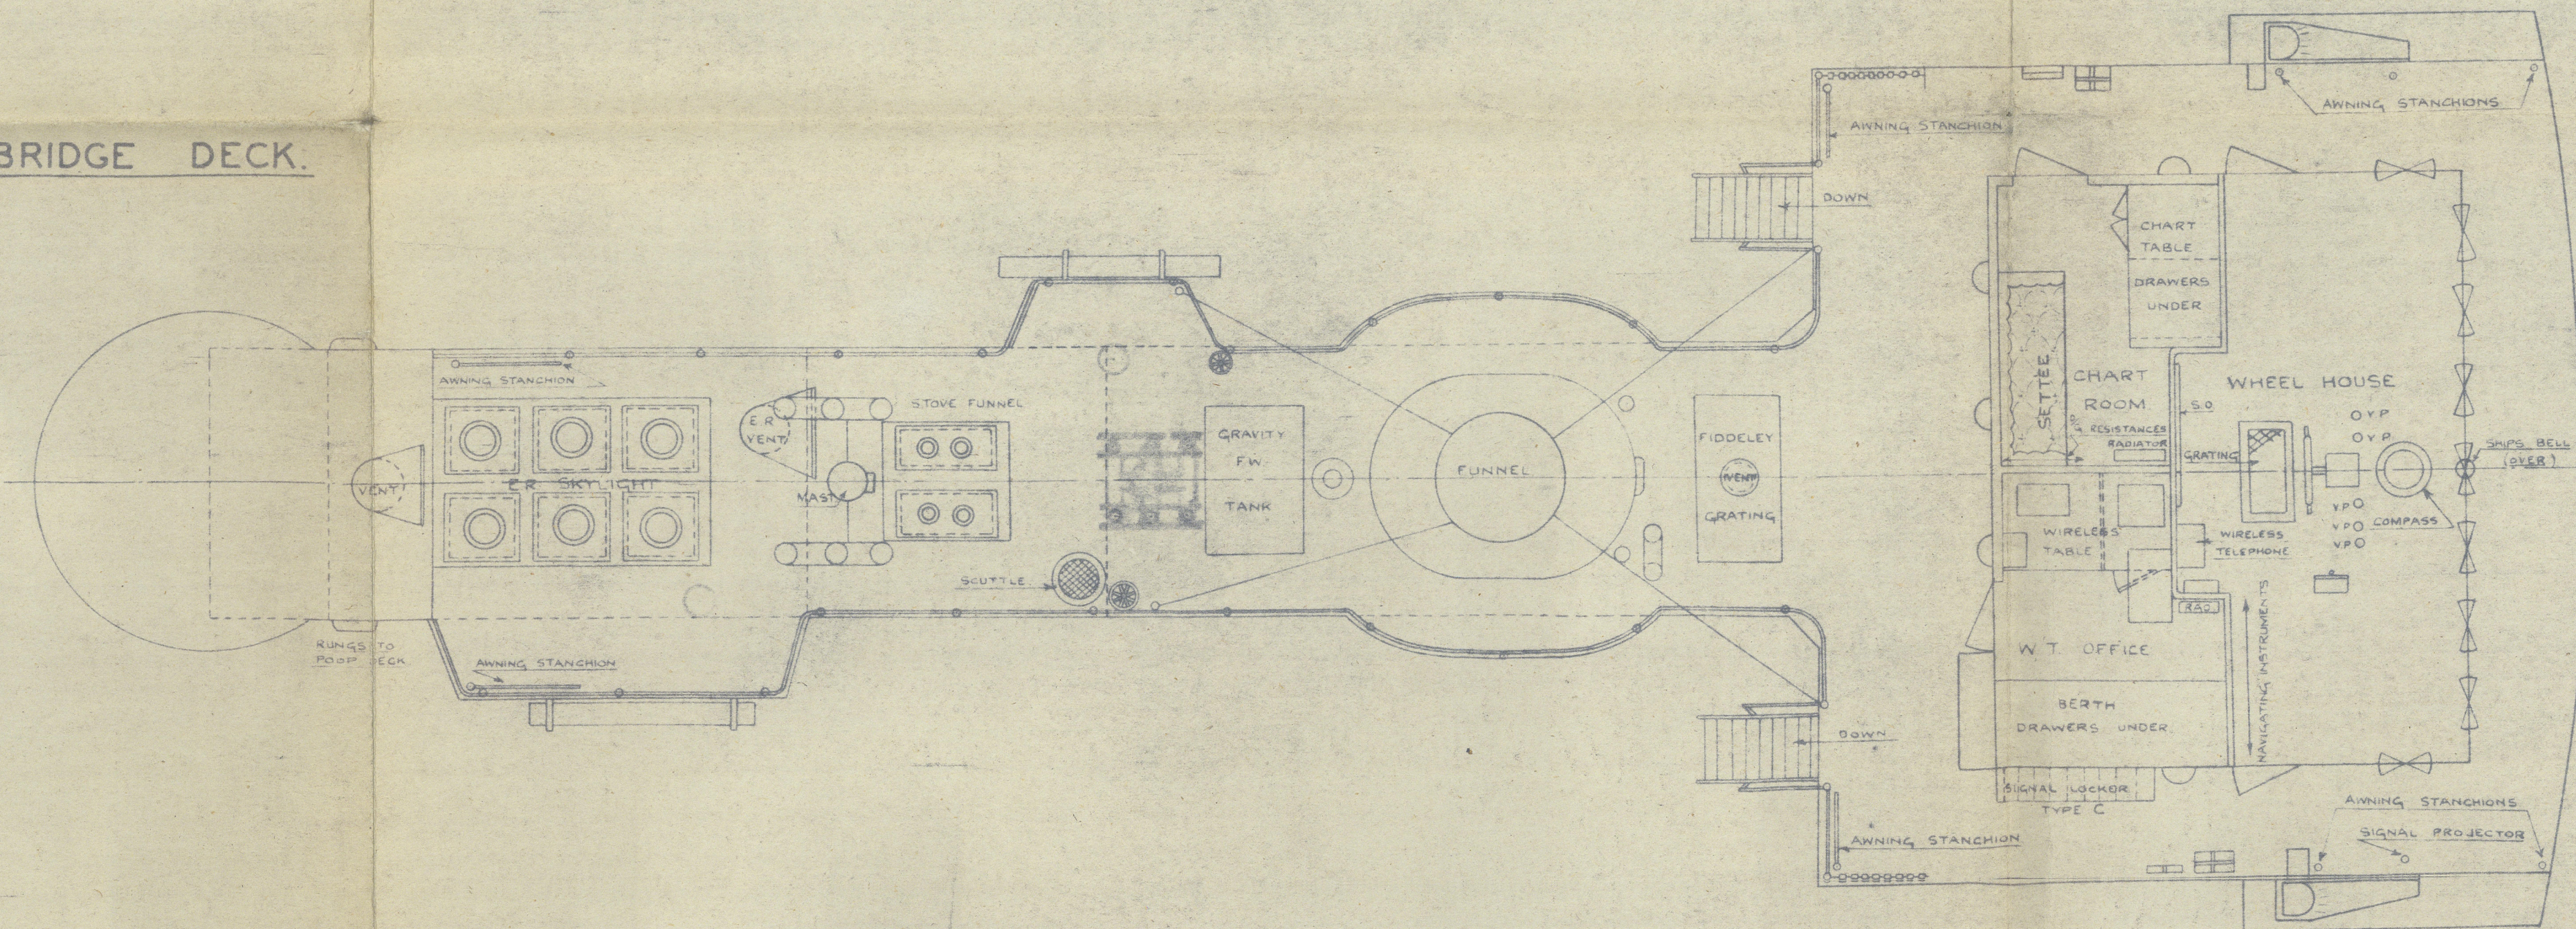

COMPASS PLATFORM.

