

"SANGOLÄ".


Robert 1/2 hr Ferguson 2
" 1/2 hr Macdonald 1

SEE SPEC. Pgs 35 & 37.

- MATERIAL

CHECK ON TEMPLATE DEMAND

CHECK ON LEADERS					
PORT - STRINGER	N ^o ①	1 -	10'-6" x 5'-4" x .64	JAPAN	
PORT - "	N ^o ⑩	1 -	12'-0" x 5'-4" x .43	JAPAN	
P.C.S. D STRAKE	N ^o ⑩	1 -	28'-6" x 7'-0" x .58	GERM.	
PORT - C "	N ^o ⑩	1 -	17'-0" x 7'-0" x .44	JAPAN	
STARBOARD - STRINGER	N ^o ③	1 -	14'-0" x 5'-4" x .64	JAPAN	
STARBOARD - C "	N ^o ⑩	1 -	19'-6" x 7'-0" x .52	GERM.	
CORNER DOUBLINGS		2 -	9'-0" x 3'-3" x 7/16"	GERM.	

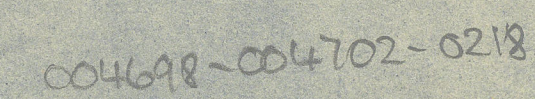

Upper Dk. Prop.

No 7

Alterations to Upper Dk.

"Angola."



© 2021

Lloyd's Register
Foundation