


SCALE  $\frac{1}{2}" = \text{ONE FOOT.}$

— RIVETING NOTES —



FRAMES SPACED  $23\frac{1}{2}$ " APART T TO 12 & 102 TO 116  
Do Do 27" APART 12 TO 102.

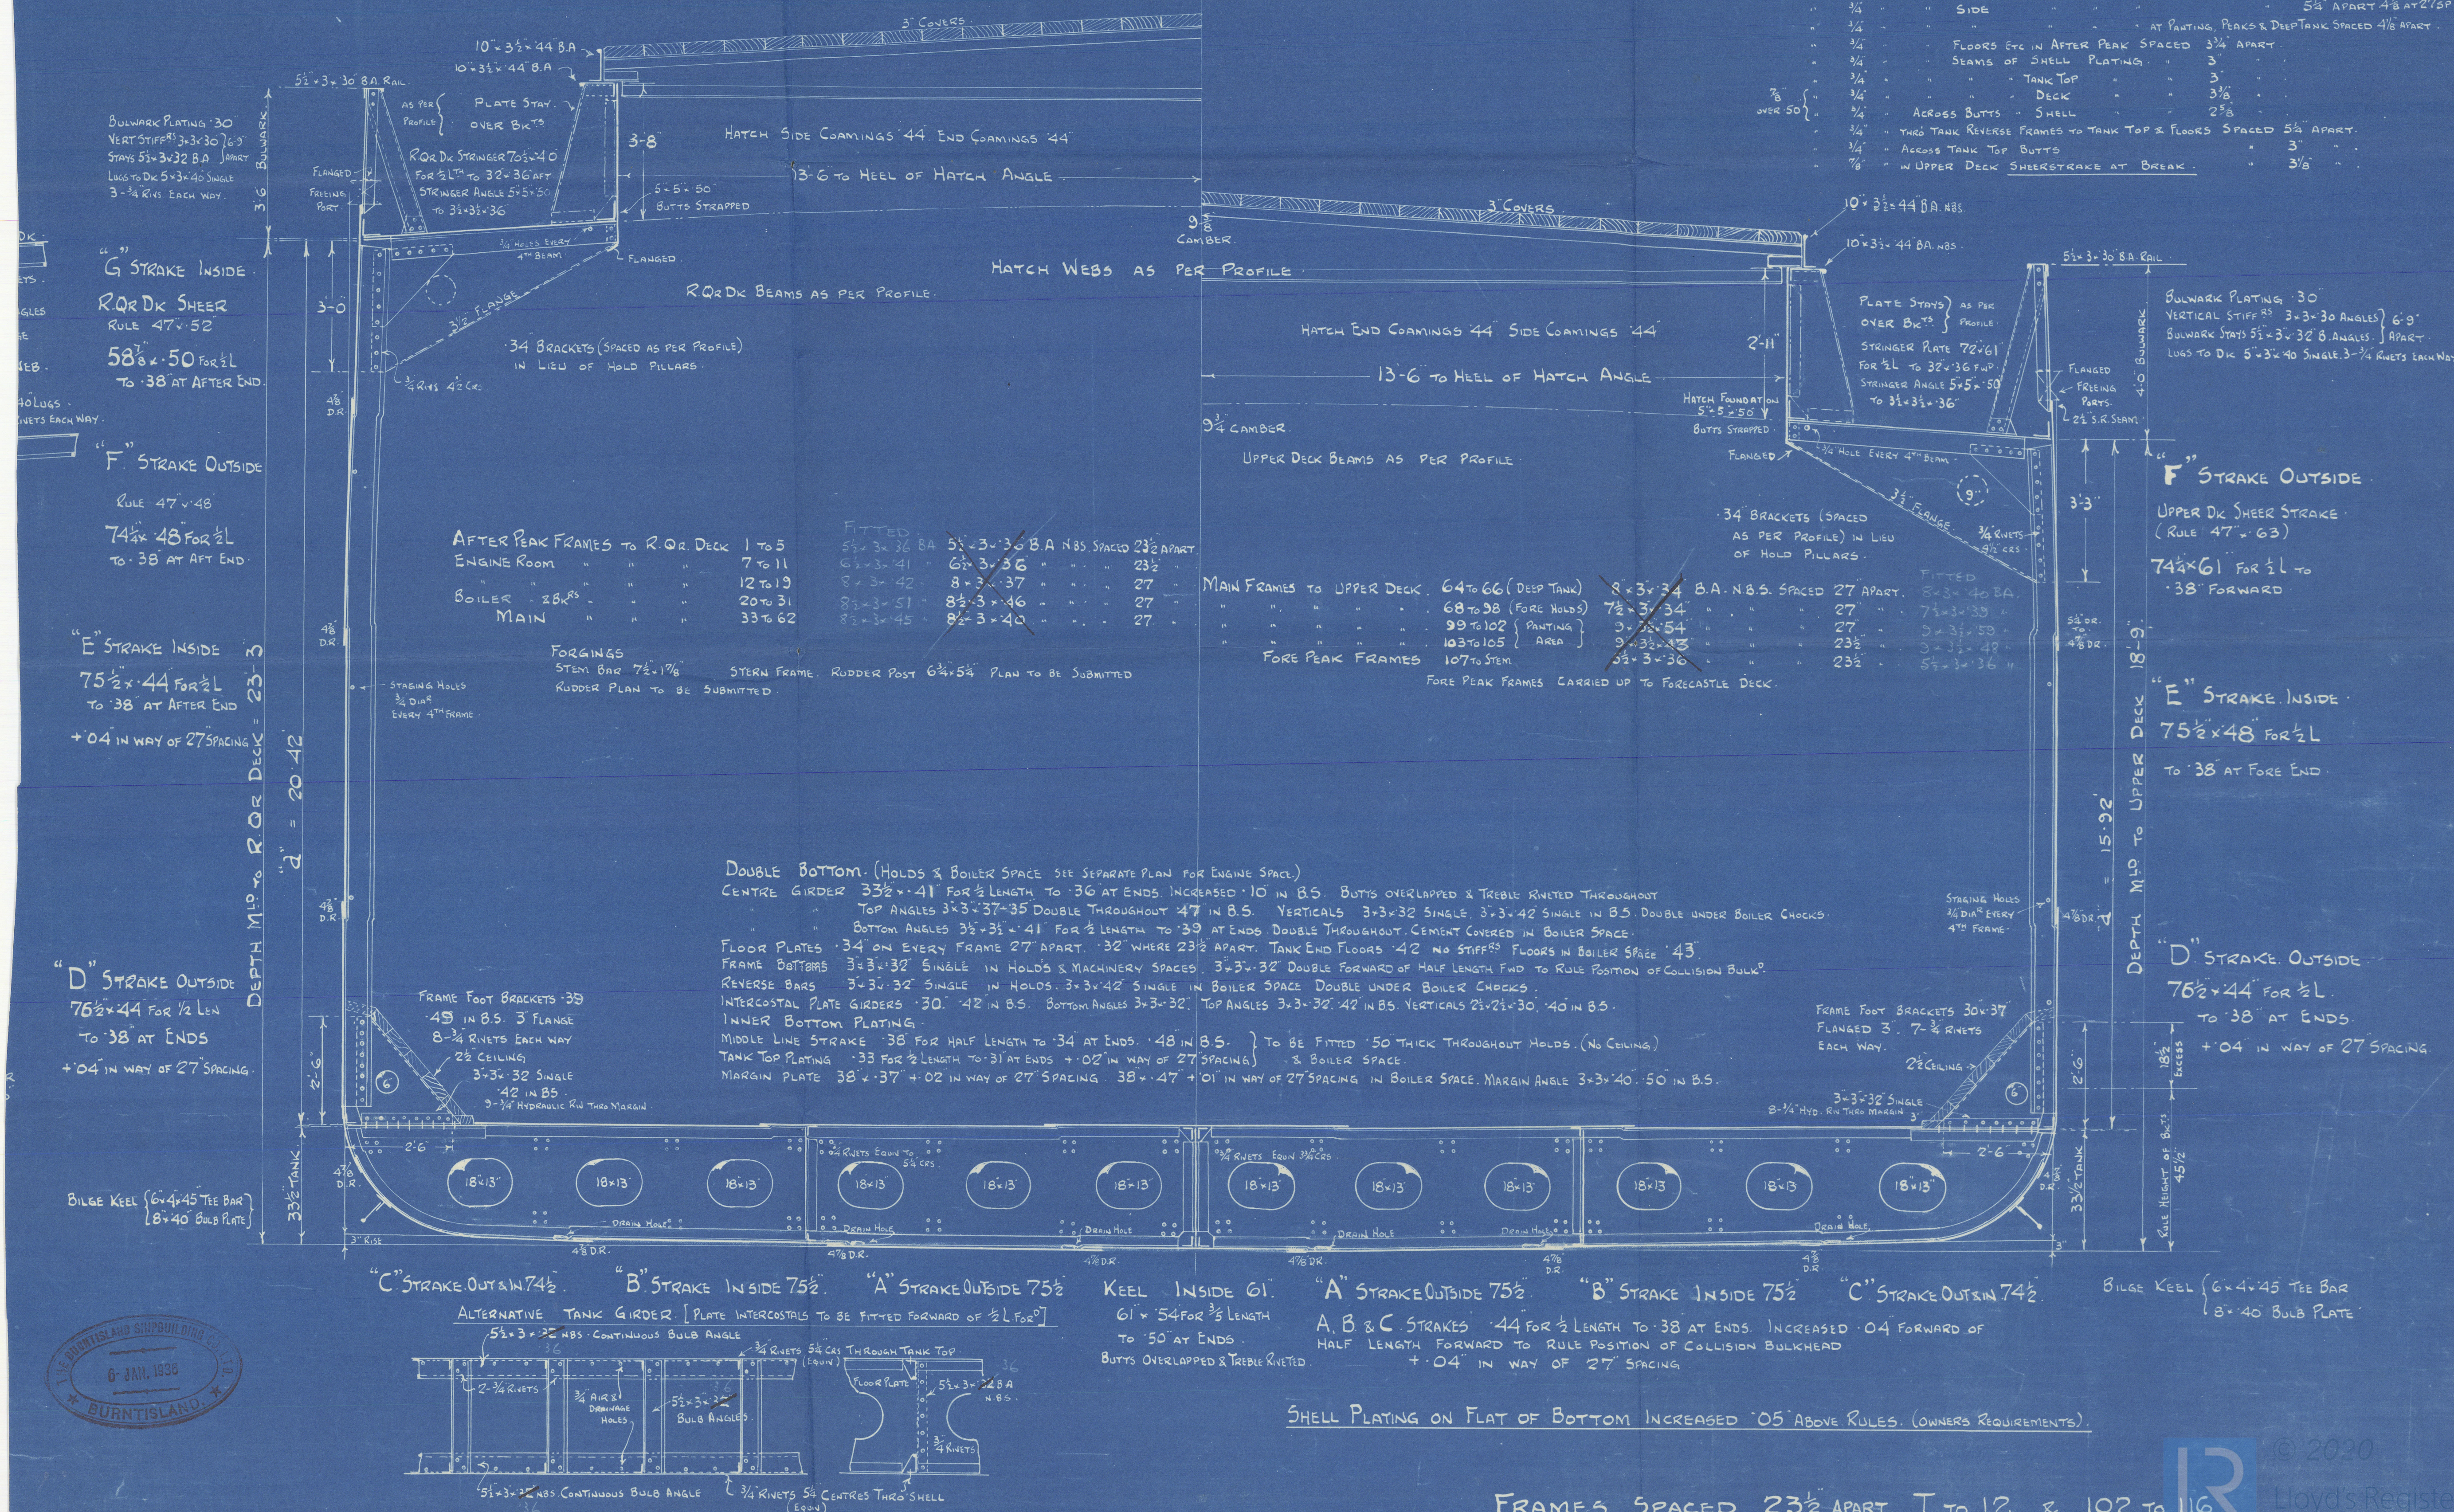



Burntisland SBC<sup>o</sup>LE

N<sup>o</sup> 191

Middle Section, Mowing  
Vend as built

'CORBRAE'



© 2020

Lloyd's Register  
Foundation

004703-004709-0202