


Lloyd's Register of Shipping.

Ship's Name *S/S. "WAVE. SOVEREIGN"*
FURNESSE S.B. CO. LTD YARD N^o 364.

Official No. 180813.
REPORT N^o MIDDLESBROUGH 17976.

Memorandum of alterations reported since ship was surveyed for assignment of Load Lines
in WHILE BUILDING AT MIDDLESBROUGH.

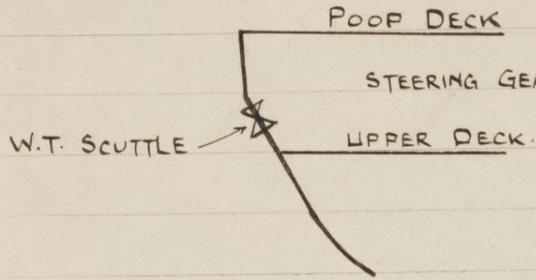

21" DIA. W.T. SCUTTLE IN STERN
ABOUT 42'-0" ABOVE BASE
STEEL COVER .38", SECURED BY
SCREW DOWN TOGGLES, MANIPULATED
FROM INSIDE VESSEL.

W

H.C. Young.

*Red. & transfered
by
JBD.
14/3/46.*

