

HULL. 56705.

28 JUL 1950

Rpt. C. 11 (Contd.)

Index No.

36689


Lloyd's Register of Shipping.

Ship's Name "CAPE ST. DAVID".

Official No. 168933

Memorandum of alterations reported since ship was surveyed for assignment of Load Lines in

Two 18" ventilators (1P, 1S) fitted at bridge front to hold and tween deck, coaming plates 4'-0" high x 7/16" plate. Doubling plates approx. 5'-0" x 2'-0" x 5/8" fitted in way. Tween deck tube to hold 15" diameter x 5/16".

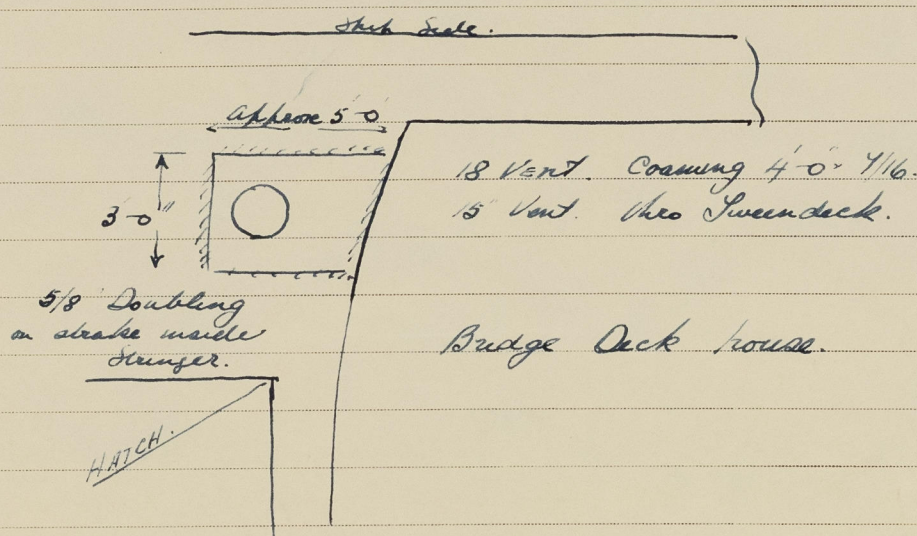


Thos. L. Dixon

SURVEYOR TO LLOYD'S REGISTER
OF SHIPPING.

7.7.50.

COPY PLACED ON BOARD.

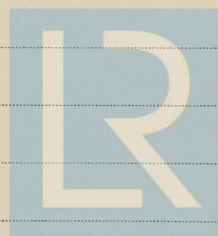

© 2020

Lloyd's Register
Foundation