


ARSENAL II
BUILT-UP STERNFRAME & RUDDER.


SCALE: 1:15.

*Not finished Mod. with Tachometer
Adjustment in hull*

FOR ALL OTHER DIMENSIONS SEE
DRAWING NO 16224.

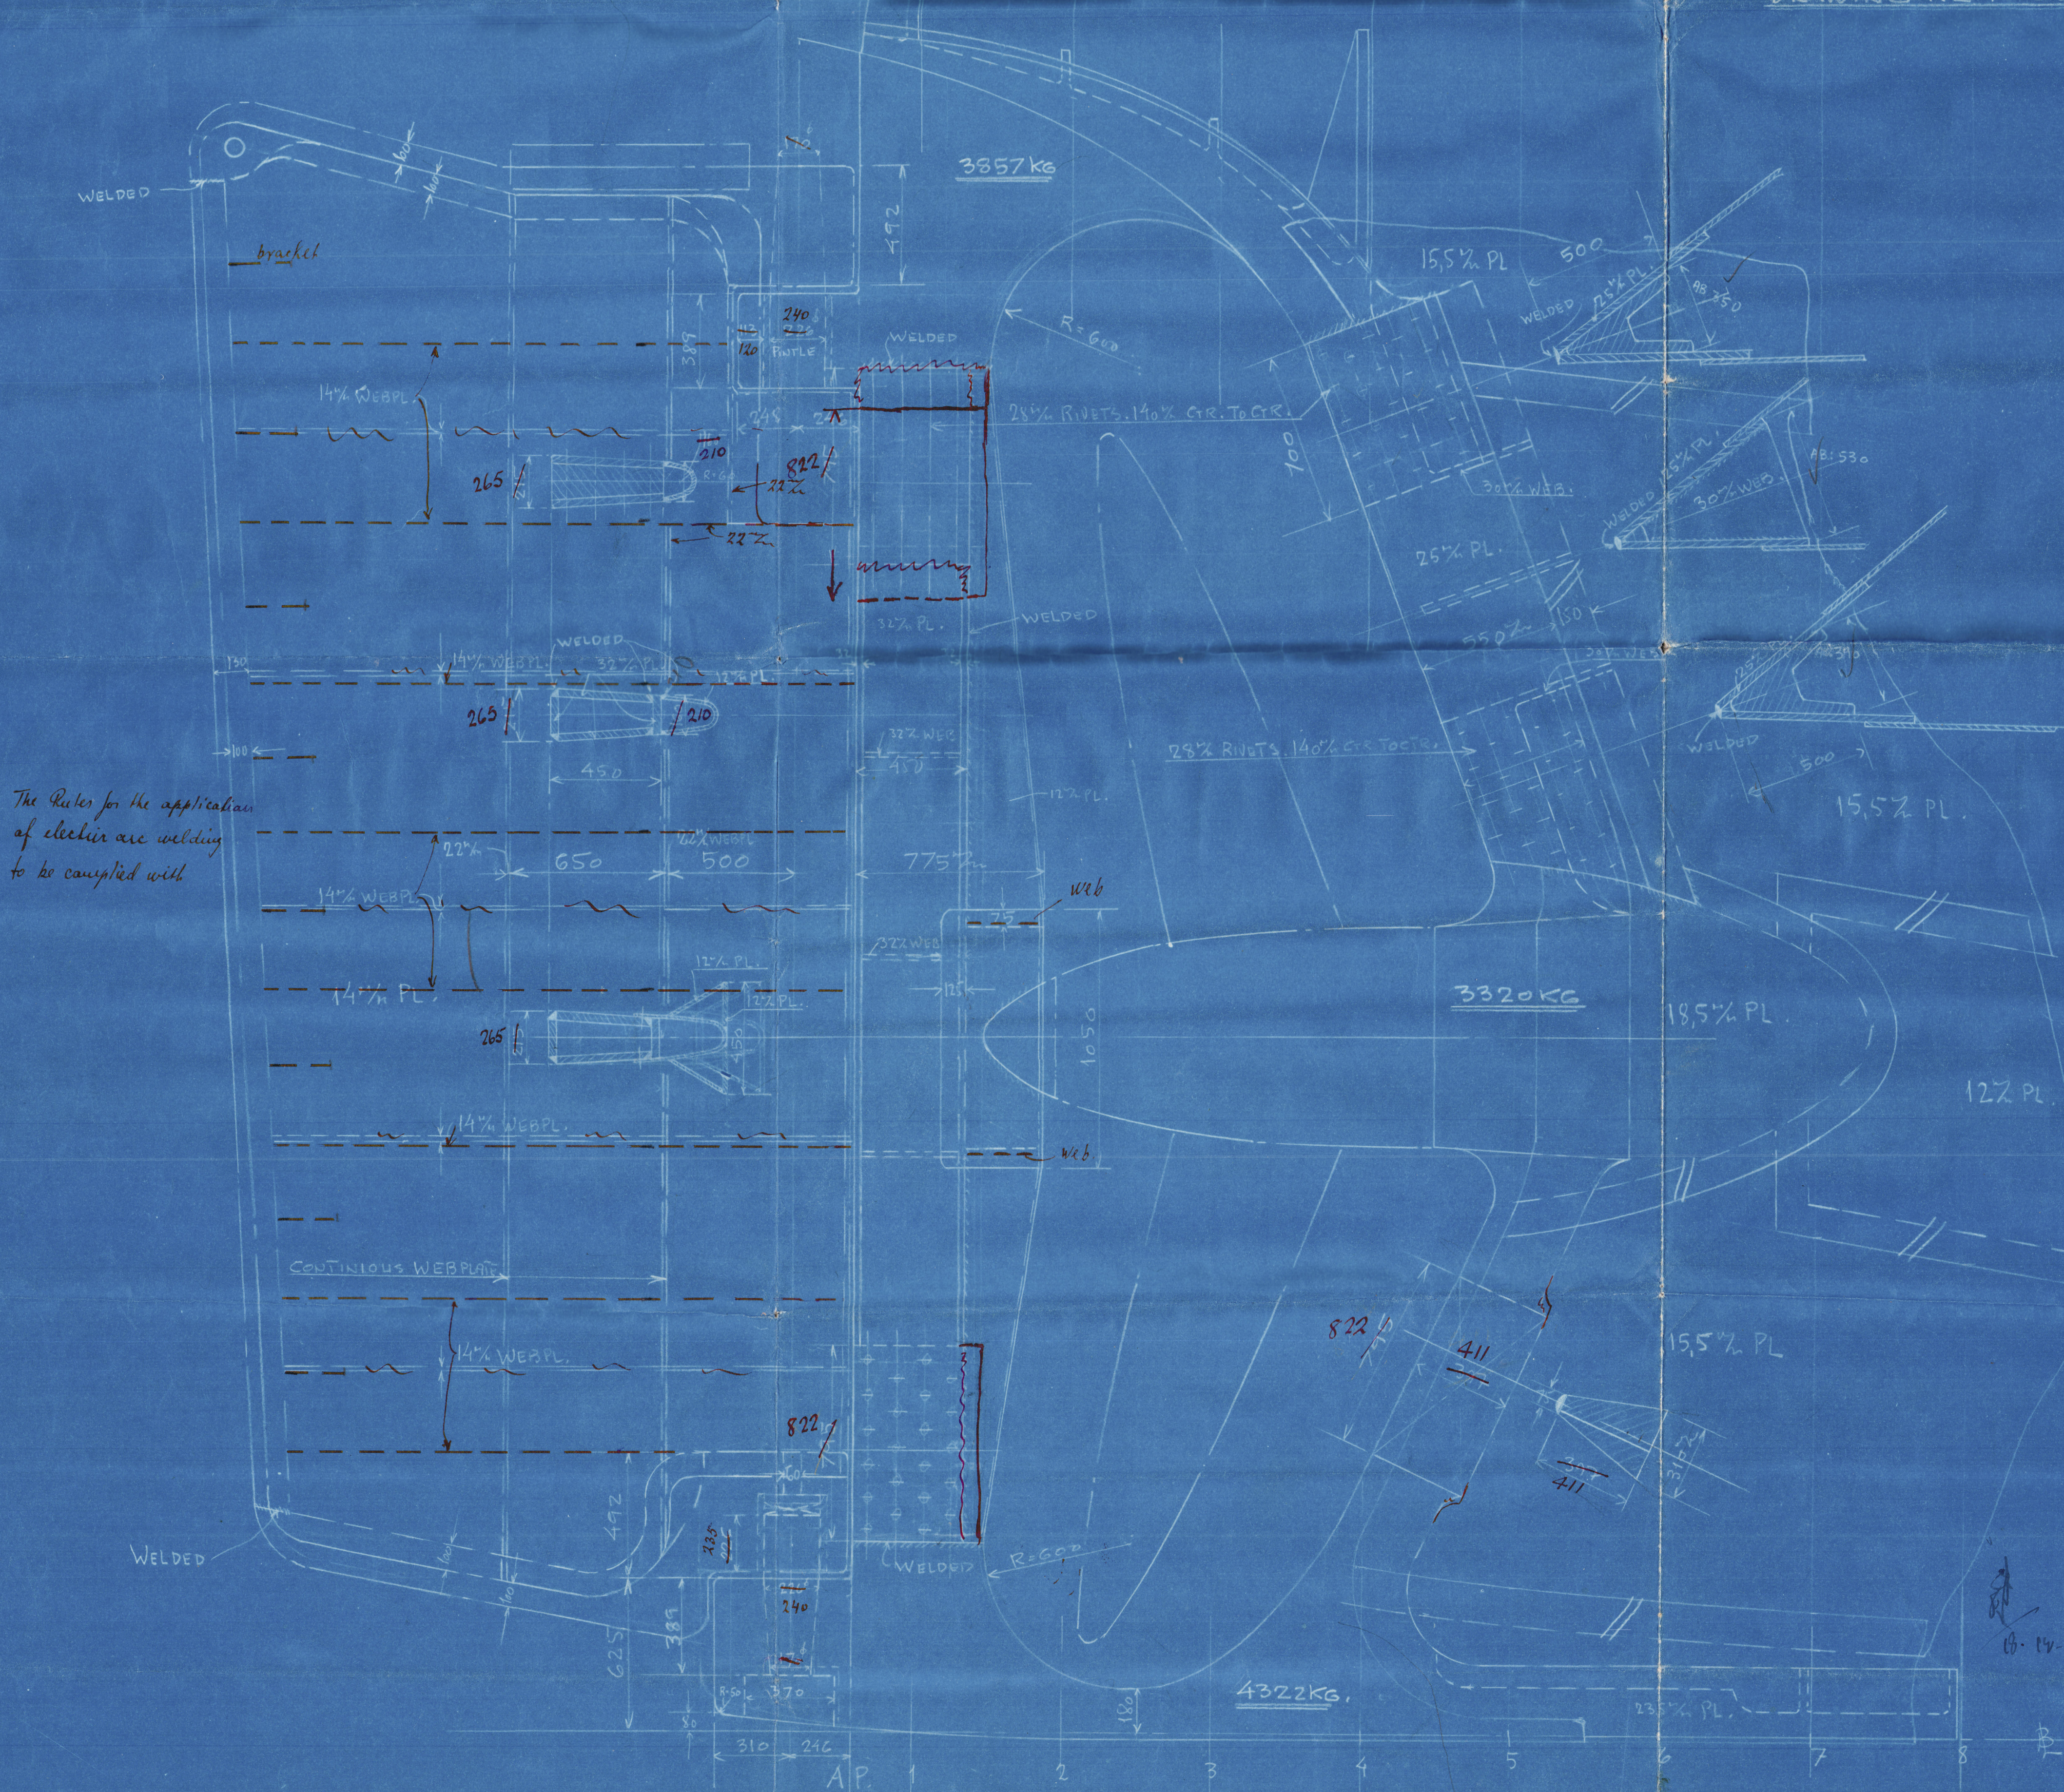

Provisionally approved at Copenhagen.
Subject to final approval of the Committee

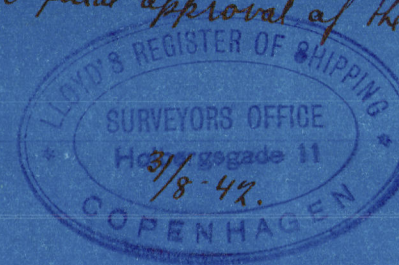

ARSENAL DO ALFENITE
YARD N° C. 15

AKTIESELSKABET
BOHRMEISTER & WAIN
MASKIN- & SKIBBYGGERI
ENTRANCE NO. ARSENAL II
TECHNICAL NO. 16264
TITLE OF DRAWING
DATE 28-8-42
SCALE 1:15
BUILT-UP
STERNFRAME

24

"SAMEIRO" ★



C. 15

Arsenal do Alfeite

Built up Sternframe
& Rudder

© 2020
Lloyd's Register
Foundation