


22 No 315

# PROFILE & DECK


Scale 1/4" = One foot — TO CLASS B.S. \*

Dimensions 250' x 37' x 18'-3" mld

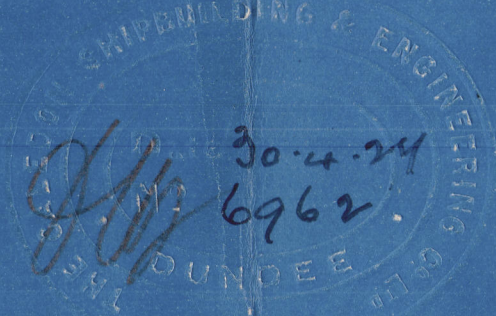

2 MAY 1927

6.5.27

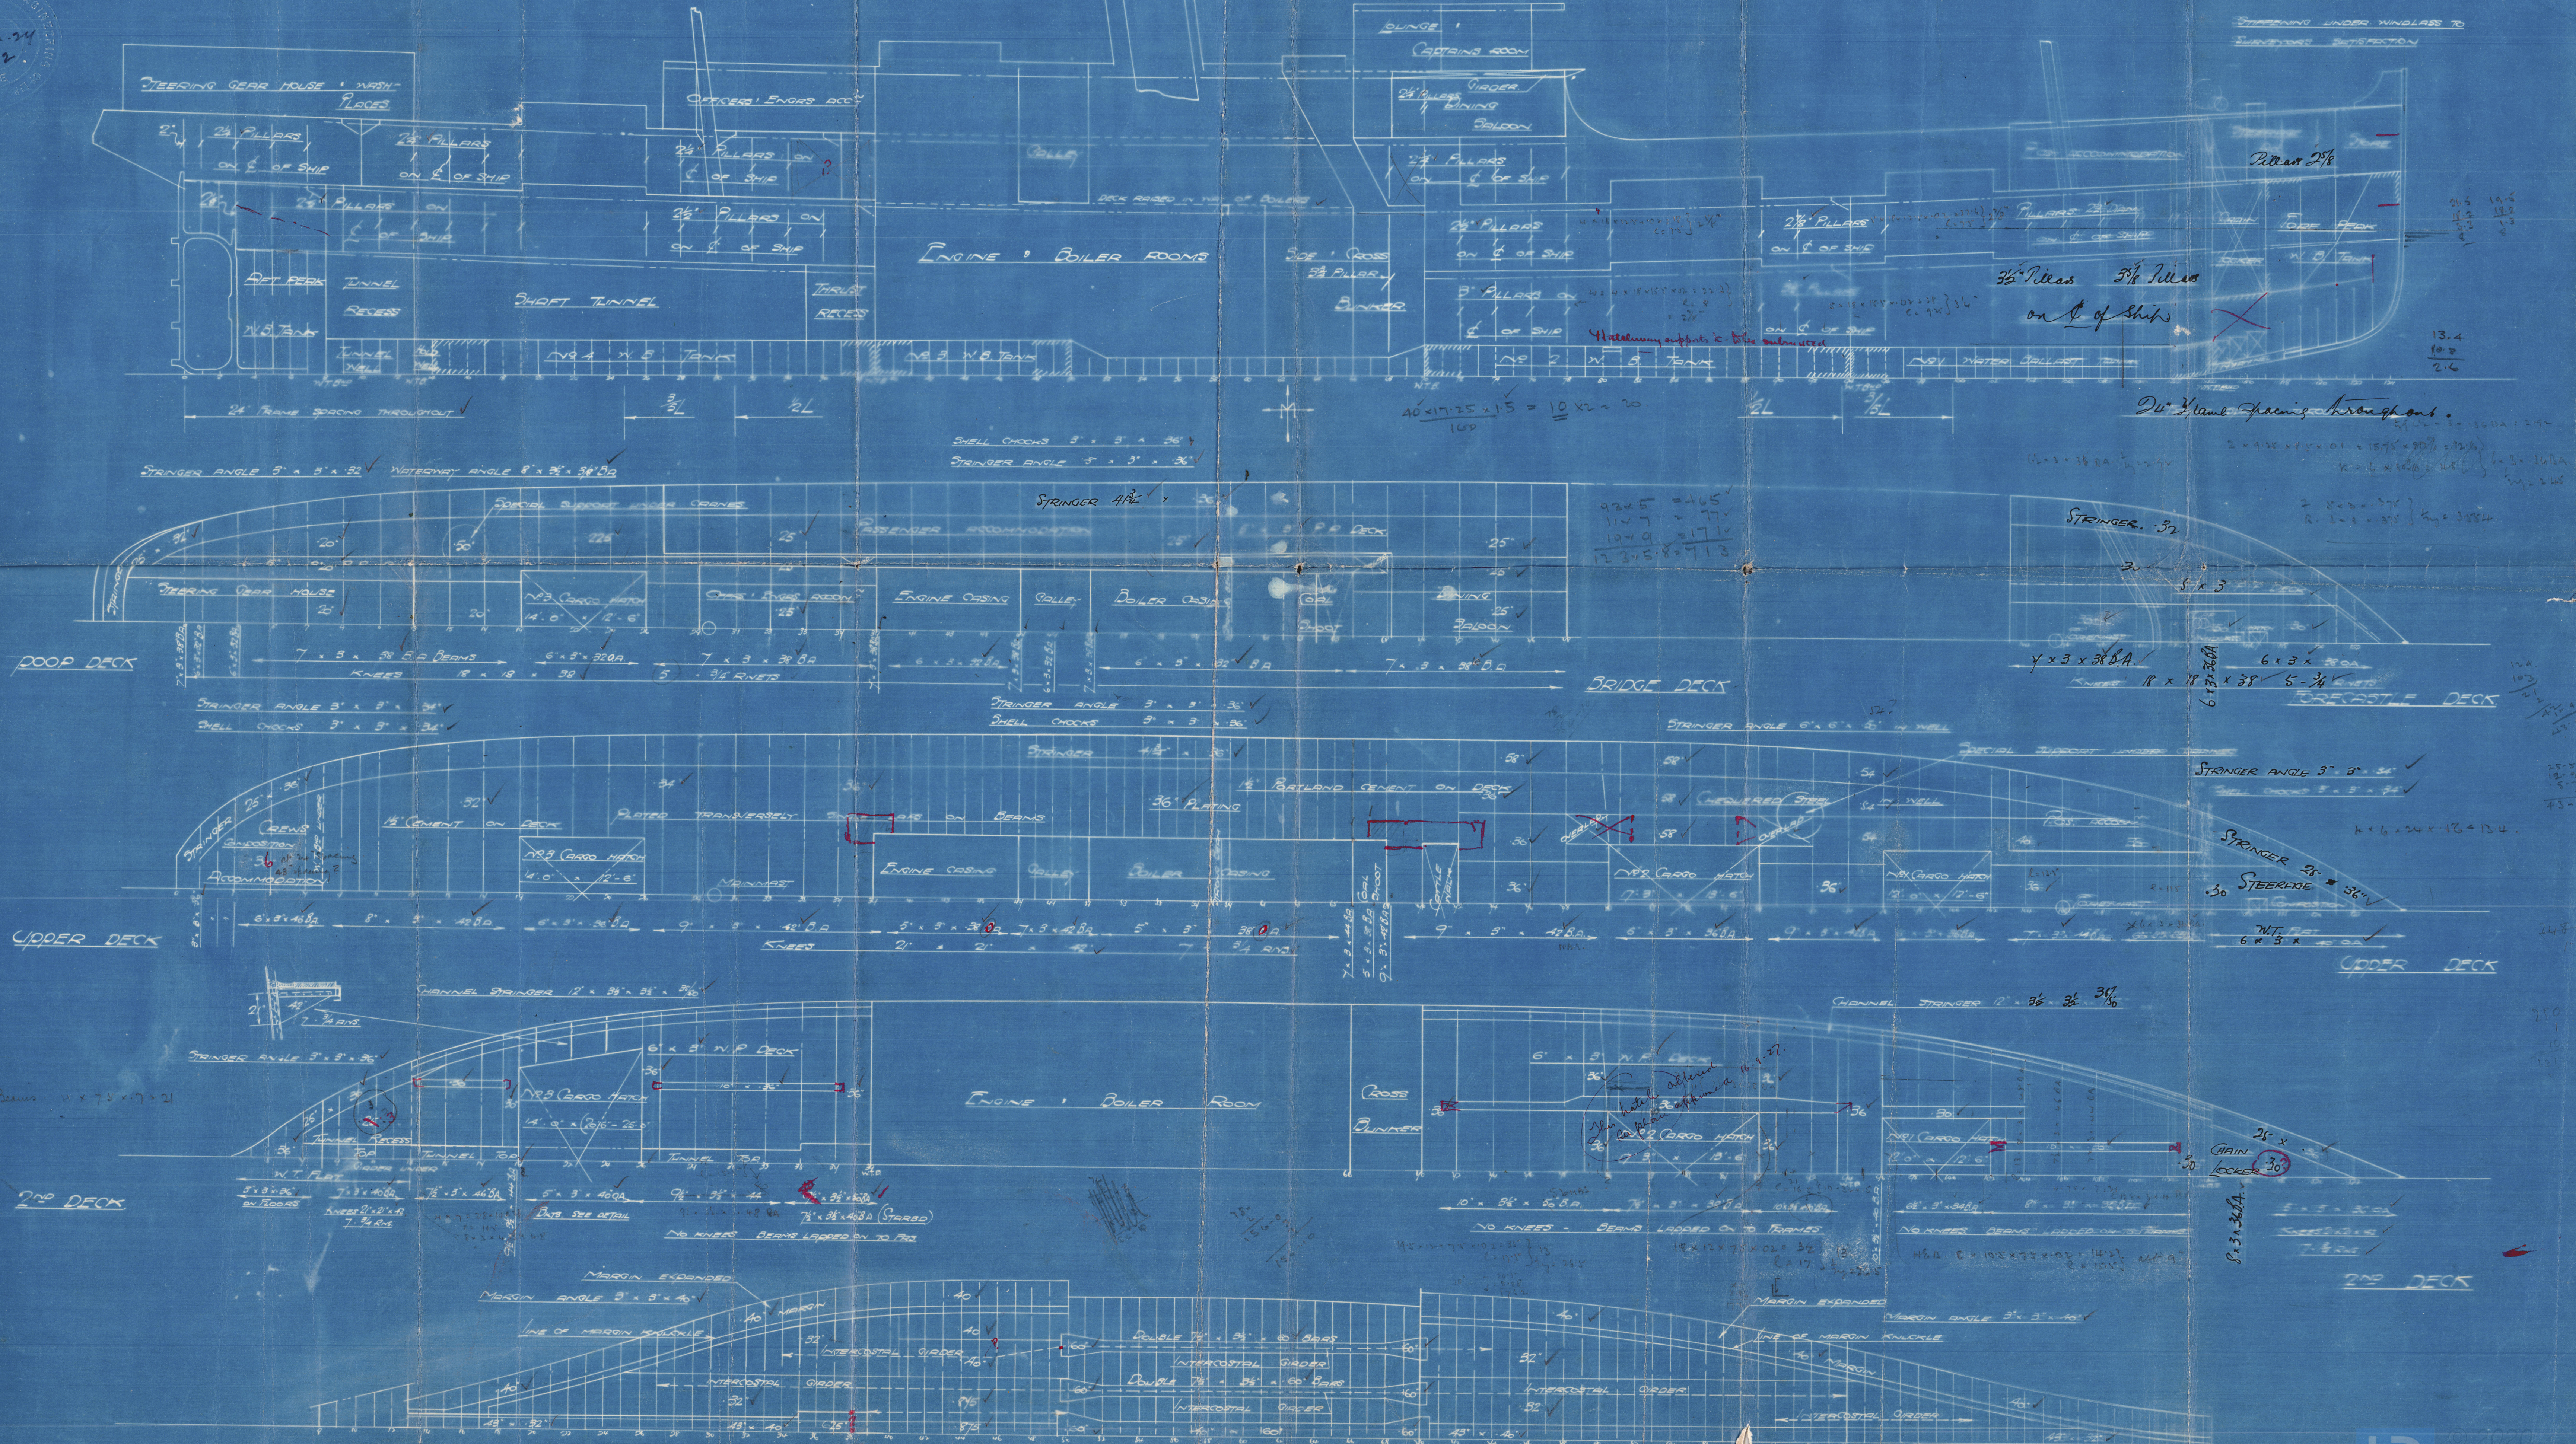

TANK TOP



3

Profile & Deck

Caledon S. B. Co.

315

10 "5" 27.

Grey point

Ex  
1/8. "Castnet"

T. C. 18 - 5 - 27.



© 2020

Lloyd's Register  
Foundation

004718-004726-0243