

/NK

LLOYD'S REGISTER OF SHIPPING

ALTERATIONS TO CONDITIONS OF ASSIGNMENT OF LOADLINES

Ship's Name "ESSO WANDSWORTH"

Official No. 187594


Port of Registry London

This ship has been under survey at South Shields

on July 1959 and the following alterations to the conditions of assignment of loadlines have now been effected/found:—

Effected Steel O.T. bulkheads fitted P & S on frame 41 forming 1 additional wing tank p & s. frs. 41-54 for the carriage of cargo oil 25½ x 19½" access manholes cut in freeboard deck closed by steel O.T. covers with 6 toggles. Air pipe for No.4 wing tank repositioned and stayed to Poop Front. New 2½" S.P. with screwed cap stayed to poop front. Gas relief pipe fitted to No.4 wing tank coaming.

Found. Nos. 2 & 3 wing tanks converted from cargo oil to water ballast, cargo oil lines blanked off 2 - 4" air pipes fitted to each tank, openings 7'6" above freeboard deck efficiently stayed to trunk, closed by wood plugs and canvas covers.

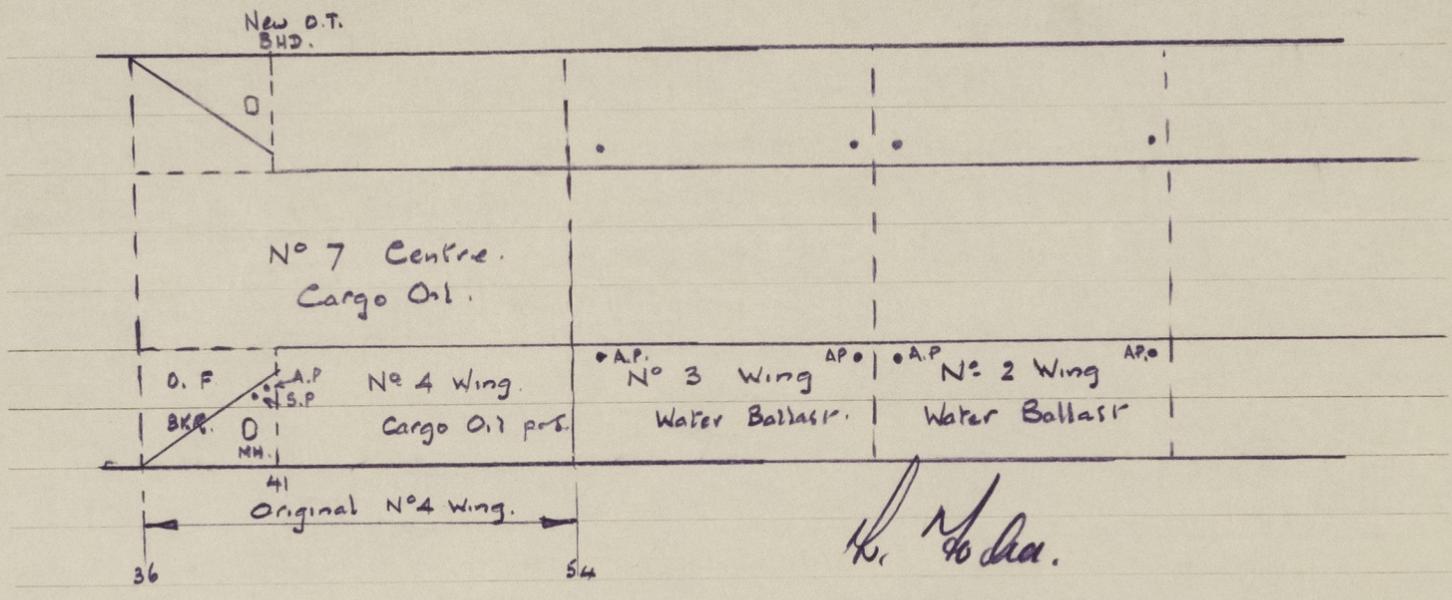

L. TODD.

SURVEYOR TO LLOYDS REGISTER OF SHIPPING.

A copy of this Report has been placed on board.



© 2020

Lloyd's Register Foundation

004727 - 004735 - 0095

Noted
AMB
13/8/59